


Lloyd's Register of Shipping.

Ship's Name M.V. "REGISTAN" (NOW NAMED "TRESILLIAN") Official No. 180022.

Memorandum of ^{AMENDMENTS} ~~alterations reported~~ since ship was surveyed for assignment of Load Lines in DURING CONSTRUCTION.

CLOSING APPLIANCES OF F'LE FRONT:- 2 TONNAGE OPENINGS CLOSED BY STORM BOARDS IN RIVETED CHANNELS & 4 STEEL HINGED DOORS CLOSED FROM ONE SIDE ONLY.

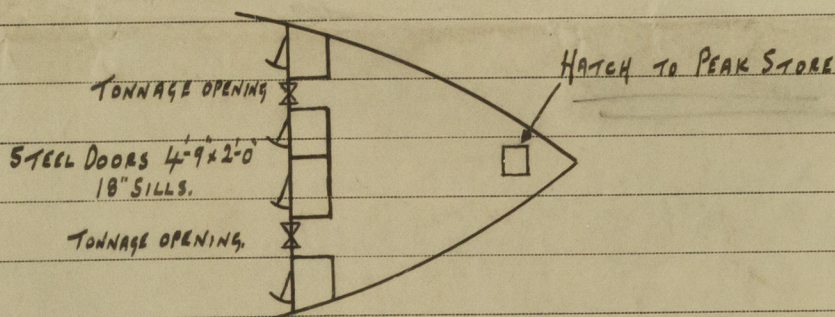

HATCHES:- HATCH IN F'LE SPACE TO FORE PK STORE IS CLOSED BY 2 1/2" WOOD COVERS & FITTED WITH CLEATS, BATTENS & 1 TARPULIN & NOT BY W.T. STEEL COVER. ✓

HATCH 2'-6" x 2'-6" ON F^B DECK (STARBOARD SIDE) AT FORE END OF CREWS DECKHOUSE AFT TO AMMUNITION LOCKER IN TWEEN DK NOW A STORE FITTED WITH 8" x 36" COAMING, CLOSED BY W.T. STEEL COVER SECURED BY TOGGLES. ✓

VENTILATORS:- IN ADDITION TO VENTILATORS STATED IN F^B REPORT, FOUND THE FOLLOWING FITTED:-

- 1 VENT 12" DIA, COAMING 36" x 34" ON F'LE DK TO FORE PEAK STORE ✓
- 2 " 34" DIA, " 21" x 40" ON TOP OF STEEL MAST HOUSE ON F^B DK BETWEEN N^os 1 & 2 HATCHES TO HOLDS & T DKS. ✓
- 2 " 24" DIA, " 21" x 40" ABOVE TOP OF DERRICK TABLE ON F^B DK BETWEEN N^os 2 & 3 HATCHES TO HOLDS & T DKS ✓
- 4 " 12" DIA COAMING 36" x 34" ON F^B DK TO DEEP TANK. ✓
- 2 " 34" DIA " 21" x 40" ON TOP OF STEEL MAST HOUSE ON F^B DK BETWEEN N^os 4 & 5 HATCHES TO HOLDS & T DKS. ✓
- 1 " 8" DIA, " 33" x 30" ON F^B DECK AT FORE END OF CREWS DECKHOUSE TO STORE ROOM.
- 1 " 6" DIA " 35" x 30" ON F^B DECK TO LOWER STORE AT STERN.
- 1 " 12" DIA " 33" x 34" ON F^B DECK TO CREWS ACCOMMODATION
- 1 " 10" DIA " 35" x 32" ON F^B DECK TO TWEEN DKS AFT.
- 2 " 10" DIA " 21" x 32" ON TOP OF CREWS DECKHOUSE TO TWEEN DK ACCOMMODATION. ✓

ALL THE ABOVE VENTILATORS CLOSED BY WOOD PLUGS & CANVAS COVERS. ✓

- 1 VENT 8" DIA COAMING 33" x 30" ON F^B DECK AT FORE END OF CREWS DECKHOUSE TO STORE ROOM. FITTED WITH STEEL HOOD.
- 2 " 10" DIA COAMING 21" x 32" ON TOP OF BOAT DK TO ACCOMMODATION IN TWEEN DKS ON PORT SIDE OF CASINGS CLOSED BY WOOD PLUGS & CANVAS COVERS. ✓

W. J. Fyle

980
35/4/46