





PARTICULARS OF PROTECTION TO OPENIN

HATCHWAYS ON FREEBOARD AND SUPERSTRUCTURE DECKS									
SHELTER DECK				FREEBOARD DECK		BUNKER HATCH ON DECKING			
Description of Hatchway ... ..				Nº 1	Nº 2	Nº 1	Nº 2	PUNKED.	TONNAGE
Dimensions of Hatchway ... ..				28-1 1/2 x 17-0	30-0 x 17-0	31-10 1/2 x 17-0	32-9 x 17-0	3-5 x 10-8	4-0 x 17-0
COAMINGS	{	Height above Deck ...	...	30"	30"	18"	18"	50"	12"
		Thickness { Sides	...	1/4"	1/4"	1/4"	1/4"	1/4"	1/4"
			Ends	...	1/4"	1/4"	1/4"	1/4"	1/4"
		Stiffeners ...	...	7 x 2 1/2 x 50 A	A3 Nº 1	/	/	VERT STIFFS 5 x 3 x 40	/
Brackets, Stays ...				2 @ 2 1/2 DIA		/	/	21" APART	
HATCH BEAMS	{	Number ...	...	5	4	6	6	/	/
		Spacing ...	...	4-7	6-0	4-6	4-6	/	/
		Scantling and Sketch	...	H. 18 x 6 x 6 x 50	H. 18 x 6 x 6 x 50	H. 16 x 6 x 6 x 50	H. 16 x 6 x 6 x 50	/	/
				I	A3 Nº 1	I	A3 Nº 1	/	/
Bearing Surface ...				3"	3"	/	/	/	/
FORE AND AFTERS	{	Number ...	...	/	/	/	/	/	/
		Spacing ...	...	/	/	/	/	/	/
		Unsupported Lengths	...	/	/	/	/	/	/
		Scantling* and Sketch	...	/	/	/	/	/	/
Bearing Surface ...				/	/	/	/	/	/
HATCH COVERS	{	Material ...	...	PINA	PINA	PINA	PINA	PINA	PINA
		Thickness ...	...	2 1/2	2 1/2	2 1/2	2 1/2	2 1/2	2 1/2
		How fitted	...	F 9 A	F 9 A	F 9 A	F 9 A	F 9 A	F 9 A
		Bearing Surface	...	3"	3"	3"	3"	3"	3"
Spacing of Cleats ...				26"	26"	24"	24"	24"	24"
Number of Tarpaulins ...				3	3	one	one	2	2

- Are wood fore and afters steel shod at all bearing surfaces ?
- Are battens and wedges efficient and in good condition ?
- Are tarpaulins in good condition and in accordance with rule requirements ?
- Are lashings provided in accordance with rule requirements ?

Particulars of fiddle, funnel and ventilator coamings:—  
 Stokeshold gratings covered by strong steel hinged covers. Fiddle and vents in efficient condition.  
 Engine room skylight of steel strongly constructed. ✓

Particulars of Flush Bunker Scuttles:—

Particulars of Companionways:—

	Breasted companionway	7-8' x 3-0' x 6-10' high	on shelter deck off to accommodation door of tank with 13" sill	
"	"	"	" " "	13½"
"	"	2-0' x 2-0' x 6-10'	against G.R. beam to sheltered door of steel	12"

Particulars of Ventilators in exposed positions on freeboard and superstructure decks :—

Particulars of	Ventilators in Exposed Positions	Remarks
On 2 better Seal:		
2 Vents	11" dia corrug	36" x 34" ✓
" 2 "	14" "	43" x 34" ✓
" 3 "	6" "	30" x 34" ✓
" 10 "	9" "	32" x 34" ✓
		7 Patient Vents 4" x 16" x 36" high -
		2 " " 12" x 4" x 36" " -
		2 Goose Neck " 8" x 4" x 24" " -
		100 0 1. P-14

Particulars of Air Pipes in exposed positions on freeboard, raised quarter, or superstructure decks — *See Section 18 "Height X 4"*

Particulars of Air Pipes in exposed positions on freeboard, raised quarter, or superstructure							
1	8.5	air pipe on Shellie Deck	24" high x 1 1/2" dia -	2	8.5	air pipe on Shellie Deck	18" high x 1 1/2" dia -
2	2	"	21" " x 3" "	2	2	"	18" " x 2" "
2	1	"	22" " x 2 1/2" "	2	2	"	28" " x 2 1/2" "
2	1	"	30" " x 2" "	1	1	"	28" " x 3" "
1	1	"	16" " x 2 1/2" "				
1	1	"	18" " x 1 1/2" "				

*Efficient closing appliances, 1*  
*No. 1, 2, 732*

Particulars of Gangway Cargo and Coaling Ports:—

Particulars of Scuppers and Sanitar

Particulars of Side Scuttles:—

Particulars of Side Scuttles:—  
Side scuttle in accommodation spaces in Shelter Deck Space not fitted with deadlight.

Particulars of Guard Rails:— On Shelter Deck all around except for length of 22.5' from stem and for length of 19.0 in way of foremast where bulwarks are fitted.  
Guard rails 26" high 2 rails stanchions spaced 4.0' apart.

Particulars of Gangways, Lifelines, etc.:— *None fitted*

## Particulars of Freeing Arrangements.

	Length of Bulwark	Height of Bulwark	Size of Freeing Ports	Number each side	Area each side	Rule area each side
After Well ... TONNAGE SPACE			3'-0" X 20"	1	4.0824 <i>sq ft</i>	
Forward Well ...						

State position of each freeing port ... .. } After Well:—  
and A. position and height above deck edge } Forward Well:— 10" above deck  
State whether the freeing ports are fitted with shutters, bars, or rails, and give particulars of such:—  
Additional area where sheer is less than standard.

## Particulars of Superstructures, Trunks, Casings, Deckhouses.

	Coaming	Plating	Stiffeners	Spacing	End Attachments of Stiffeners	Size of Openings	Height of Sills	Height of Casings
oop Bulkhead ... ..	32	32	PANELLING IN WAY	27"	3 rivs top & 4 bottom	None	✓	7-0"
Raised Quarter Deck Bulkhead ...	✓							
ridge, After Bulkhead ... ..	✓							
ridge, Forward Bulkhead ... ..	✓							
orecastle Bulkhead ... ..	32	32	Planned 1/2" x 3/2"	36"	None	2 @ 48" x 37"	24"	7-0"
runk, Aft ... ..	✓							
runk, Forward ... ..	✓							
xposed Machinery Casings on Free-board or Raised Quarter Decks ...	✓							
xposed Machinery Casings on Super-structure Decks ... ..	40	40	3 1/2" x 3" x 3/8"	33"	None	1 @ 5-3" x 18" 2 @ 23" x 25"	12" 1 @ 12" 1 @ 9"	3-3"
achinery Casings within Superstruc-tures not fitted with Class I Closing Appliances ... ..	40	40	3 1/2" x 3" x 3/8"	33"	None	2 @ 4-8" x 24"	13"	6-10"
ckhouses on Flush Deck Ships ...	✓							


## Particulars of Closing Appliances (state if capable of being manipulated from both sides).

Item	Yes	No	Remarks
op Bulkhead ... ..	✓		no openings
ised Quarter Deck Bulkhead ...	✓		
dge, After Bulkhead ... ..	✓		
ge, Forward Bulkhead ... ..	✓		
castle Bulkhead ... ..			Wood shifting boards 2" with riveted channels full height.
osed Machinery Casings on Free- board or Raised Quarter Decks ...	✓		
osed Machinery Casings on Super- structure Decks ... ..			Steel doors operated from both sides.
achinery Casings within Superstruc- tures not fitted with Class I Closing appliances ... ..			Steel doors operated from both sides.
atches on Flush Deck Ships ...			



Kinsale now Cambrian Coast

Superstructure bulkheads, trunks, deckhouses, casings, cargo and coaling hatchways, extent and thickness of side plates, freeboard deck, gangway, cargo and coaling ports, and any other openings, etc., which would affect the seaworthiness of the ship are to be shewn on the following plan.

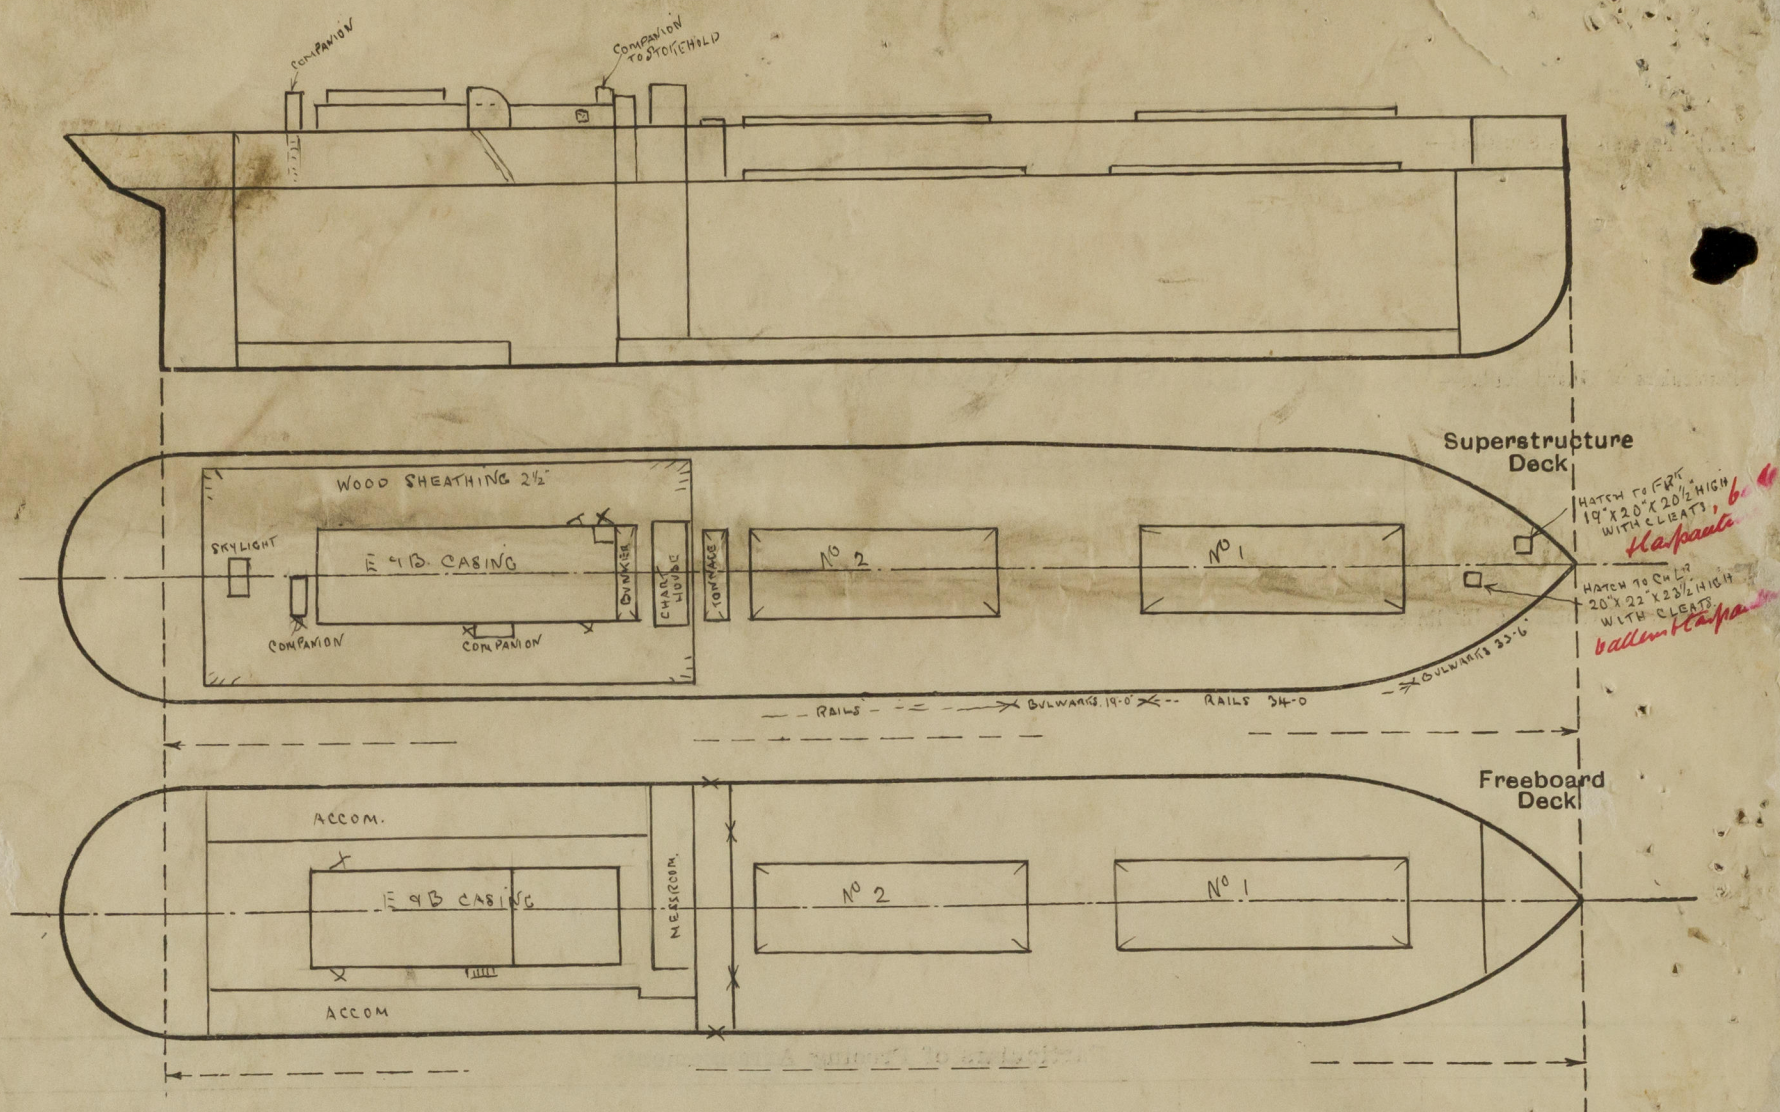

State any special features in the construction of the ship:—

Steel skylight on Shell Deck aft 4-0' x 3-9' x 12" high with hinged flap secured by quadrant only.

1906 subboards reassigned  
at Amersham Street & Telephone  
on the 22/6/32

OMIT

Builder's name and yard number HARLAND & WOLFF LTD

Names of sister ships REDBREAST?

Owners CITY OF CORK STEAM PACKET CO LTD

Fee £ 6 : 16 : 0 Received by me  
20/6/32



© 2020  
Lloyd's Register  
Foundation