


Lloyd's Register of Shipping.

Ship's Name "SAPPER"


Official No. 147391

Memorandum of alterations reported since ship was surveyed for assignment of Load Lines
in NOVEMBER, 1932.

The arrangement of the poop bulkhead is as shewn on the accompanying sketch. Two hinged steel doors to the wing stores are fitted in the bulkhead in addition to the tonnage opening on the centre line. (Mch. June/July/Aug., 1937).

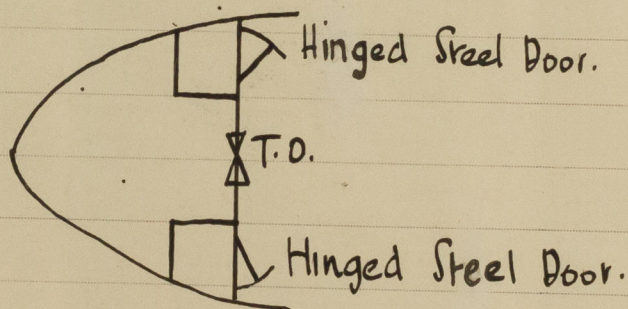

*Beats. amended
P.W.B.
29/11/37*

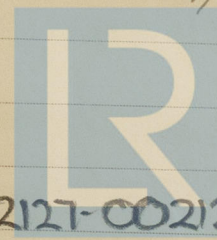

© 2020

Lloyd's Register
Foundation

002127-002137-0114