


SCHAAL 1: 10

100 A x D = 181.

SPEED NOT TO EXCEED 10 KNOTS

MATERIAAL: SMEEDSTAAL.

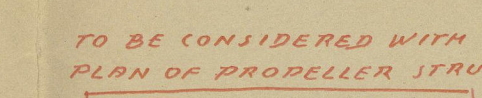



BOELE'S SCHEEPS WERVEN

No 862.

S/S "UPESI".

STERN FRAME & RUDDER.

3



© 2020

Lloyd's Register  
Foundation

002127-002137-0179