


SS IPSWICH TRADER.

25 SEP 1955

26 SEP 1955


L.A. per J.S.  
26/9/55

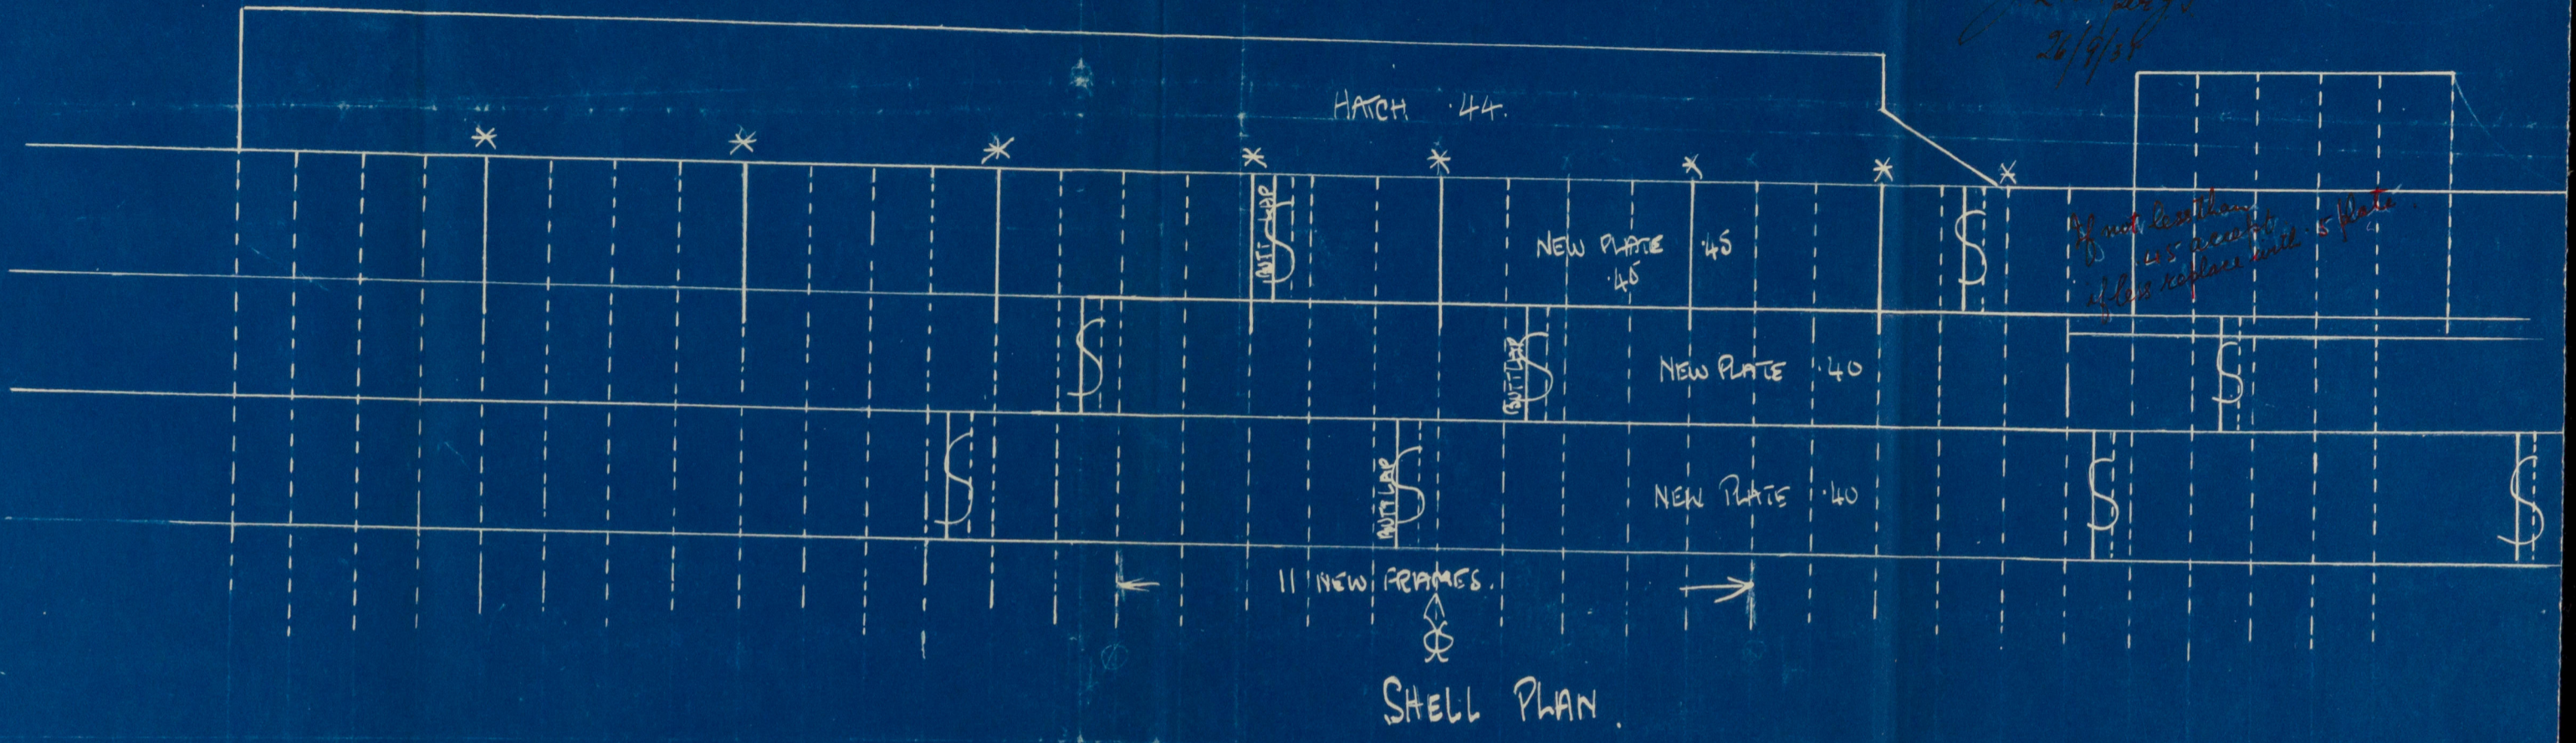

DEEP BRKT. SHOWN THUS \*

IPSWICH TRADER.

UNION IRON WORKS.

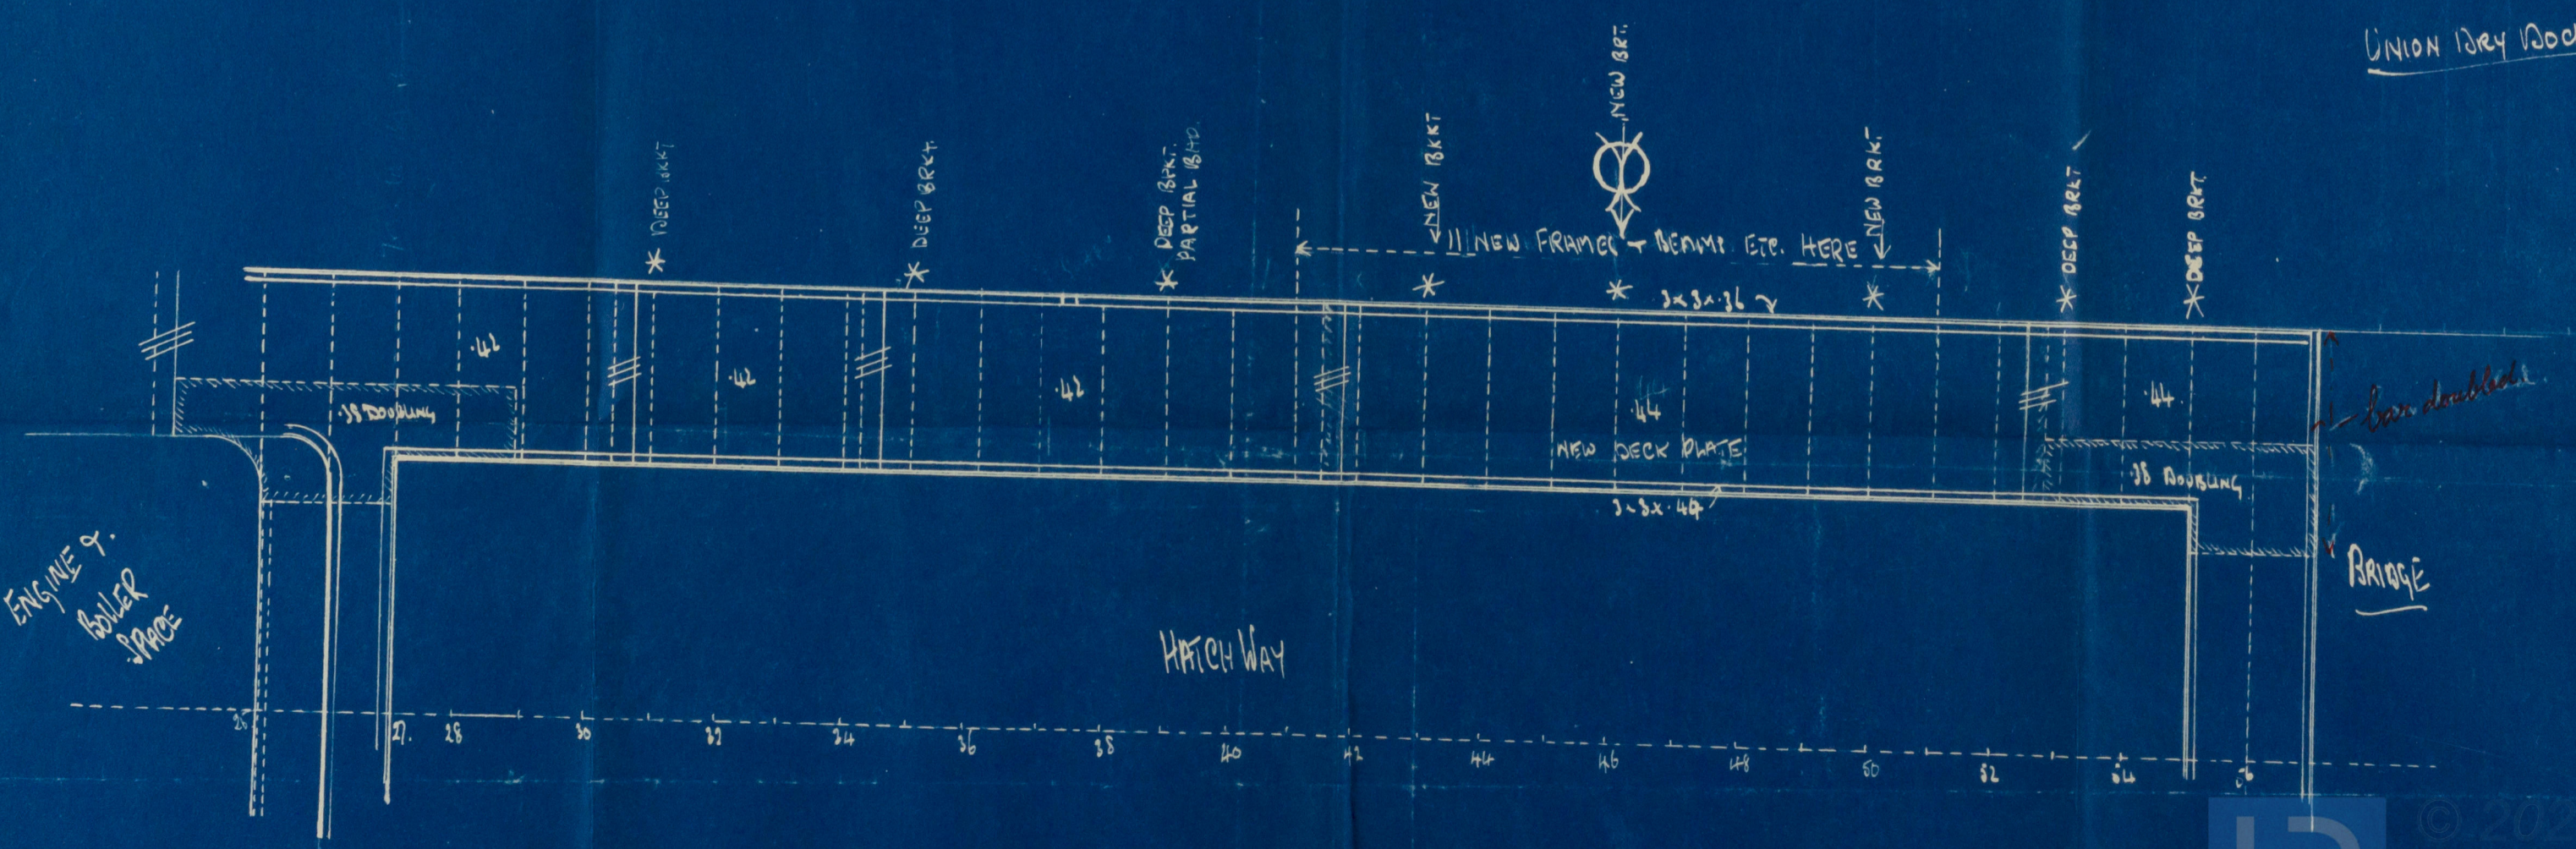

PLAN AT DECK SHEWING ALTERATIONS  
LENGTHENING 11 FRAMES.



© 2020 Lloyd's Register Foundation

00138-00/430 6075

TRANSFERRED TO:  
L. R. SYSTEM

Shell & Deck Altn. for Lengthening Ship.

VERONICA TENNANT

EX.  $\frac{5}{2}$  IPSWICH TRADER

Shull. 26.9.25.

TRANSFERRED TO:  
L. R. SYSTEM



© 2020

Lloyd's Register  
Foundation

002138-002150-0023