

17.10.10.  
22.11.10  
25.11.10.  
1.2.11





No 499

4. 8. 8 430'-0" x 55'-6" x 42'-6" to Promenade deck

To class 100 A.1. at Lloyd's

Scale  $\frac{1}{8}$ " = 1 foot

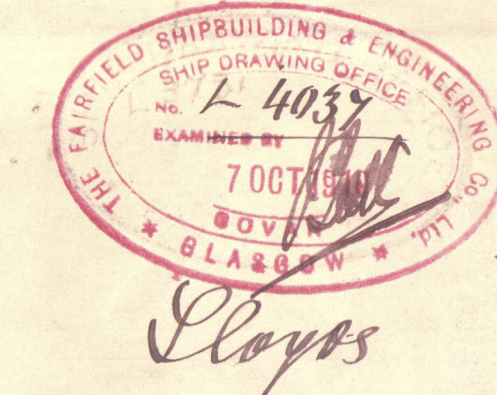 





N/N Cyrena

Fairfield S.B. & Co.

Pgs 4


Profile

(amended)

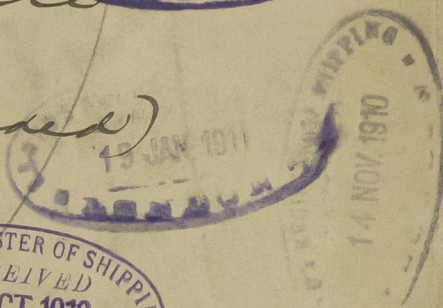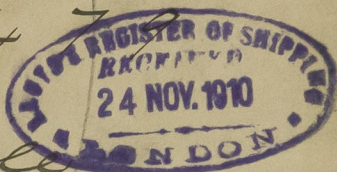

EX

"Mauryan"

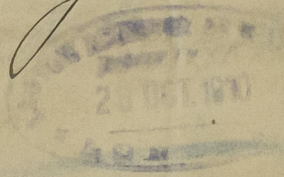

GLASGOW REPORT No. 30930



W.S 607



© 2020

Lloyd's Register  
Foundation

002151-002156-0001