


T.S.S. MAUNGANUI.
REPAIRS TO STARBOARD S.E. BOILER.

JUNE 1939.

also front bracket stay, Port SE Boiler
1938 Survey

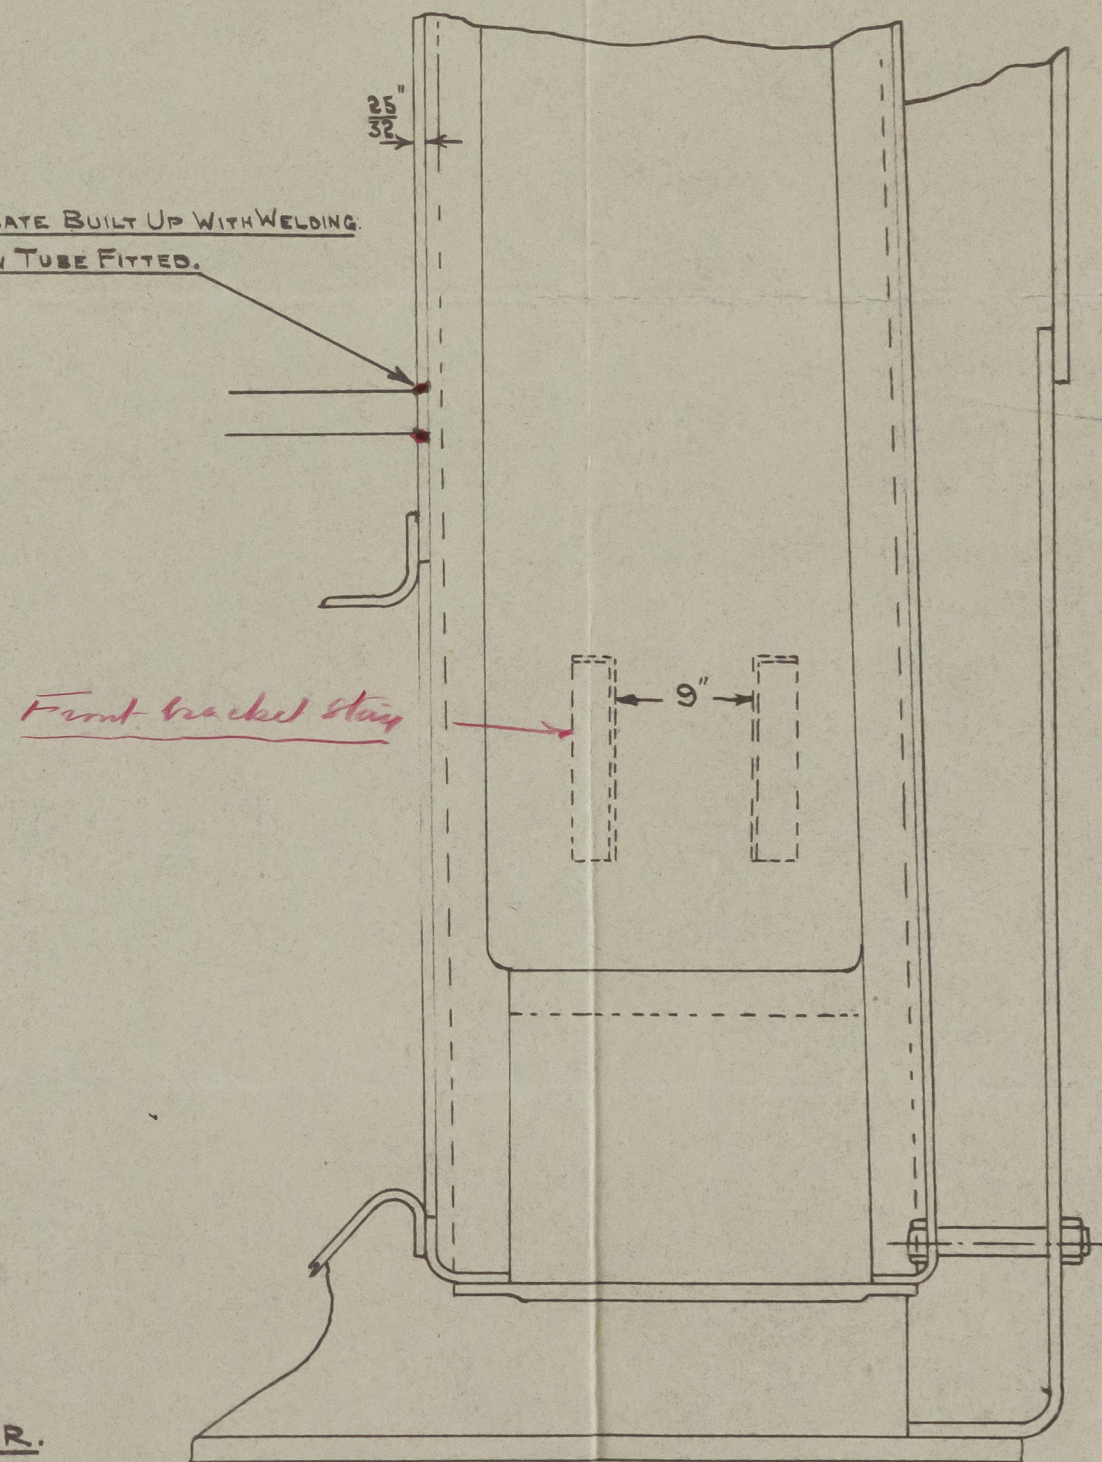

James D. Lingett
SURVEYOR TO LLOYD'S REGISTER,
WELLINGTON, N.Z.



© 2020
Lloyd's Register
Foundation

002151-002156-0026