


LLOYDS 100.A.I. CLASS. WITH FREEBOARD.

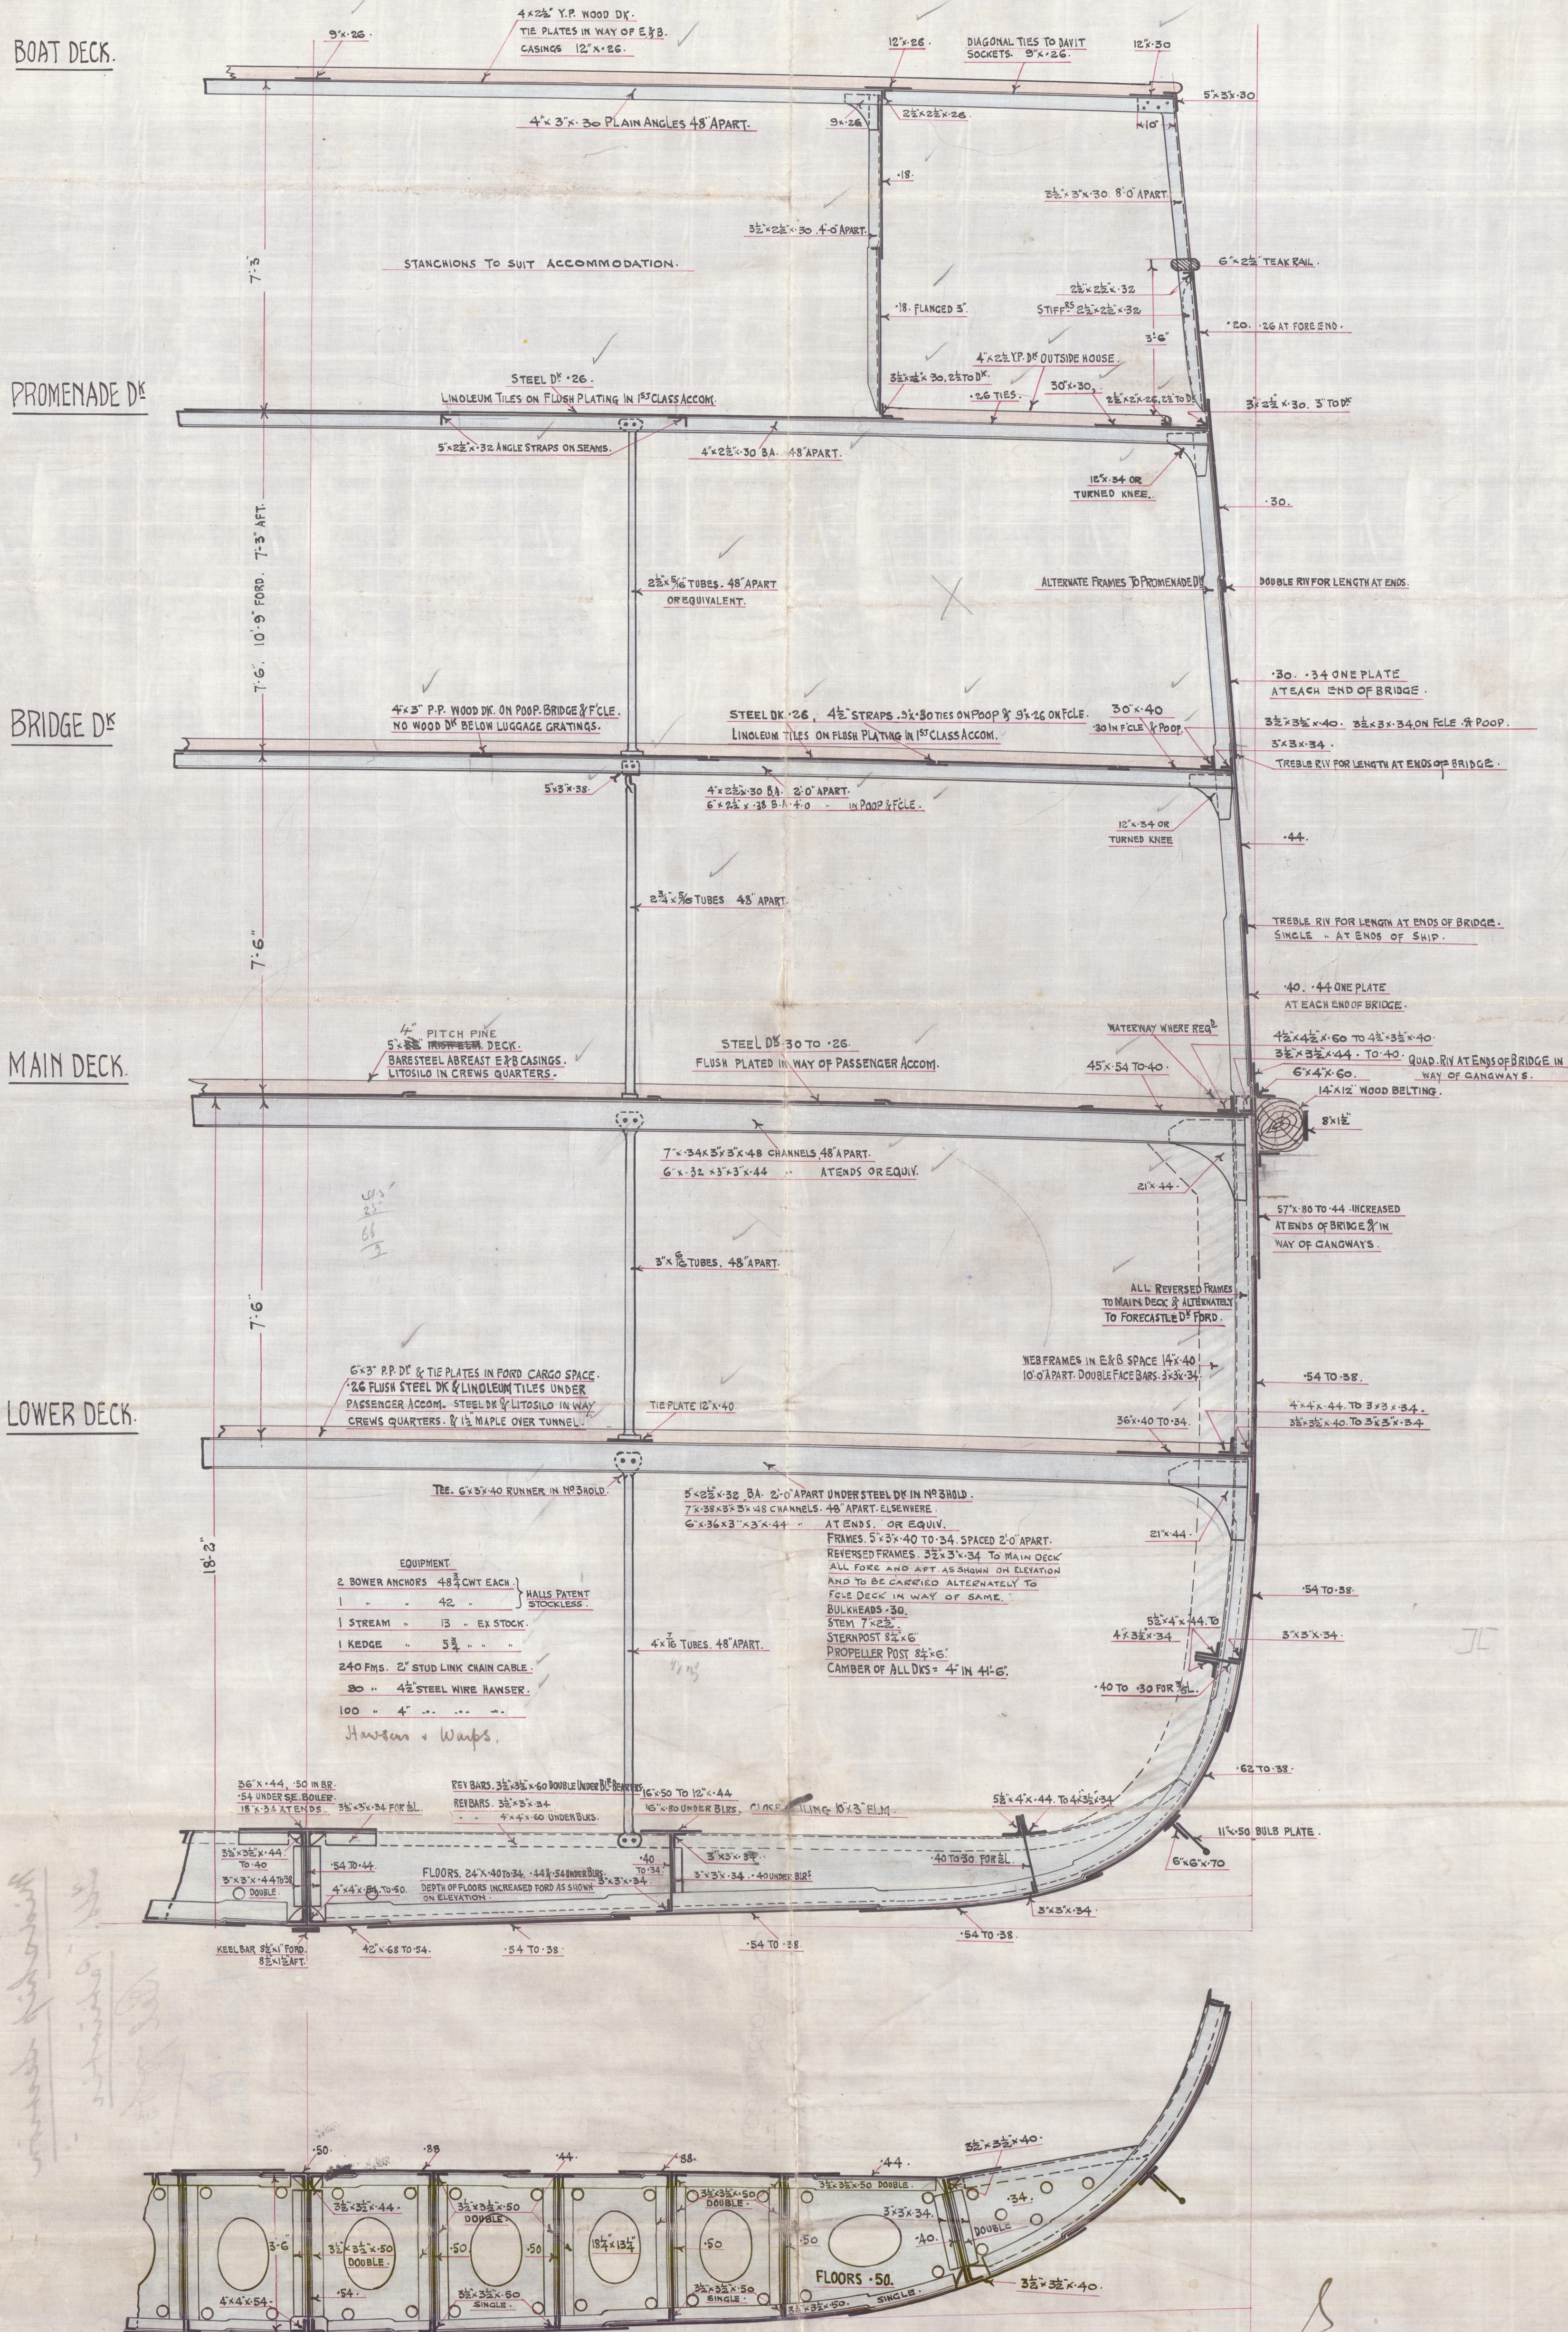

SECTION IN WAY OF ENGINES

Harland & Wolff Ltd

Nº 424

Midship Section

Mss. Patriotic

Rel 7063.

Long, Connan



© 2020

Lloyd's Register
Foundation

002151-002156