


25 NOV 1946
Approved
Continued
10/1/46



Sills at doorways to spaces below deck to be not less than 24" in height

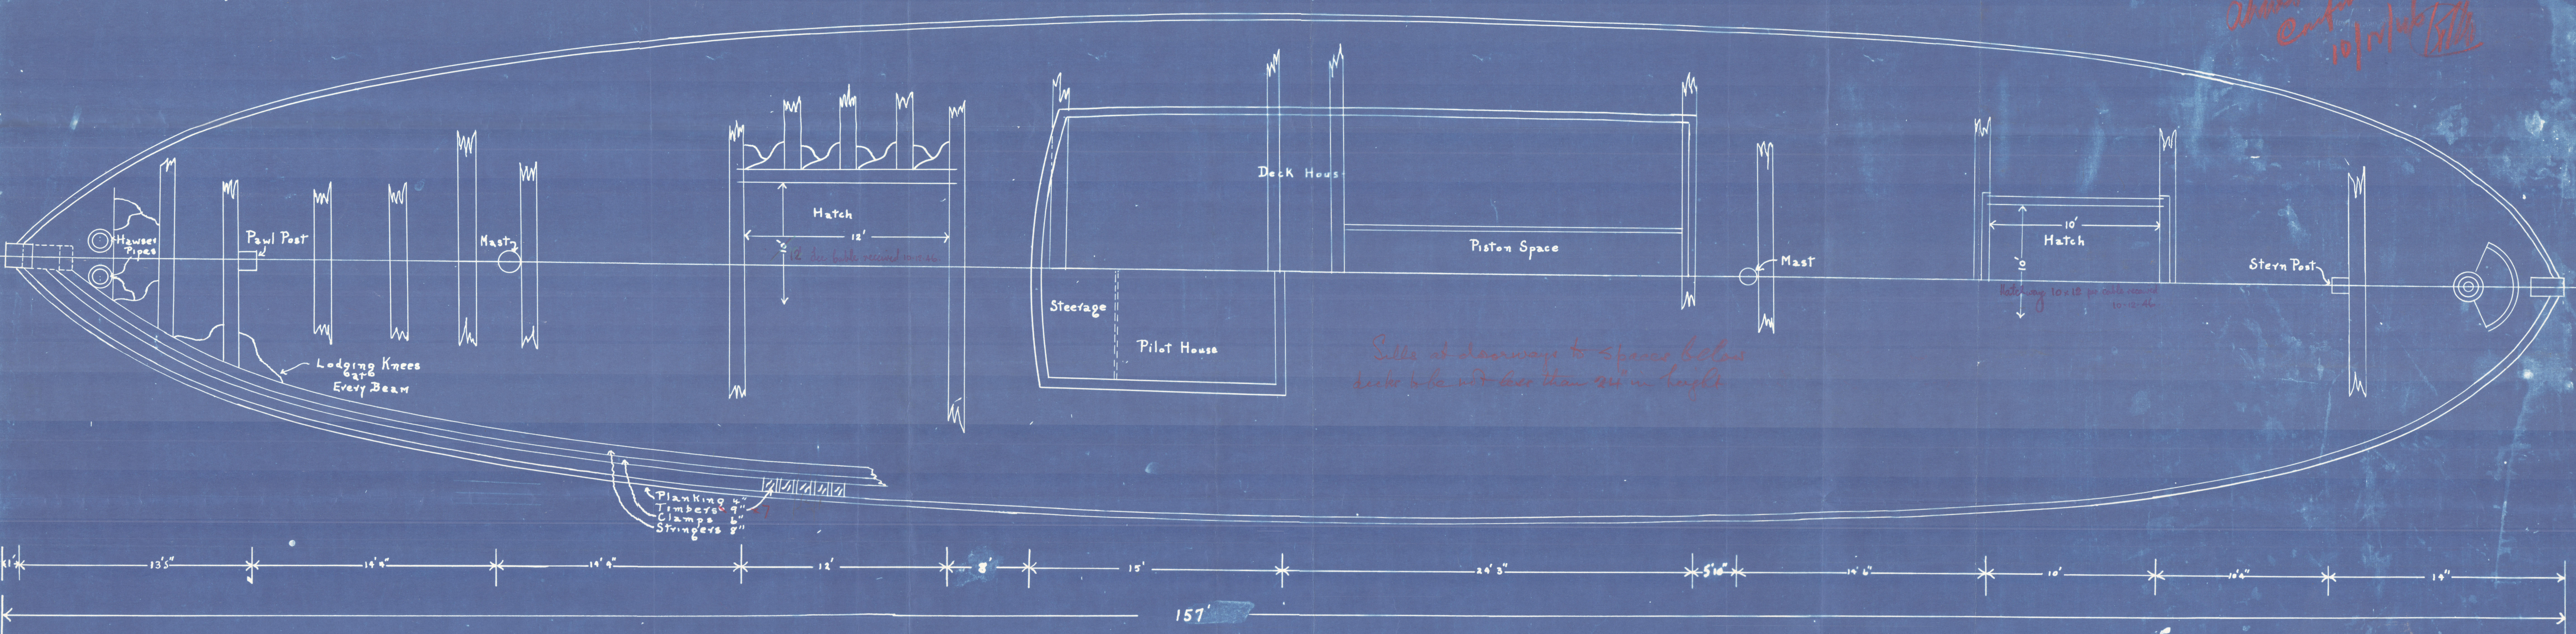

157' Freighter
 Designed
 Smith & Rhuland Ltd.
 Lunenburg
 Nova Scotia
 Lloyd's Foundation

Deck Plan

Smith & Rhuland.

157' Freighter

Bag

002151-002156-0224



© 2020

Lloyd's Register
Foundation

3

TRANSFERRED TO:
L R SYSTEM

Decha

Smith & Rhuland Ltd

Nº 215.

10.12.16.

TRANSFERRED TO:
L R SYSTEM

LADY PATRICIA.

002151-002156-0224

3



© 2020

Lloyd's Register
Foundation