



15 NOV 1946

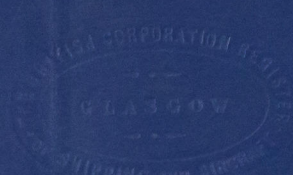

*Approval  
Completed  
10.12.46  
[Signature]*

*Area = 30 sq feet  
S = 30 / 30 = 1.00 ft.  
1.59 ft. 3.9 units*

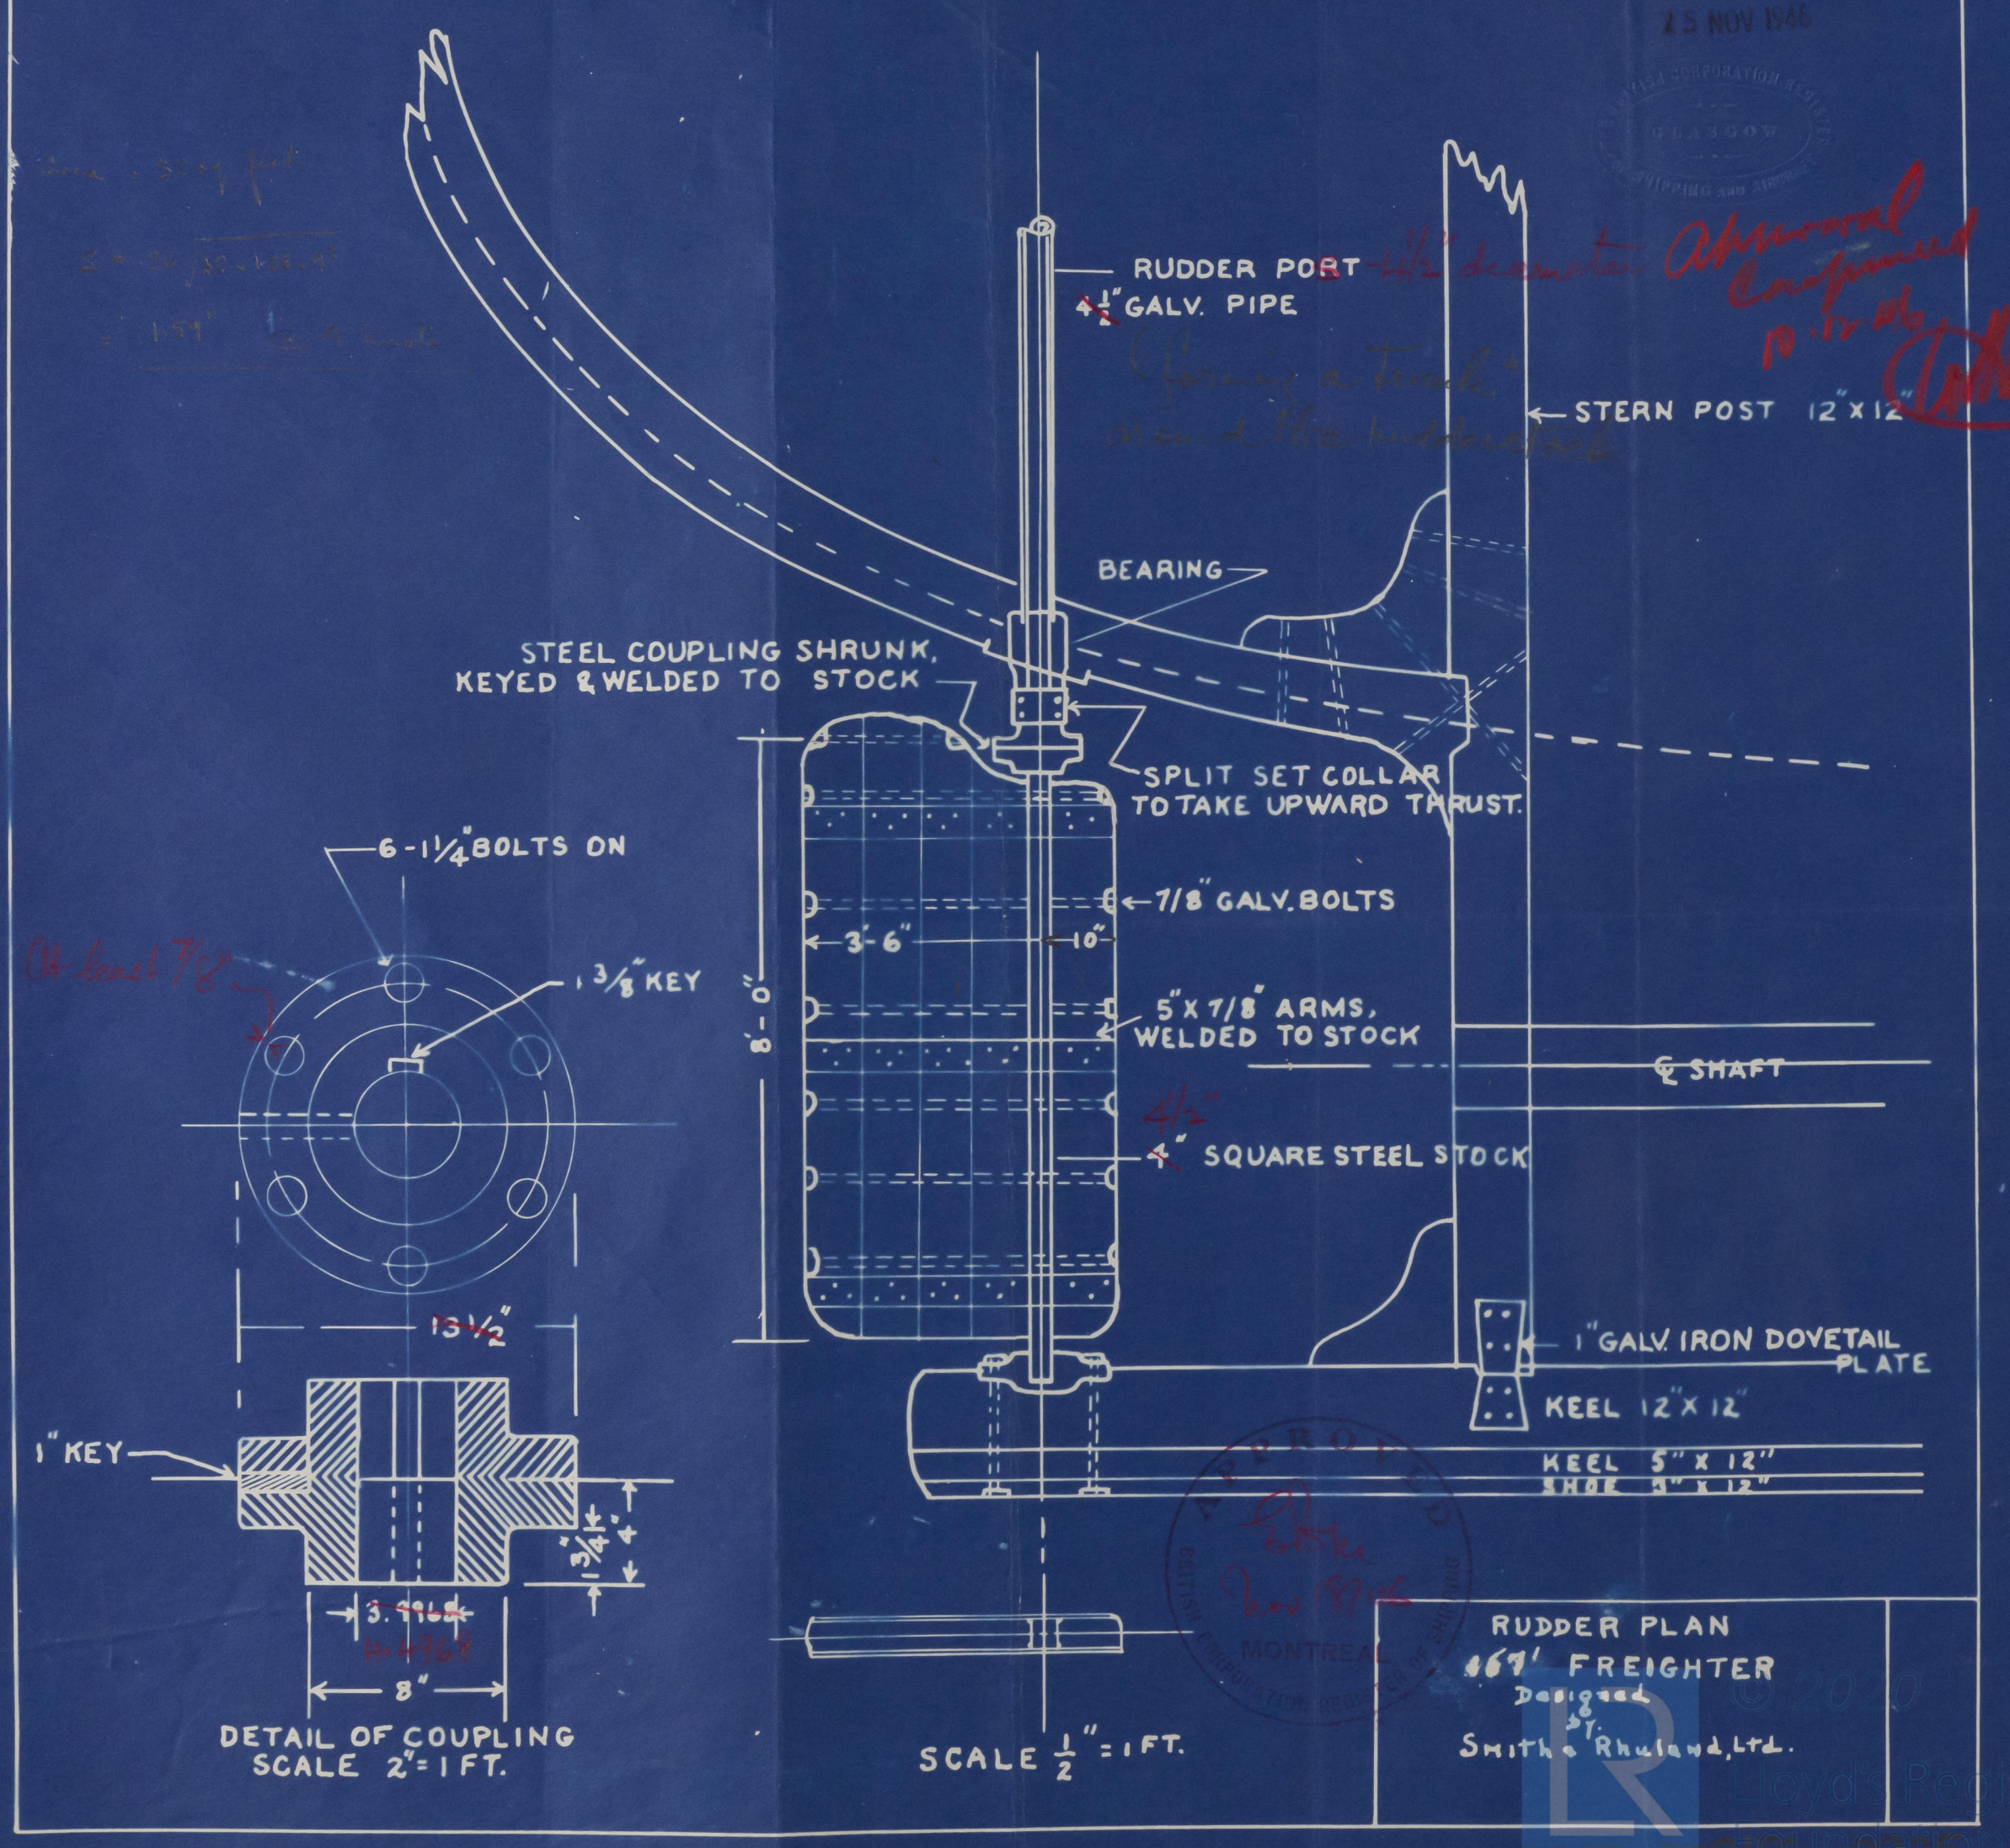

RUDDER PLAN  
467' FREIGHTER  
Designed  
by  
Smith & Rhuland, Ltd.

Lloyd's Register  
CORPORATION



H

TRANSFERRED TO:  
L R SYSTEM

Rudder

Smith & Rhuland Ltd

Nº 215.

10.12.16.

TRANSFERRED TO:  
L R SYSTEM

LADY PATRICIA.

Bury

157' draught.

Smith & Rhuland Ltd

4

Plan

Rudder



© 2020

Lloyd's Register  
Foundation

002151-002156-0225