



Approval confirmed
10-12-46

25 NOV 1946

Forecastle Head

GM

Painters * Breast Hooks as Specified
All Keel Bolts $\frac{1}{8}$ " Galv. Iron.

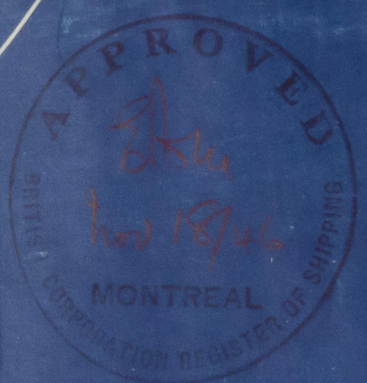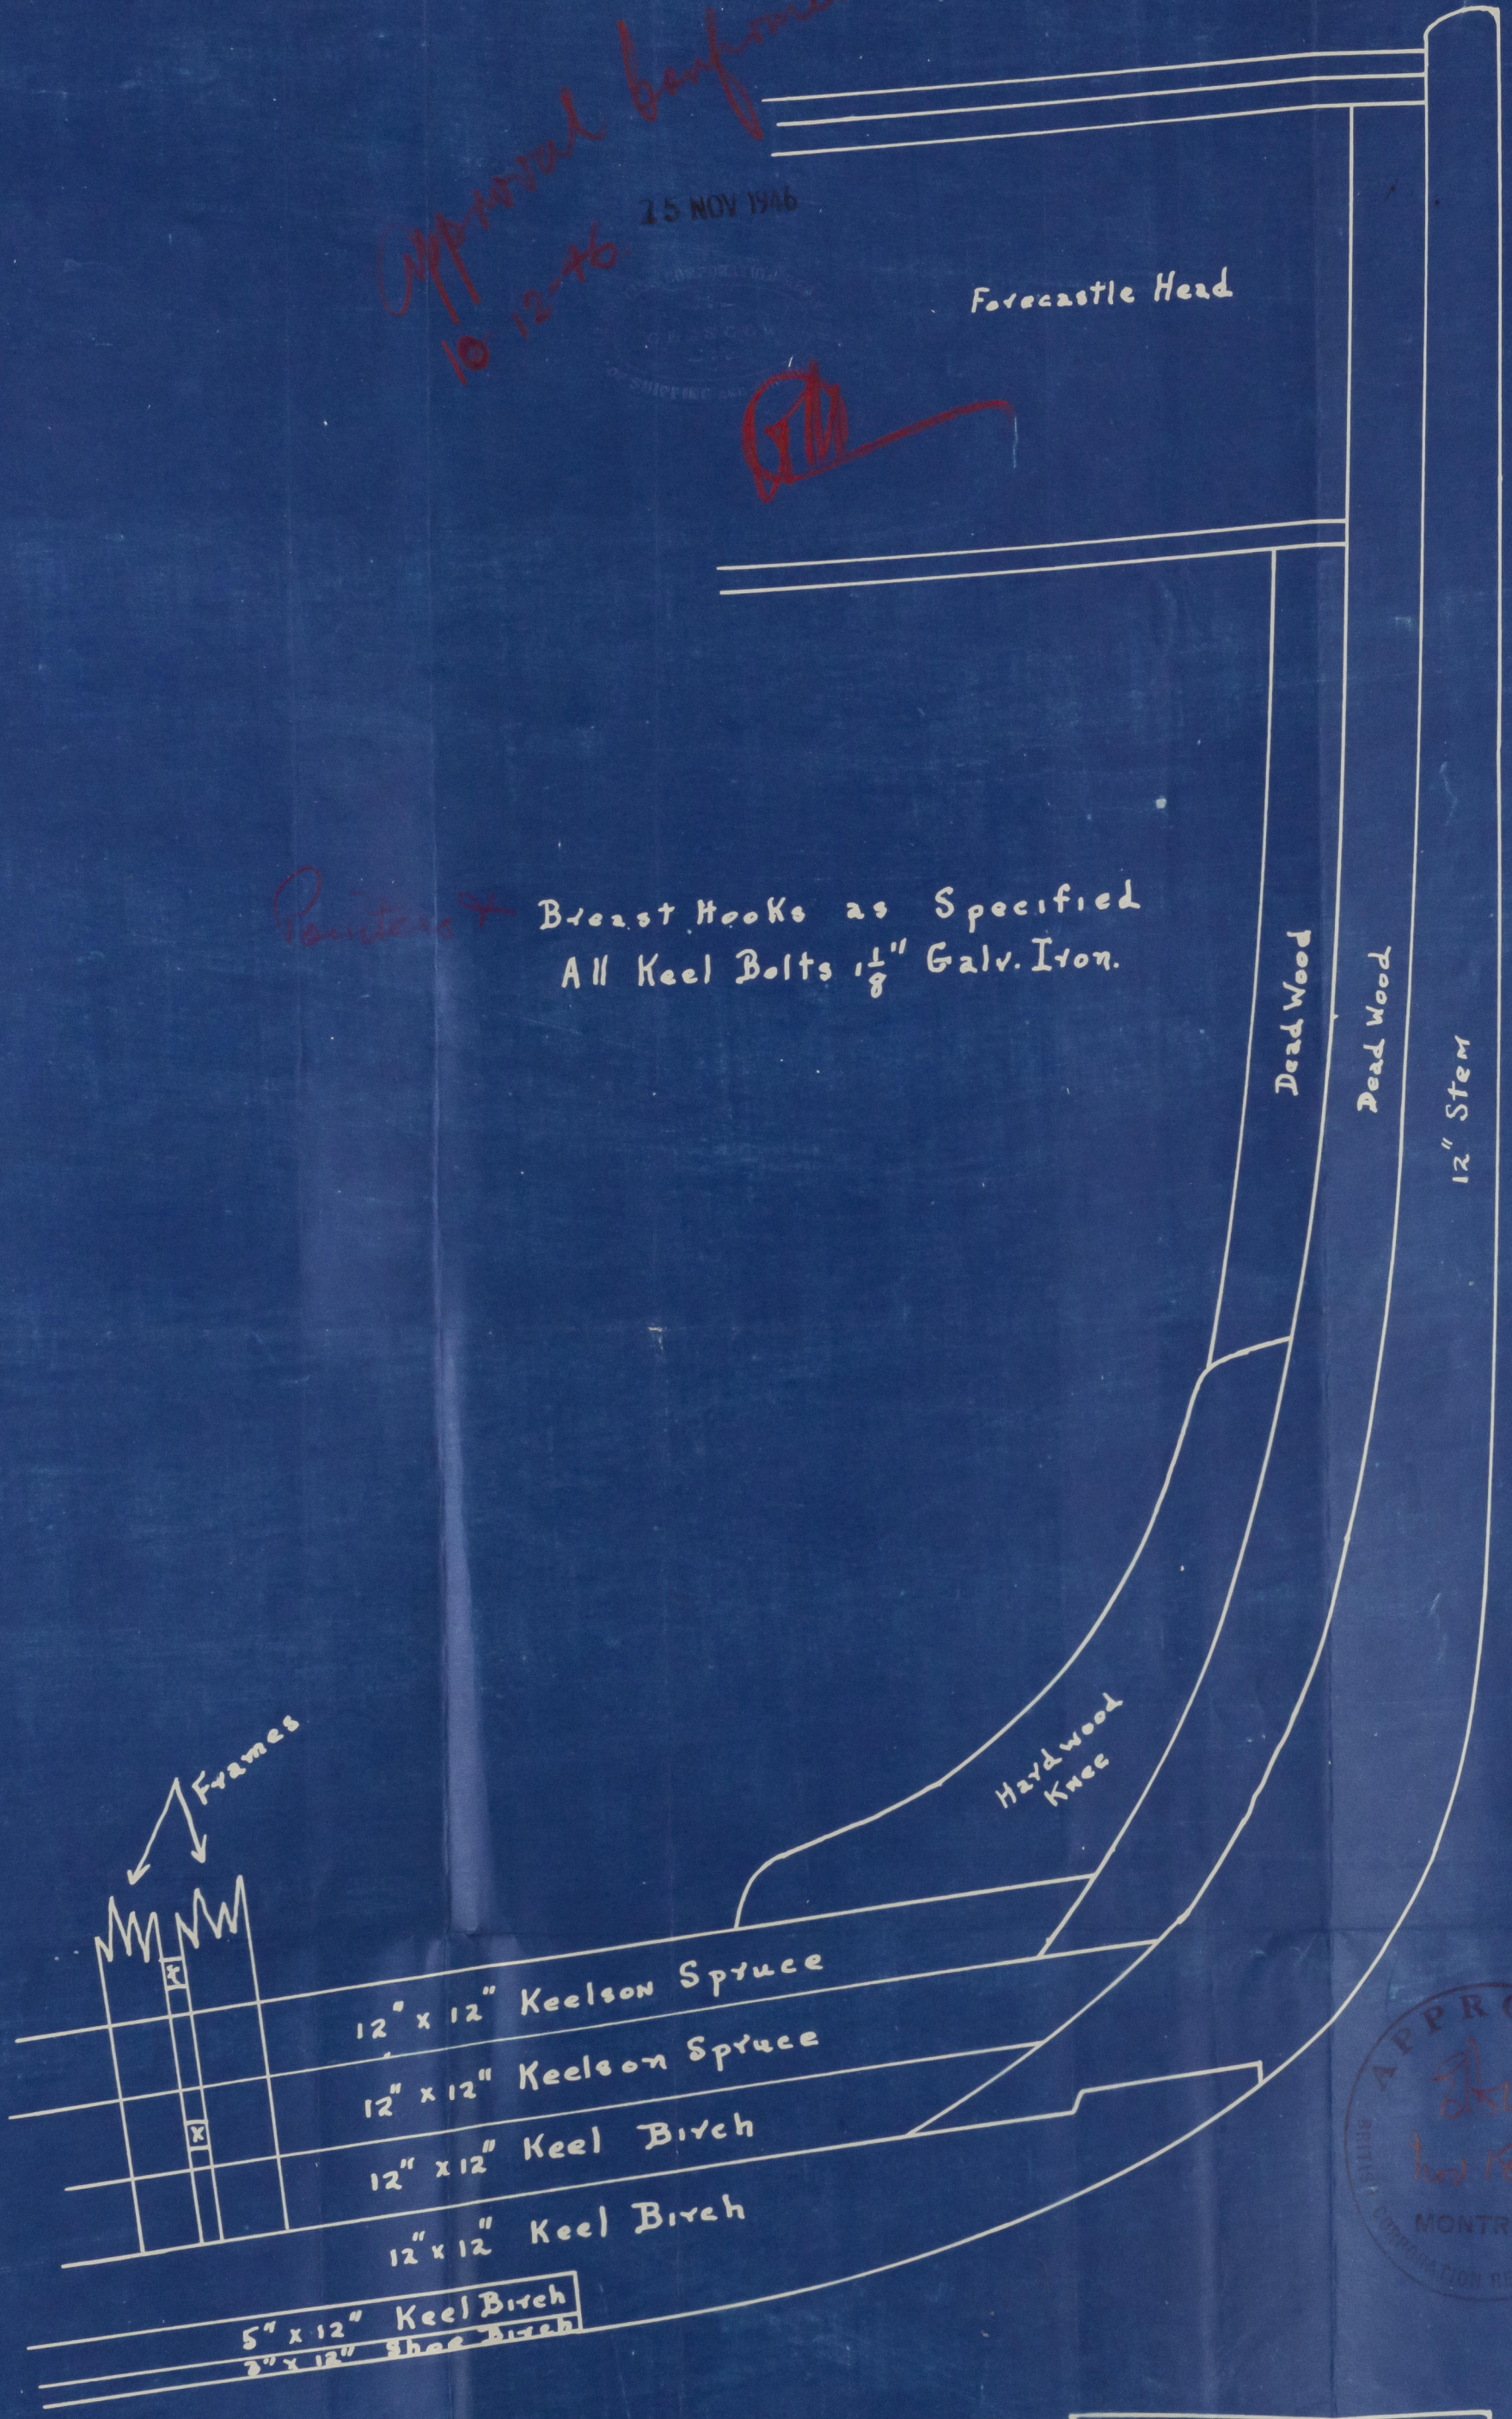

Bow Sketch
157' Freighter
Designed
Lunenburg N.S.

5

TRANSFERRED TO:
L R SYSTEM

Bow Plan

Smith & Rhuland, Ltd.

Nº. 215,

10.12.16.

LADY PATRICIA.


TRANSFERRED TO:
L R SYSTEM

Bay

Smith & Rhuland Ltd.
157' Freight

5

Sketch

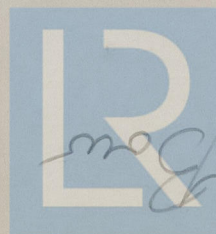

© 2020

Lloyd's Register
Foundation