


S.S. N^o 459- 482'-0" x 57'-0" x 35'-10" KEEL TO UPPER DK BEAMS.

SCALE $\frac{1}{2}$ IN. = 1 FOOT.

TO CLASS AT LLOYD'S 100 A.M.

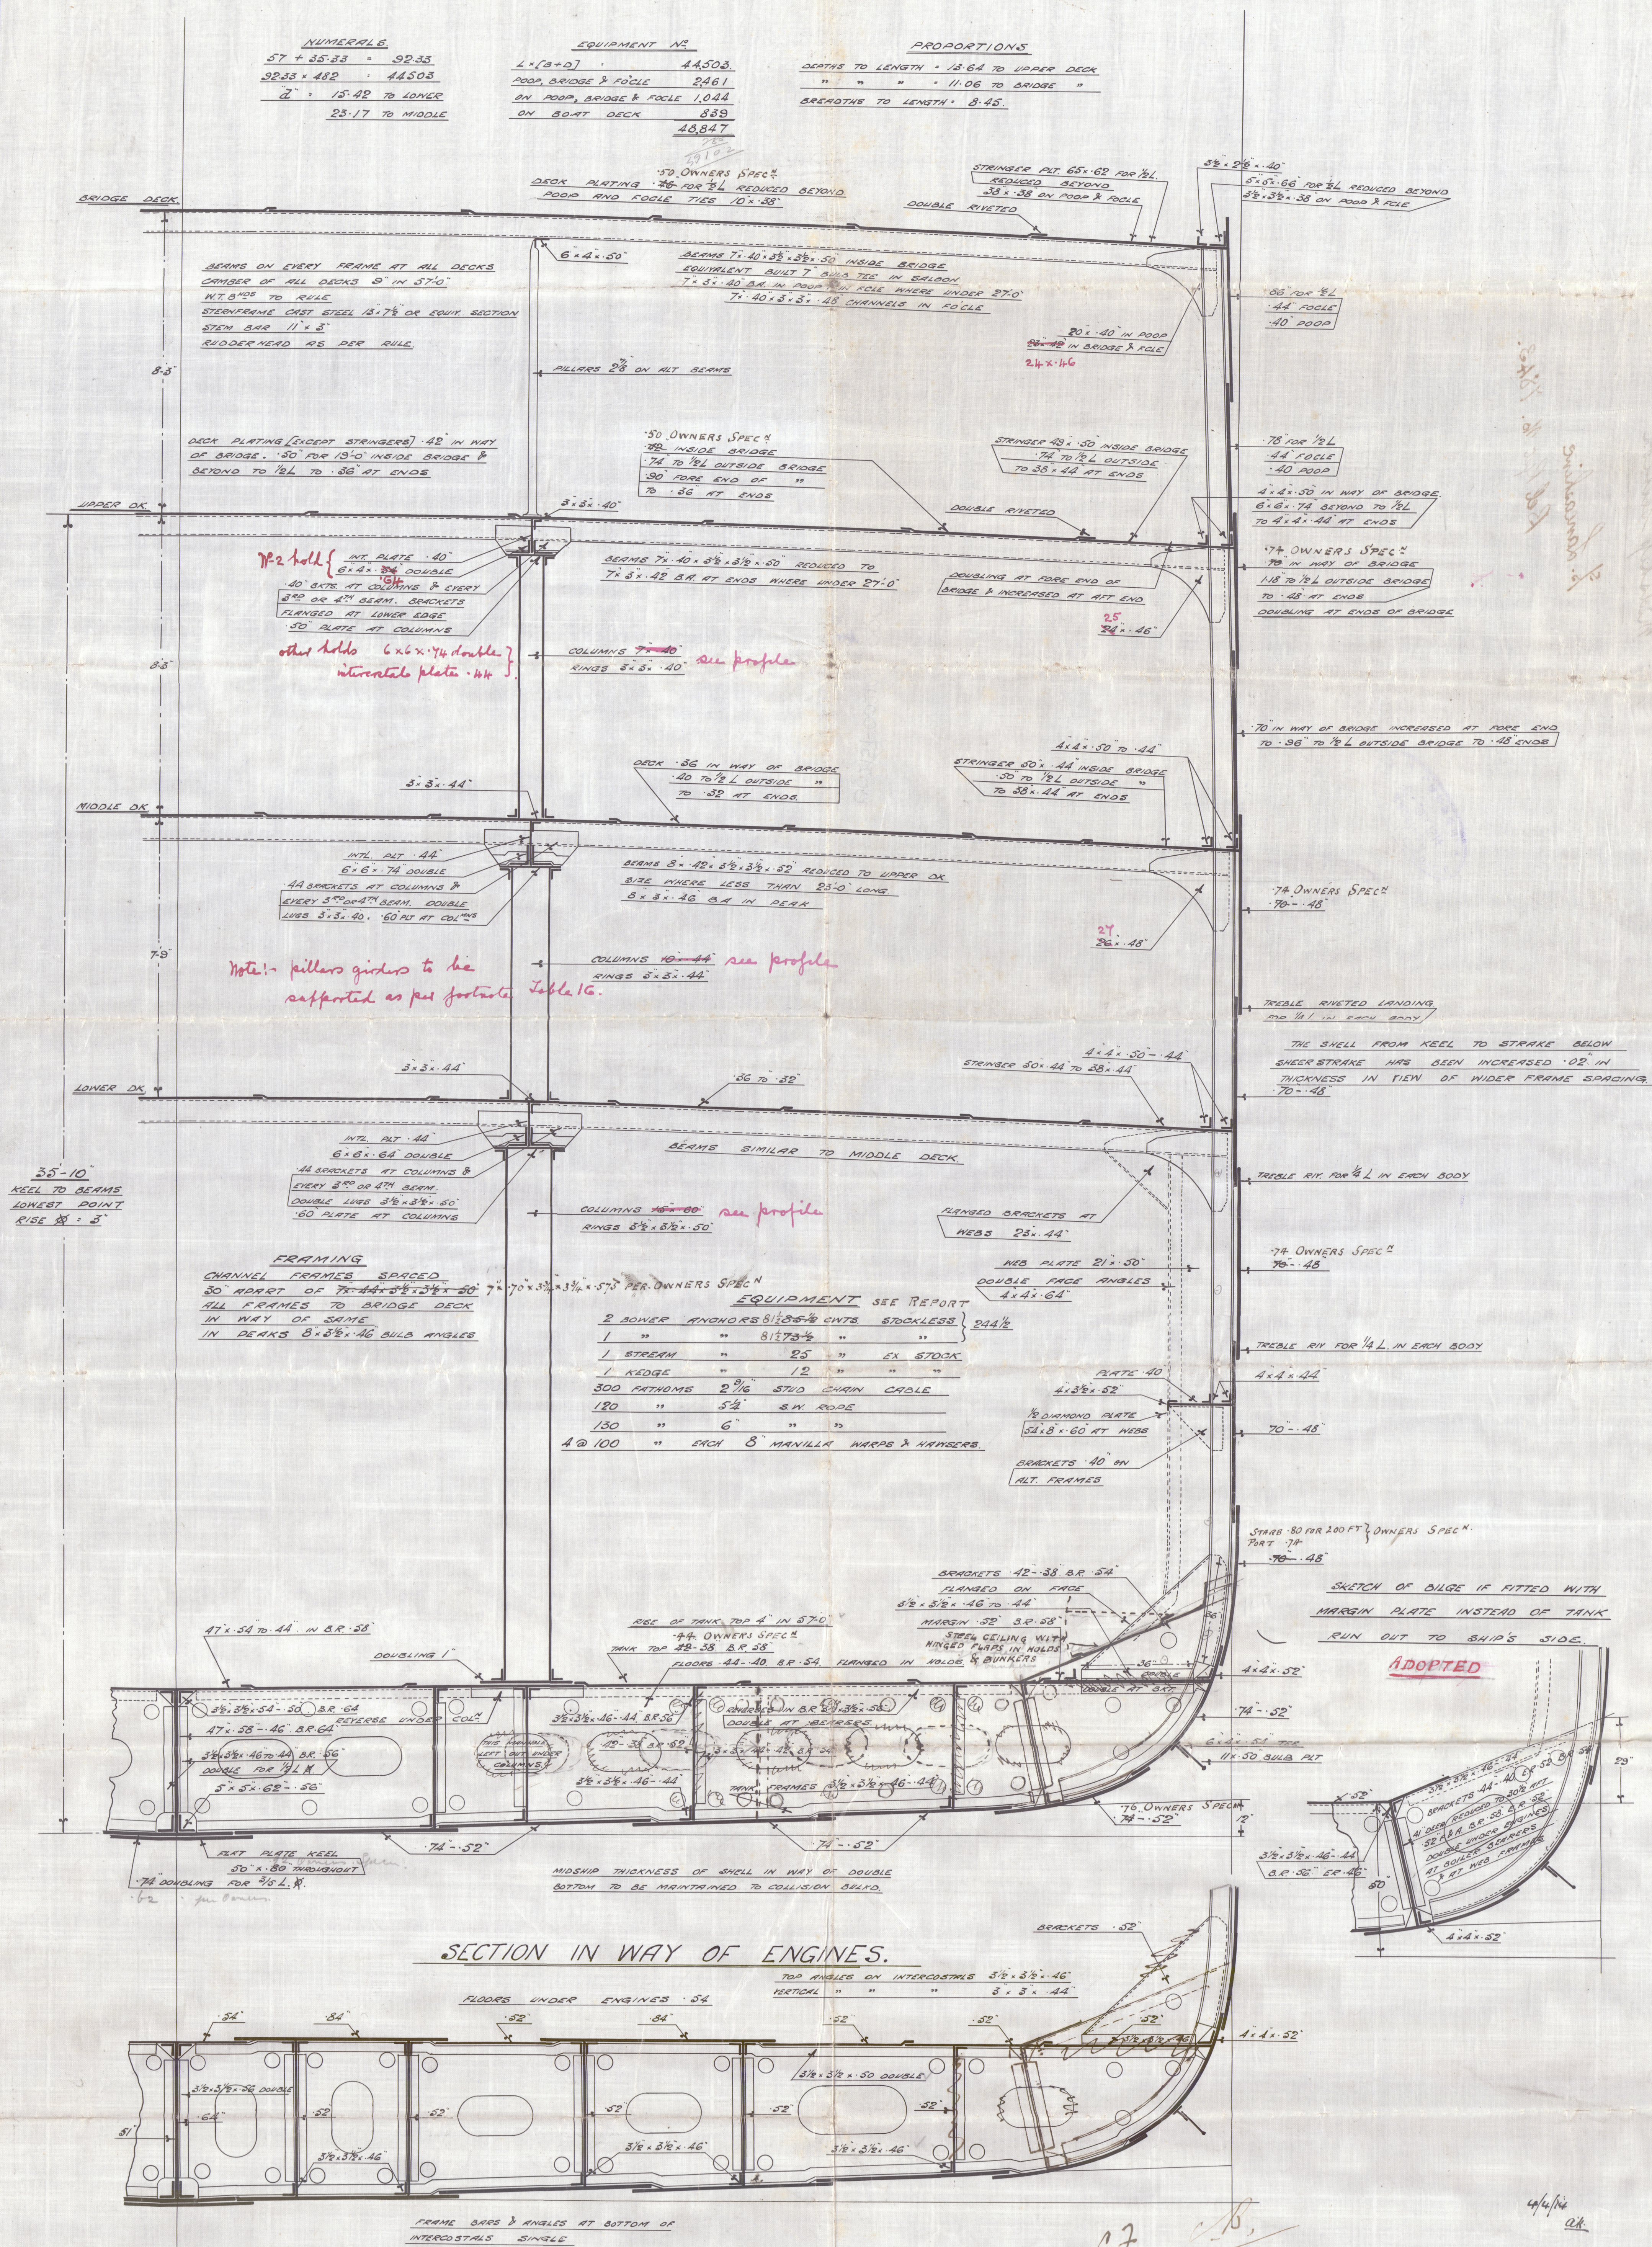


© 2020

Lloyd's Register
Foundation


Harland & Wolff. Ltd.

No 459

Midship Section

S. Lancashire

Bel. Rpt. No. 7843.

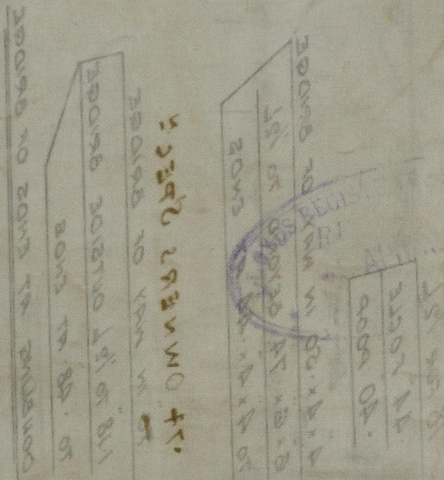

© 2020

Lloyd's Register
Foundation

002157-002161-0001