
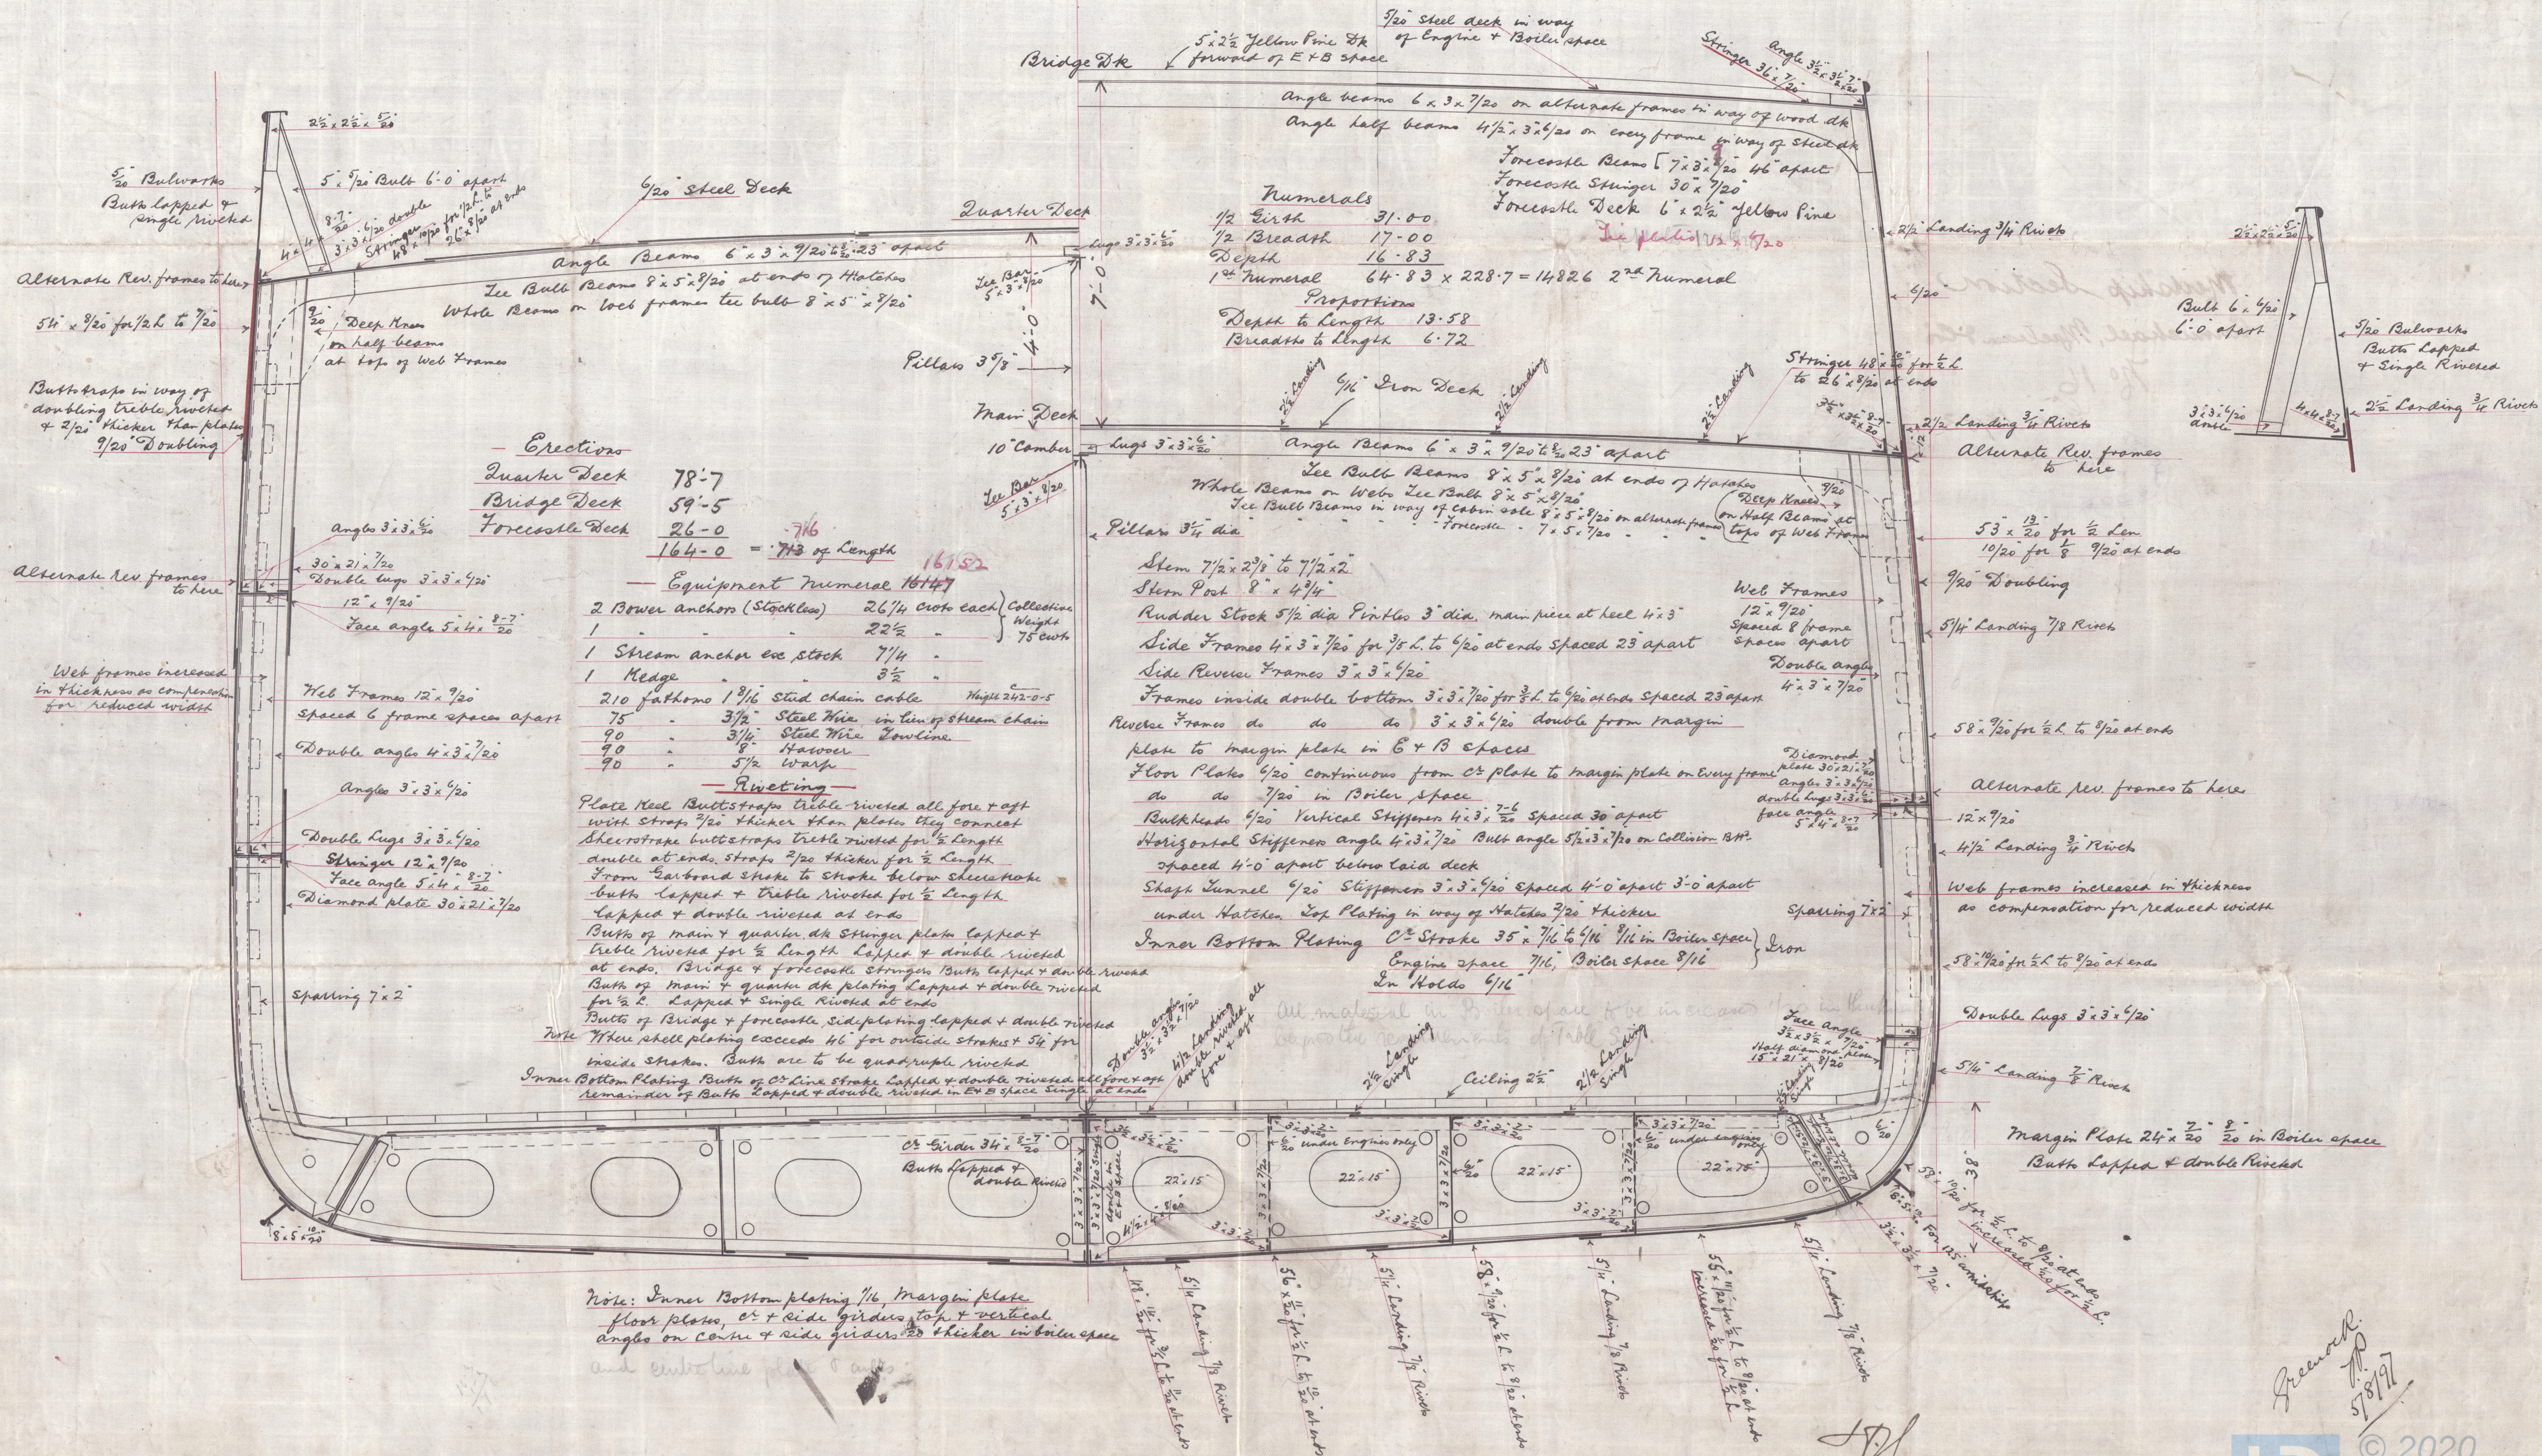


11.8.97
28.9.97
19.10.97


Midship Section S.S. No 16
To Class 100 4.1 at Lloyds Well Deck
Dimensions 230'-0" x 34'-0" x 16'-0" Mtd to main dk
Scale 1/2 inch = 1 foot

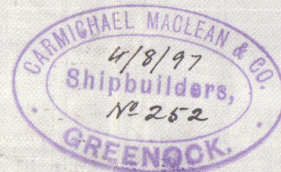



Midship Section
Carmichael, Maclean & Co

No 16

Enk 11983

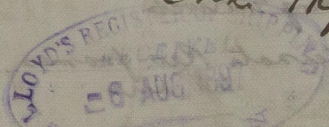

* LAPPORIT

  

© 2020

Lloyd's Register
Foundation

002157-002164-0100