

LLOYD'S REGISTER OF SHIPPING


UNITED WITH THE BRITISH CORPORATION REGISTER

Ship's Name LAPPONIA


Official No.

Memorandum of alterations reported since ship was surveyed for assignment of Load Lines in FEBRUARY, 1952, AT BREMEN


FORECASTLE:

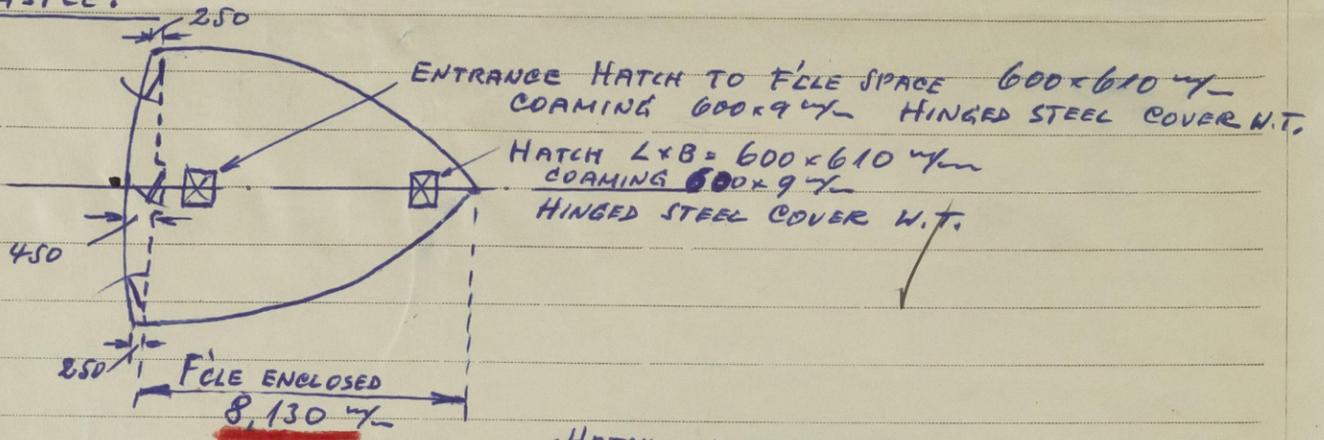

UPPER DECK, AFT:

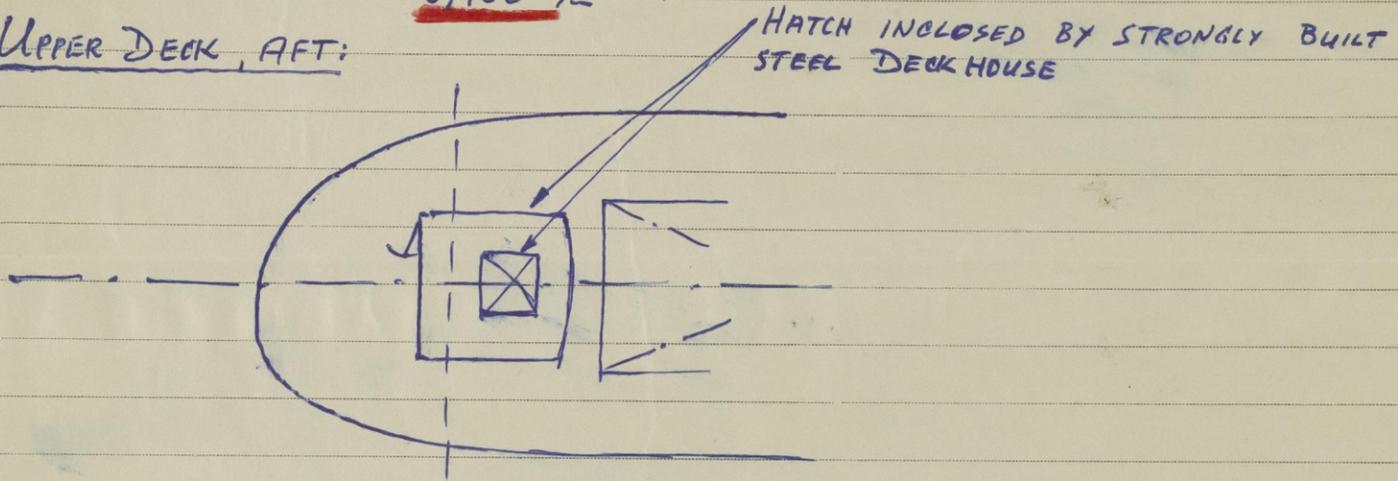

BRIDGE DECK:

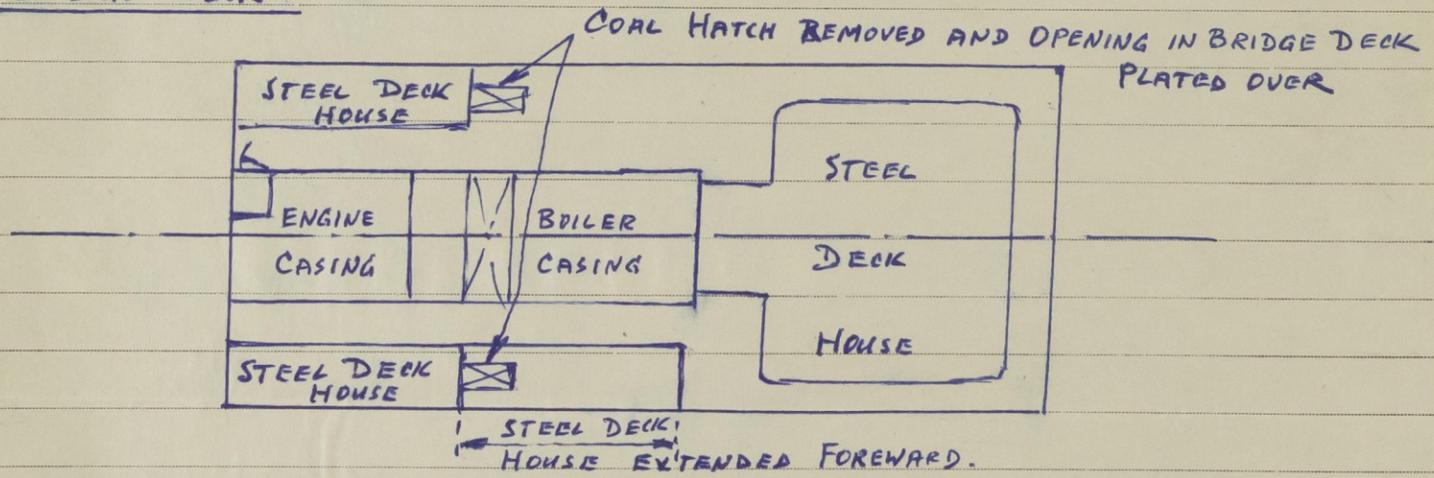

Bremen, the 13th of February, 1952

A. J. J. J.

g.b.
19.2.52