

27 FEB 1952

Rpt. C. 11 (Contd.)

Index No. ....



## LLOYD'S REGISTER OF SHIPPING

UNITED WITH THE BRITISH CORPORATION REGISTER

Ship's Name LAPPONIAOfficial No. 622

Memorandum of alterations reported since ship was surveyed for assignment of Load Lines in FEBRUARY, 1952. (BREMERHAVEN)

- 1.) SIDE SCUTTLES IN BRIDGE SPACE (AS MARKED ON ORIGINAL CH-FORM) REMOVED AND THE OPENINGS IN SHELL SIDE PLATING PLATED OVER.
- 2.) ENTRANCE HATCH TO FILE SPACE  $600 \times 610$  "IN NOW ALTERED INTO COMPANIONWAY EFFICIENTLY CONSTRUCTED AND SECURED TO THE DECK HAVING A STEEL W.T. DOOR  $880 \times 490$  "IN CAPABLE OF BEING OPERATED AND SECURED FROM BOTH SIDES. SILL  $610$  "IN.
- 3.) 2 FLUSH BUNKER SCUTTLES FITTED ON BRIDGE DECK OF SUBSTANTIAL CONSTRUCTION WITH SCREW JOINTS. (1PS, 1SS). COVERS PERMANENTLY ATTACHED BY A CHAIN.

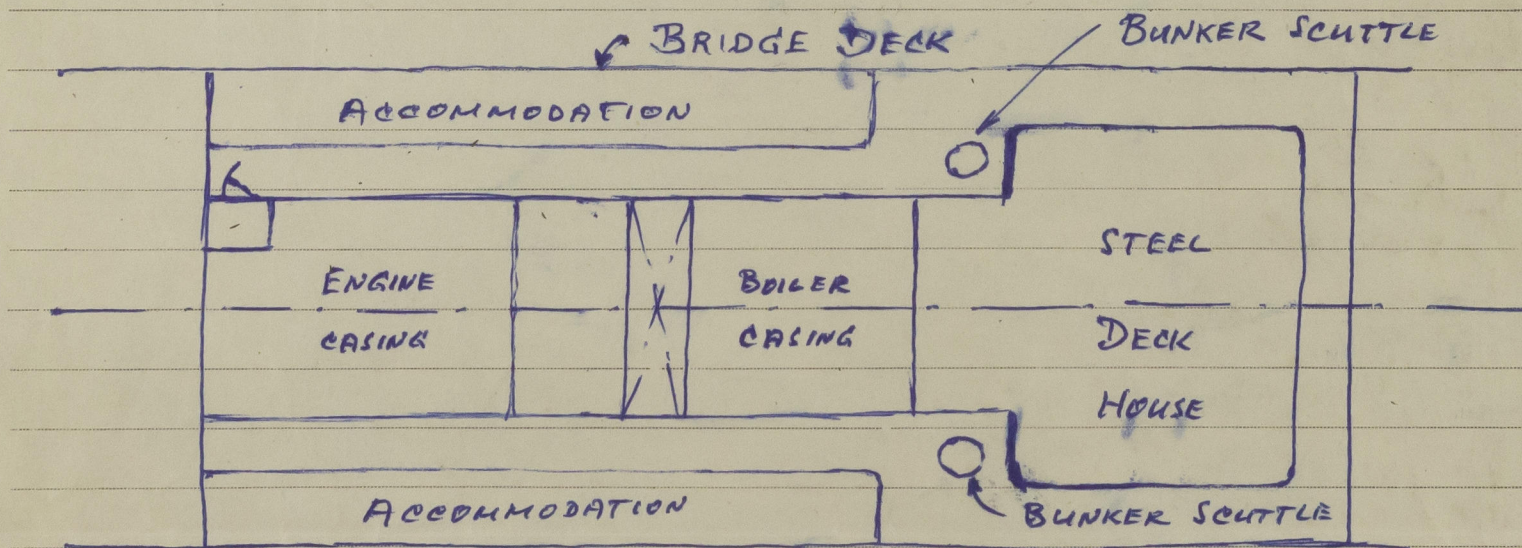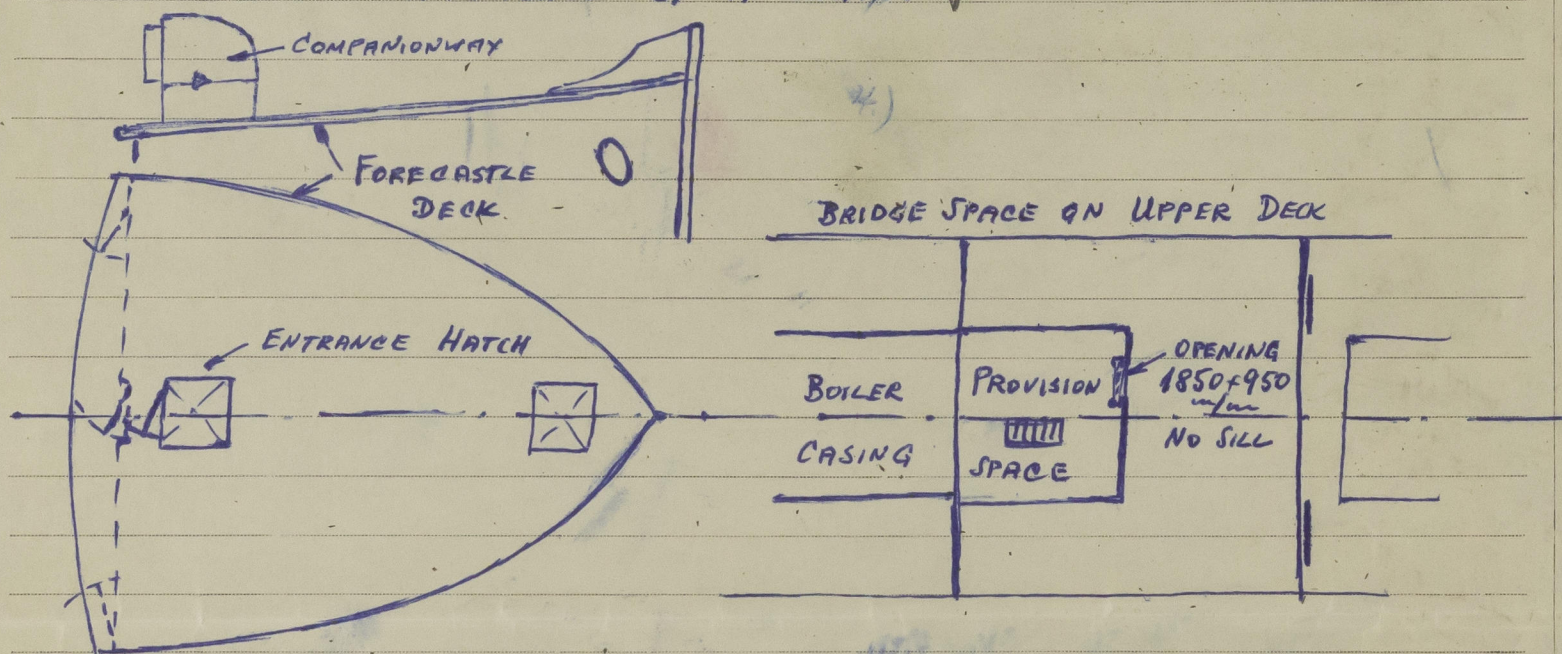

- 4.) PROVISION ROOM IN BRIDGE SPACE NOW FITTED WITH OPENING IN FRONT WALL CLOSED BY WOODEN SHIFTING BOARDS IN WELDED CHANNELS FULL HEIGHT.

Bremen, the 23<sup>rd</sup> of February, 1952

*Al. J. J. J.*

Lloyd's Register Foundation

002157-002164-0110