

S. S. TSUKUSHI MARU
GENERAL ARRANGEMENT
AS REQUIRED AS PILGRIM SHIP

SCALE 1:200

DRG. N° TBD/101


PASSENGERS LIST

CABIN CLASS	1ST CLASS	76
	2ND CLASS	91
PILGRIM		1456
INTER.		110
		1755

PRINCIPAL PARTICULARS.

LENGTH (P.P.)	137' 000
BREADTH (L.M.P.)	18' 000
DEPTH (L.M.P. TO M.F.F. DE.)	10' 150


Ø - INDICATES NEW 12" SIDESCUTTLE TO BE FITTED.

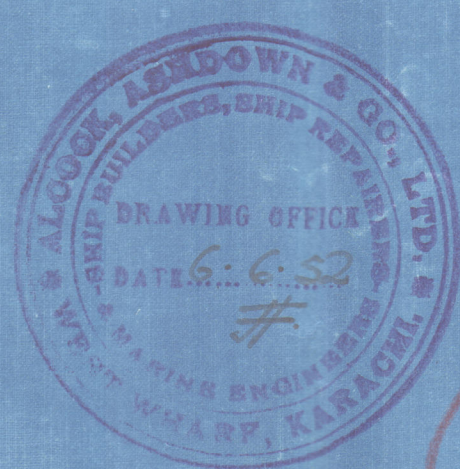

OFFICE

COPIES OF THIS DRAWING.

ISSUED TO	DATE	N°
FOR M.O.		
FOR HEALTH OFFICER		
FOR CHIEF OF POLICE		
FOR CUSTOMS		
FOR IMMIGRATION		
FOR PORT OFFICER		

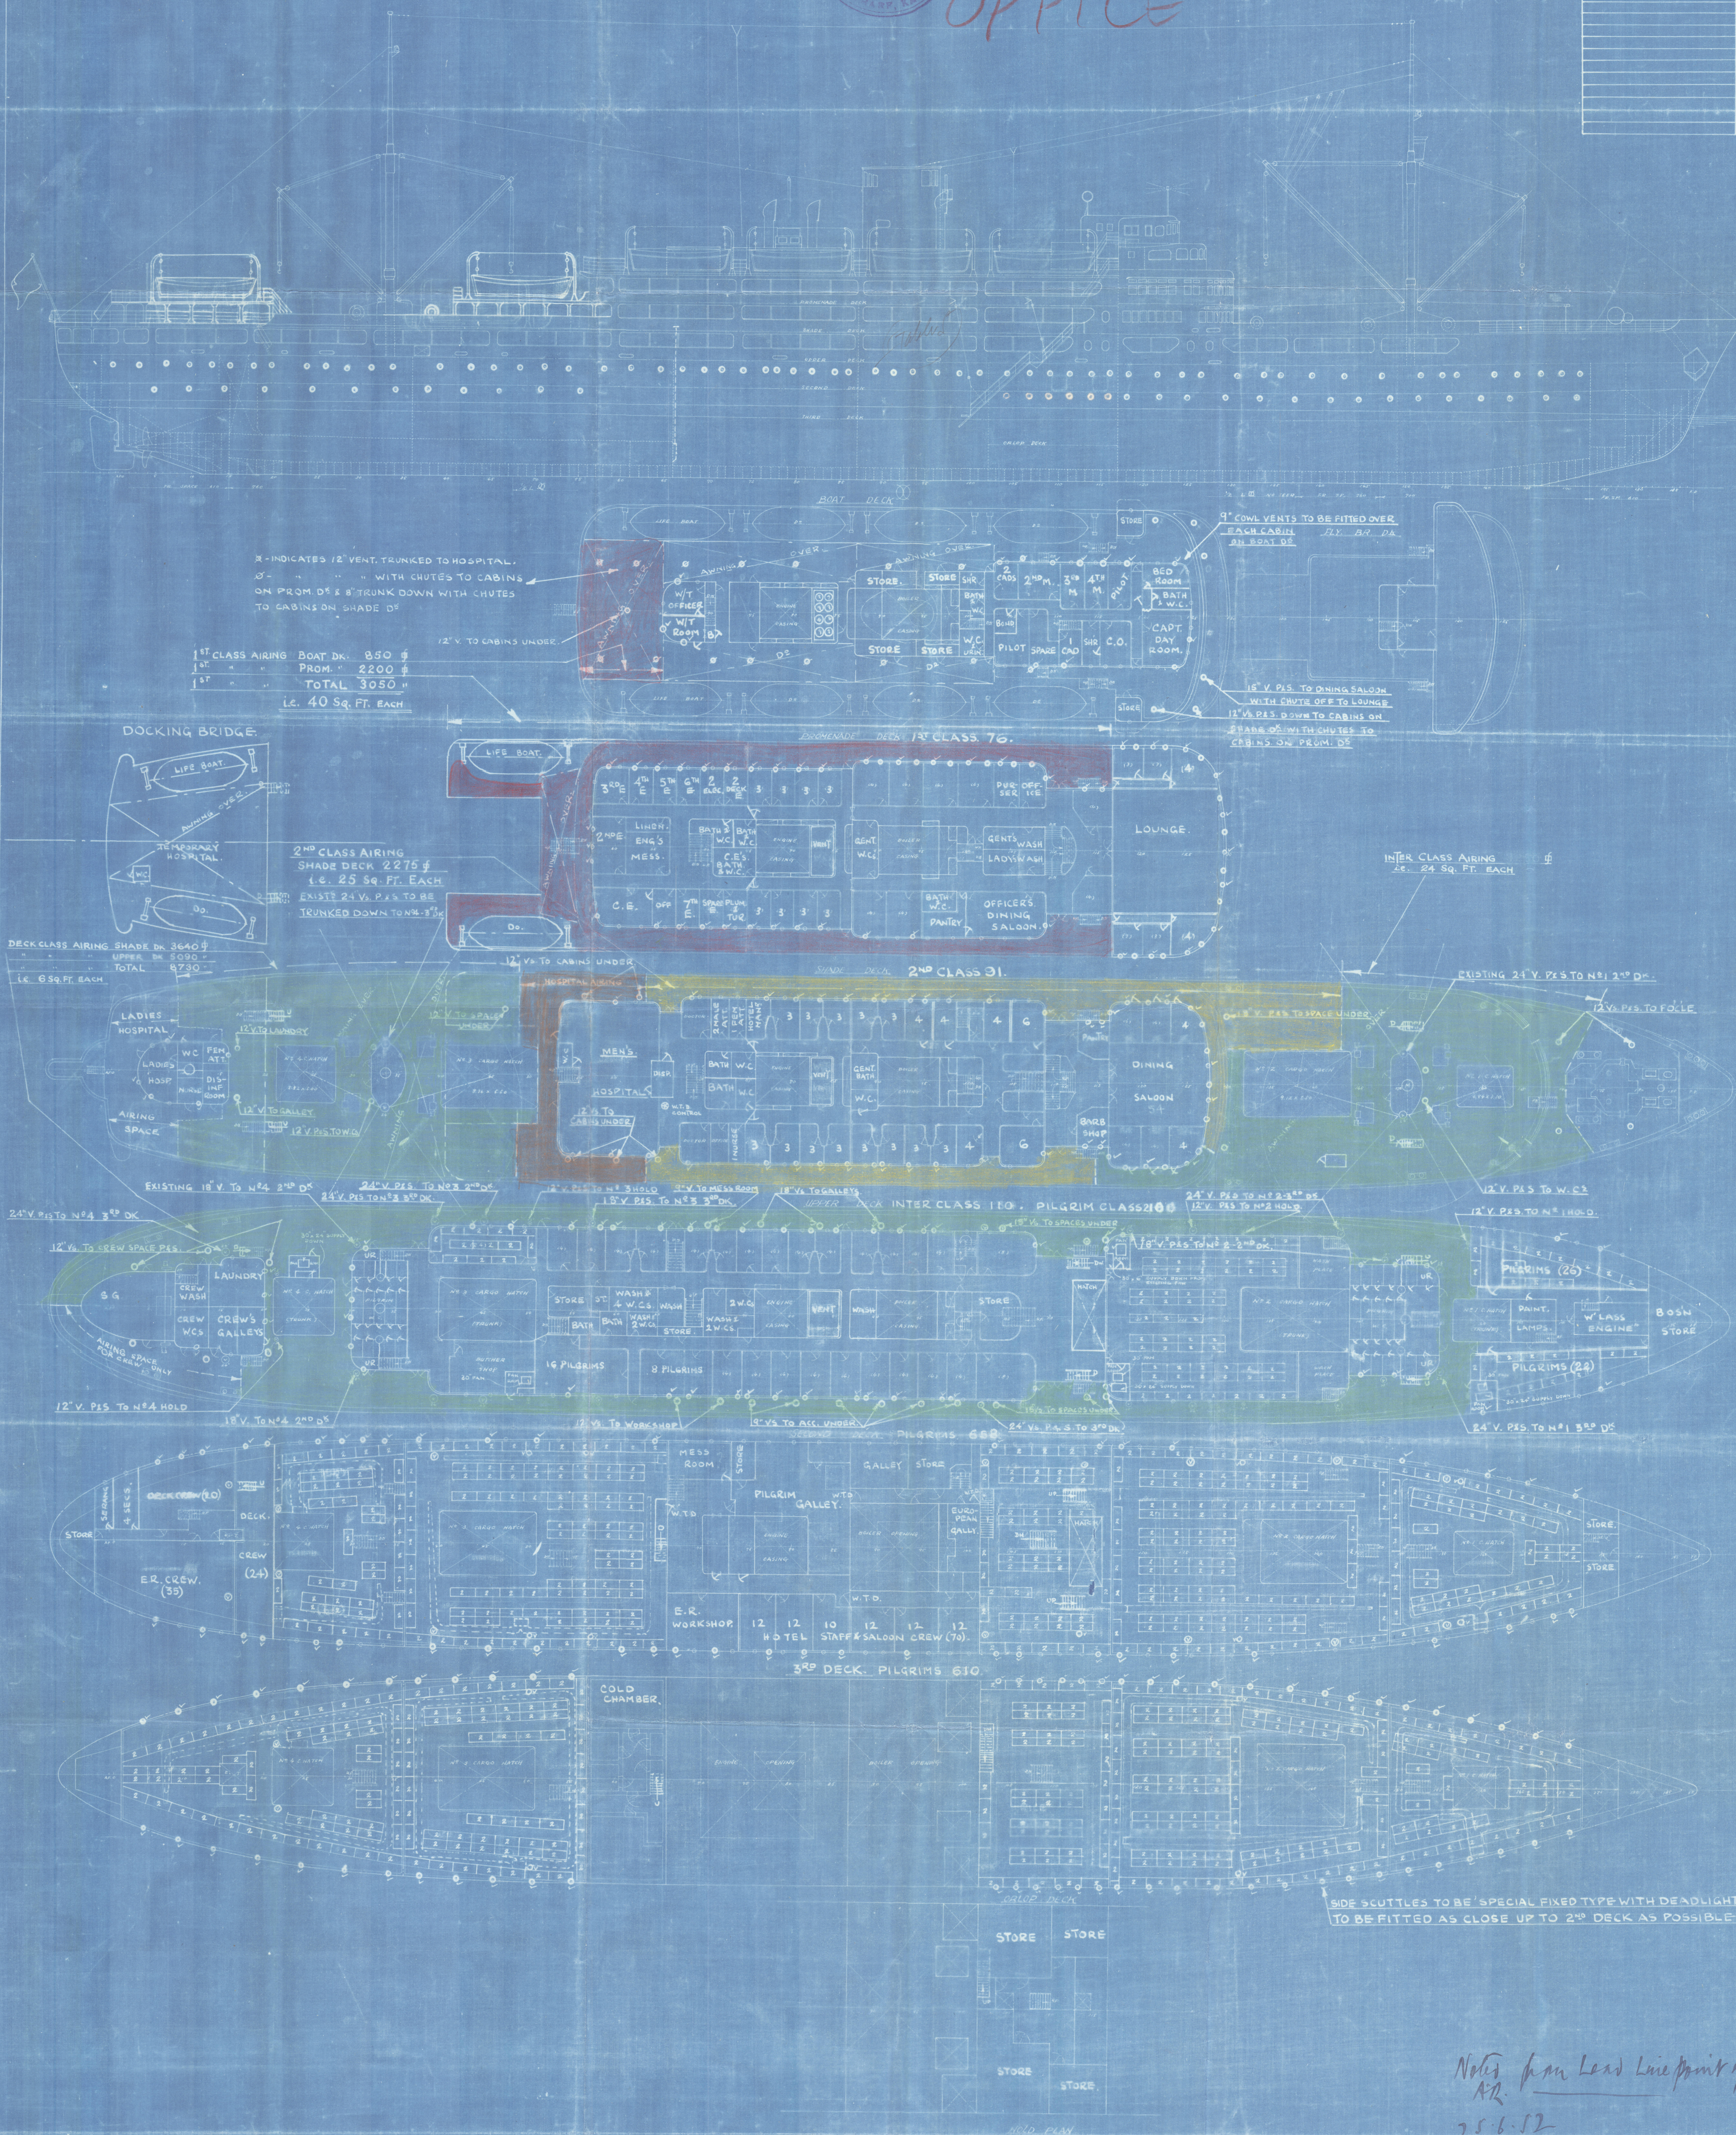

Notes from Lead Line print of vessel
AR
25.6.52
See Letter

Gen Arvayt.

OFFICE

copy

002157-002164-0149



© 2020

Lloyd's Register
Foundation