


ITEMS	MATERIAL	WEIGHT
CUTT UP	CAST STEEL	1,410 Kg.
STERN FRAME		5,864 Kg.

TOTAL WEIGHT 7,274 Kg.

		TOTAL WEIGHT		
1	CUTT UP	CAST STEEL	1	1,410
2	STERN FRAME	"	1	5,864

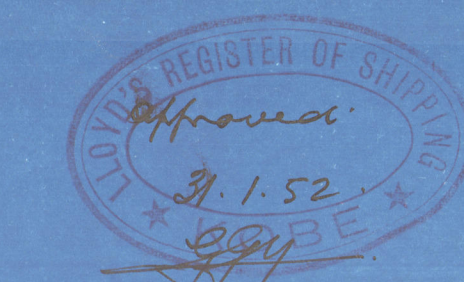


TSUKUSHI MARU	
STERN FRAME	
SCALE 1/25	
HITACHI SHIPBUILDING & ENGINEERING CO. LTD. SHIP DESIGNING SECTION - OSAKA, JAPAN -	
DATE	APPROVED BY
DRAWING NO.	REVIEWED BY
SHEET NO.	CHECKED BY
REMARK	

SAFFINA - E - MILLAT



Sternframe.

RECORDS DEPT.
LONDON

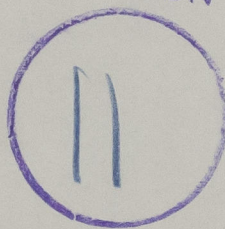

002157-002164-0150



© 2020

Lloyd's Register
Foundation