

# MIDSHIP SECTION.


STEEL SCREW TRAWLER.

*Cape* LORD MELVILLE

DIMENSIONS 140'-0" B.P. x 23'-10 1/2" MLD x 14'-0" MLD.

SCALE 1/2" = 1 FT.

TO CLASS + 100 A.I. STEAM TRAWLER.

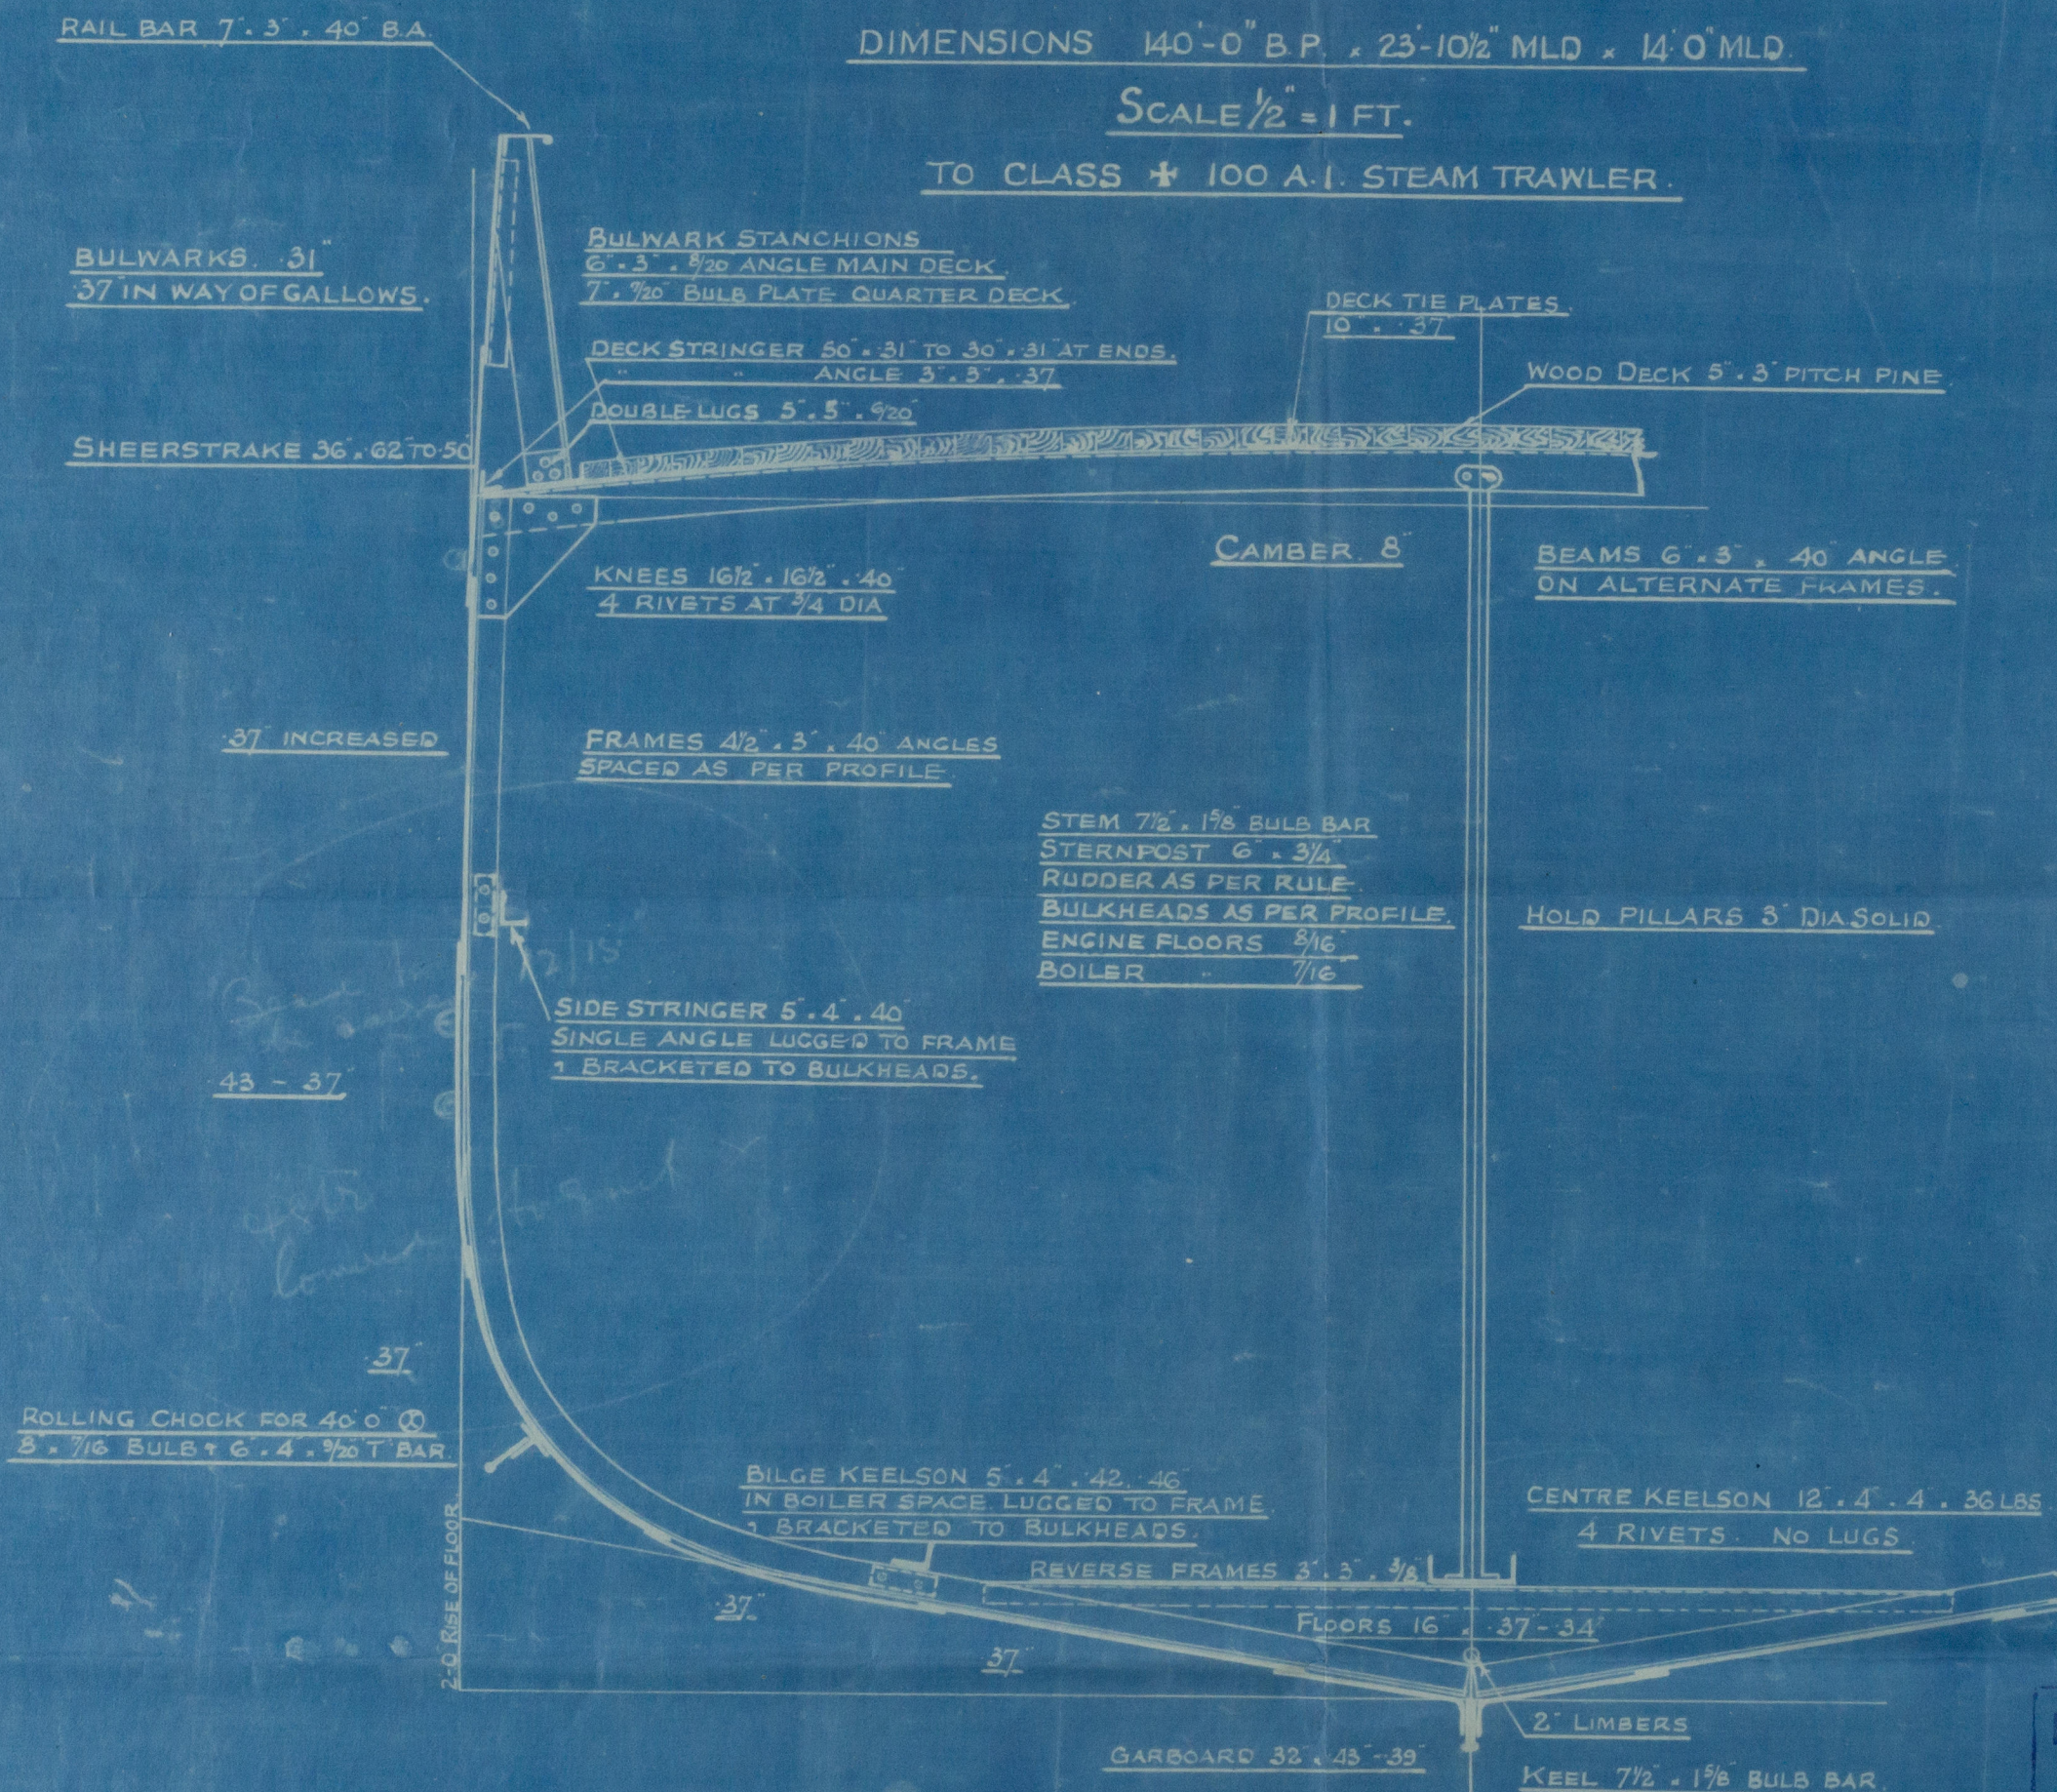

## NUMERALS.

D	=	14.00
L x D	=	1960.00
L x (B + D)	=	5302.50
7/6	=	10.00

## EQUIPMENT.

1 <sup>ST</sup> BOWER ANCHOR	8 1/4 CWTs STOCKLESS
2 <sup>ND</sup>	7 1/2
KEDGE	3 1/4 EX STOCK
120 FATHOMS	1 1/16 STUD LINK CABLE
60	6 HAWSER
60	5 WARP

## RIVETING

BUTTS OF SHELL PLATING LAPPED + DOUBLE RIVETED EXCEPT GARBORD + SHEERSTRAKE WHICH ARE TO BE STRAPPED + DOUBLE RIVETED. LANDINGS DOUBLE RIVETED. BULWARKS STRAPPED + SINGLE RIVETED.


PLAN No. 3238.

FOR ENCL. ORIGIN. TO  
Messrs. Lloyd's Surveyors  
Hull.


10-12-29.

002165-002173-0050

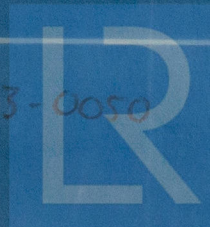

Lloyd's Register  
Foundation



No 1064

Midship Section (as built)

Cochranes Sms L5

S.S. "Cape Melville"

HULL REPORT No. 40461.



© 2020

Lloyd's Register  
Foundation

002165-002173-0050