



30.10.09


RUDDER FRAME

S.S. N^o 220.

SCALE 1"=ONE FOOT.

HOLES TO BE BORED FOR 1" RIVETS AND COUNTERSUNK
SPACED $4\frac{1}{2}$ DIAS. APART PINTLES $2\frac{1}{4}$ " DIA.

27th OCT. 1909

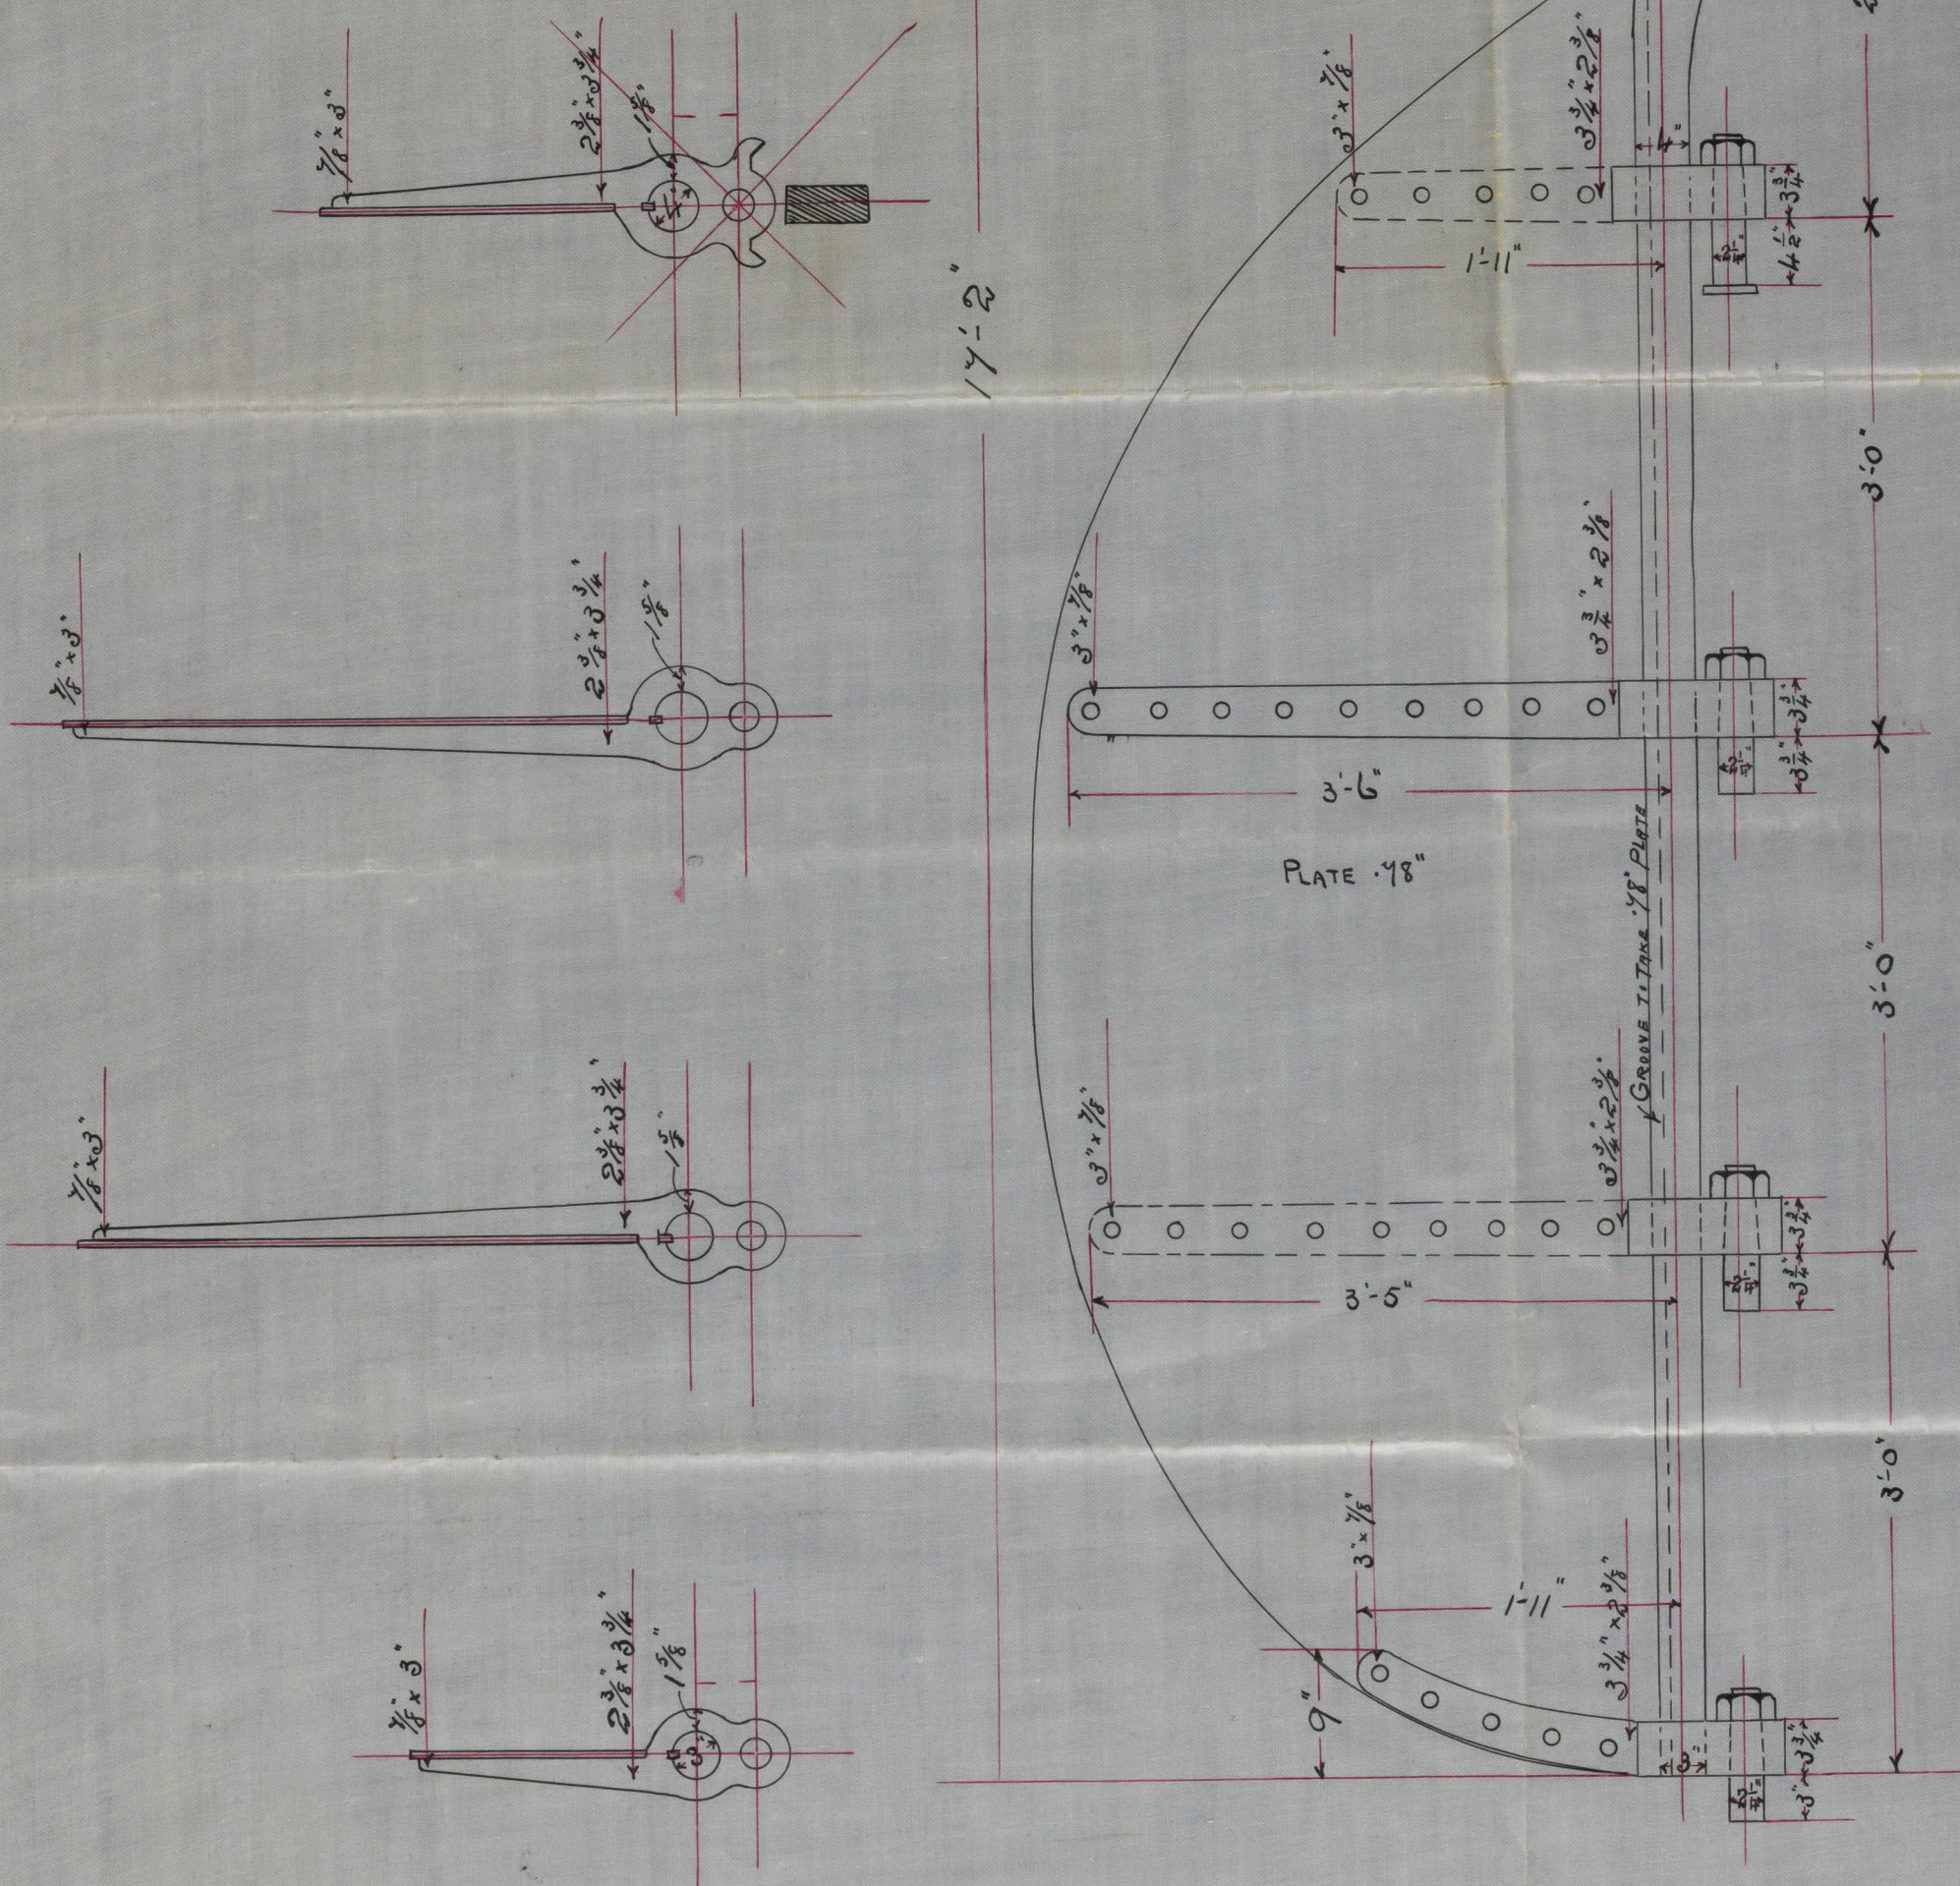

C.F.
30/10/09



© 2020

Lloyd's Register
Foundation

002165-002173-0080

002165-002173-0080