



# SS No 198 - 195 PROFILE & DECK PLAN DIMENSIONS 180'-0" x 28'-0" x 14'-6" M.L. SCALE 1/8" = 1'-0"

No 27 BULKHEAD PLATING 32" IN WAY OF TANK  
 28 AT DECK STIFFENED WITH 7-3-30 BA.  
 SPACED VERTICALLY 24" APART  
 SINGLE FRAMES 5-3-35 BACK 32-32-32  
 BRACKETS AT DECK ONLY


No 32 BULKHEAD PLATING 30" AT DOUBLE BOTTOM  
 26 AT DECK STIFFENED WITH 7-3-38 BA  
 SPACED 30" APART VERTICALLY  
 WITH BRACKETS TO DECK.

P.P. MAST SUPPORTED TO  
 SUPERVISOR'S SATISFACTION

No 88 BULK PLATING 30" IN WAY OF TANK  
 26 AT DECK STIFFENED WITH 5-3-40 ANGLES  
 SPACED 24" VERTICALLY WITH BRK'S AT DECK ONLY  
 BEAM 3-3-30 SINGLE FRAME 4-4-42

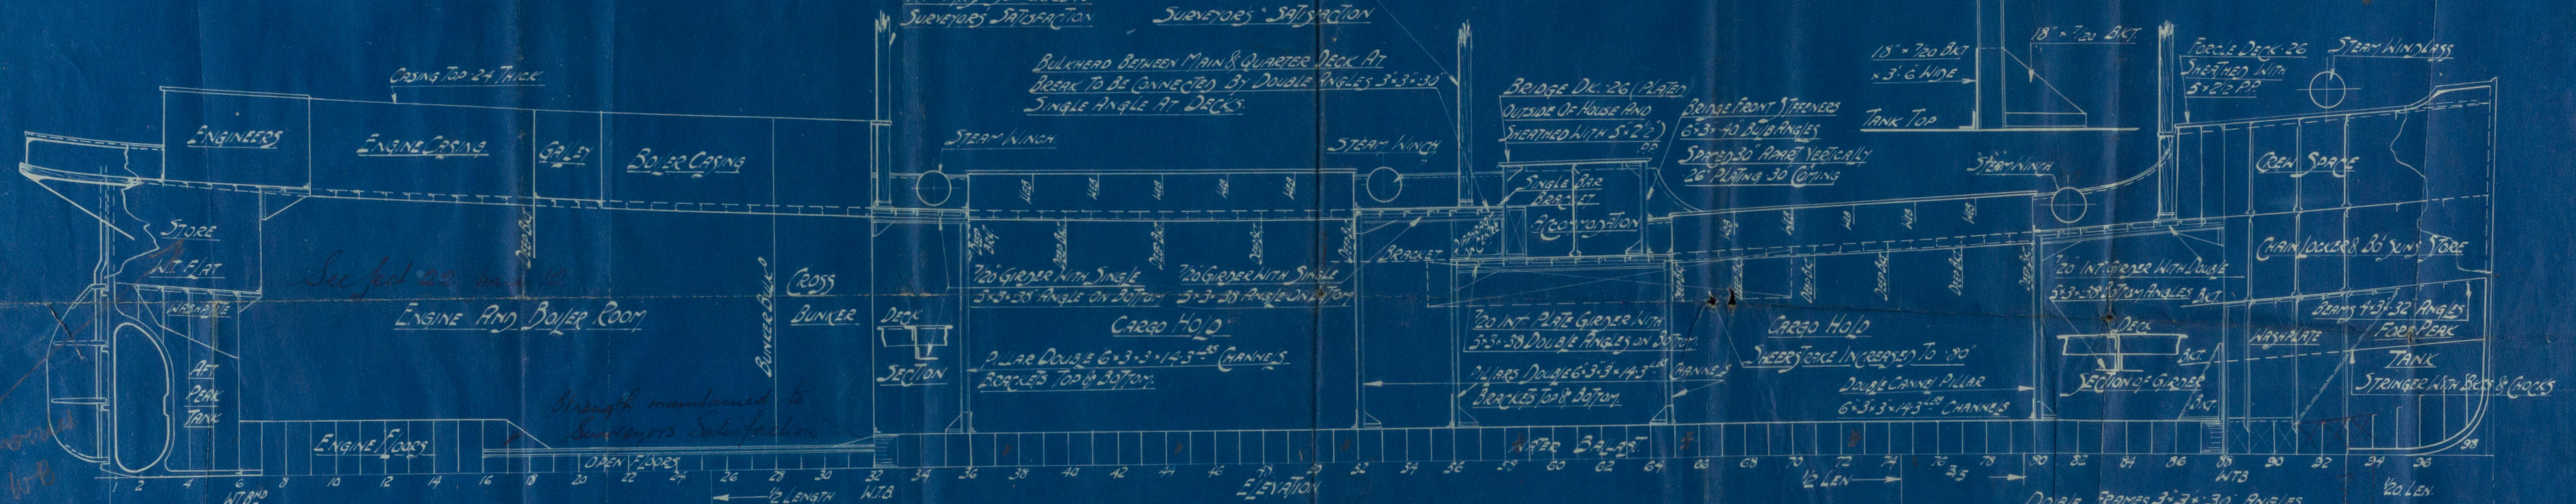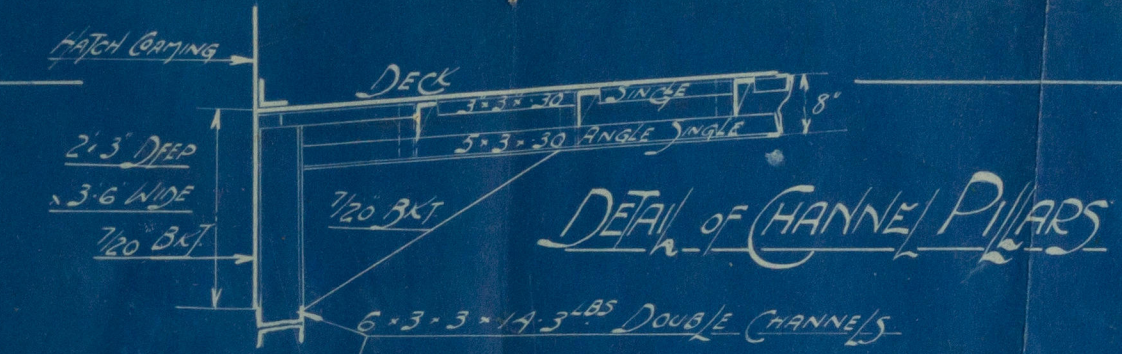

## HAIF DECK PLAN

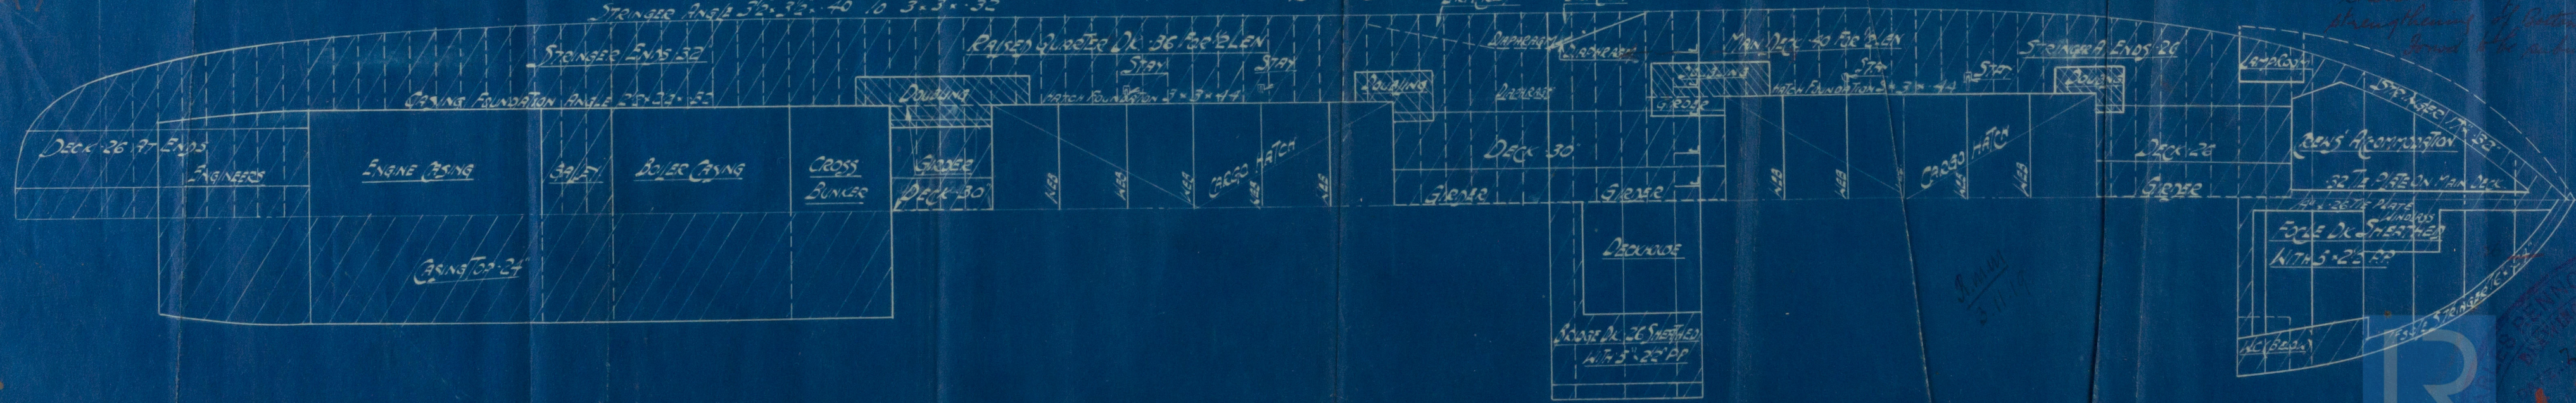

Sketch showing  
 strengthening of bottom  
 around the bulkhead





C Remondson & Co  
198-195


Profile & Deck Plans

M.M. HOLLERNOK

EX.

WESTOWN

EX

S/S CHANNEL QUEEN   
NEWCASTLE ON TYNE.

Report No. 144885

N.S. "Samia"

© 2020

Report No. 144162

Lloyd's Register  
Foundation

002465-002173-0121