

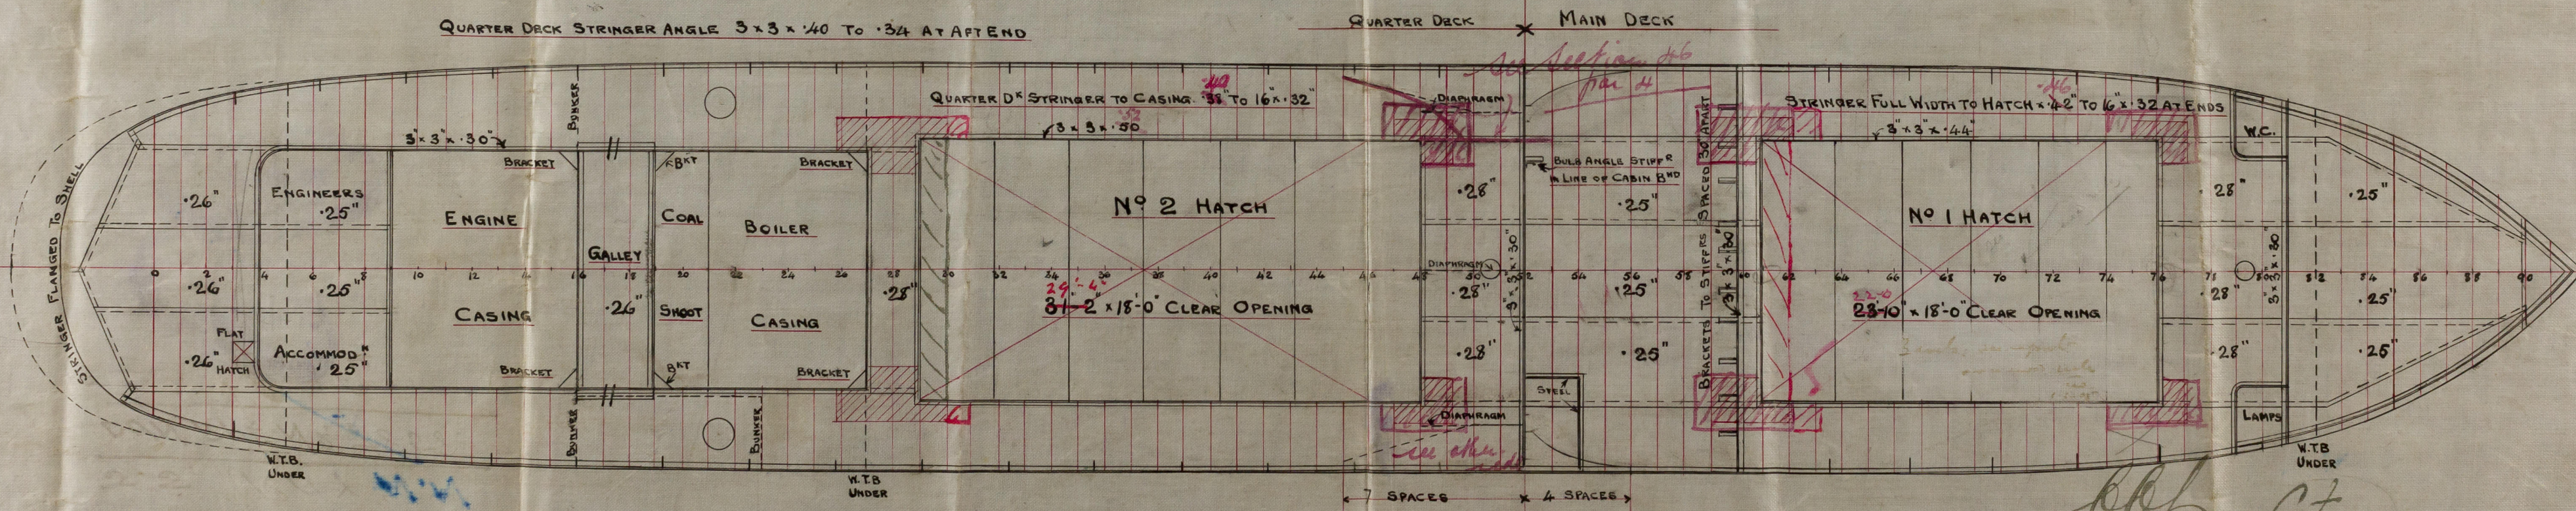


DIMENSIONS 170'-0" B.P. x 29'-0" EXT. x 13'-6" ML.D. TO MAIN DK
TO CLASS 100A1 LLOYDS

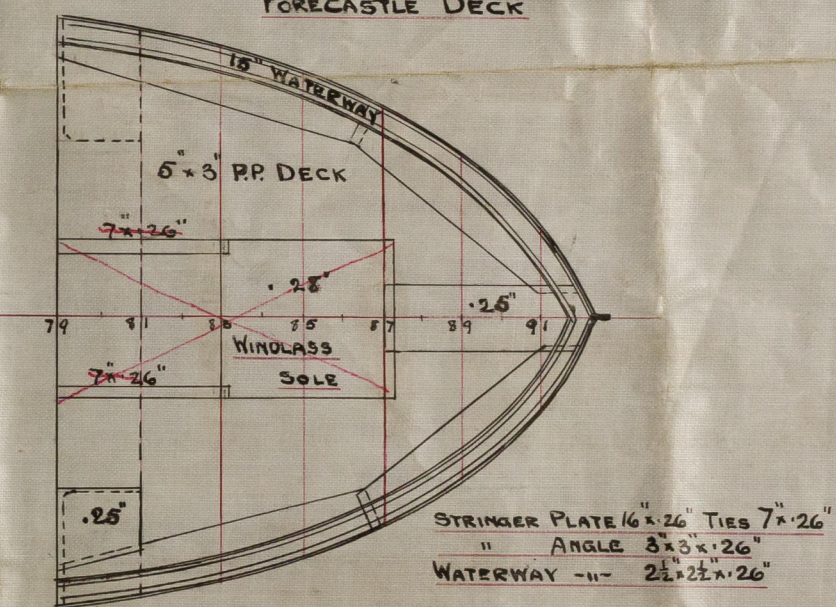

66. C.T.
25.3.14 23.3.14

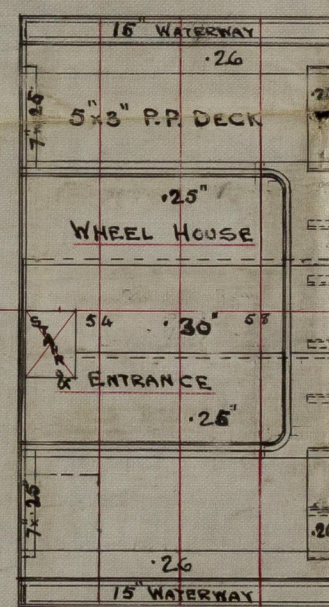

PROFILE & DECK PLANS

DUNDEE S.B. C^o LTD

N^o 271


S.S. "RAY" W.N.

DUN. RPT N^o 7858.

Macville

RECEIVED
29 MAY 1914





LONDON

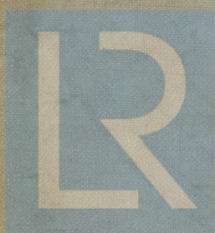



© 2020

Lloyd's Register
Foundation

002165-002173-0212

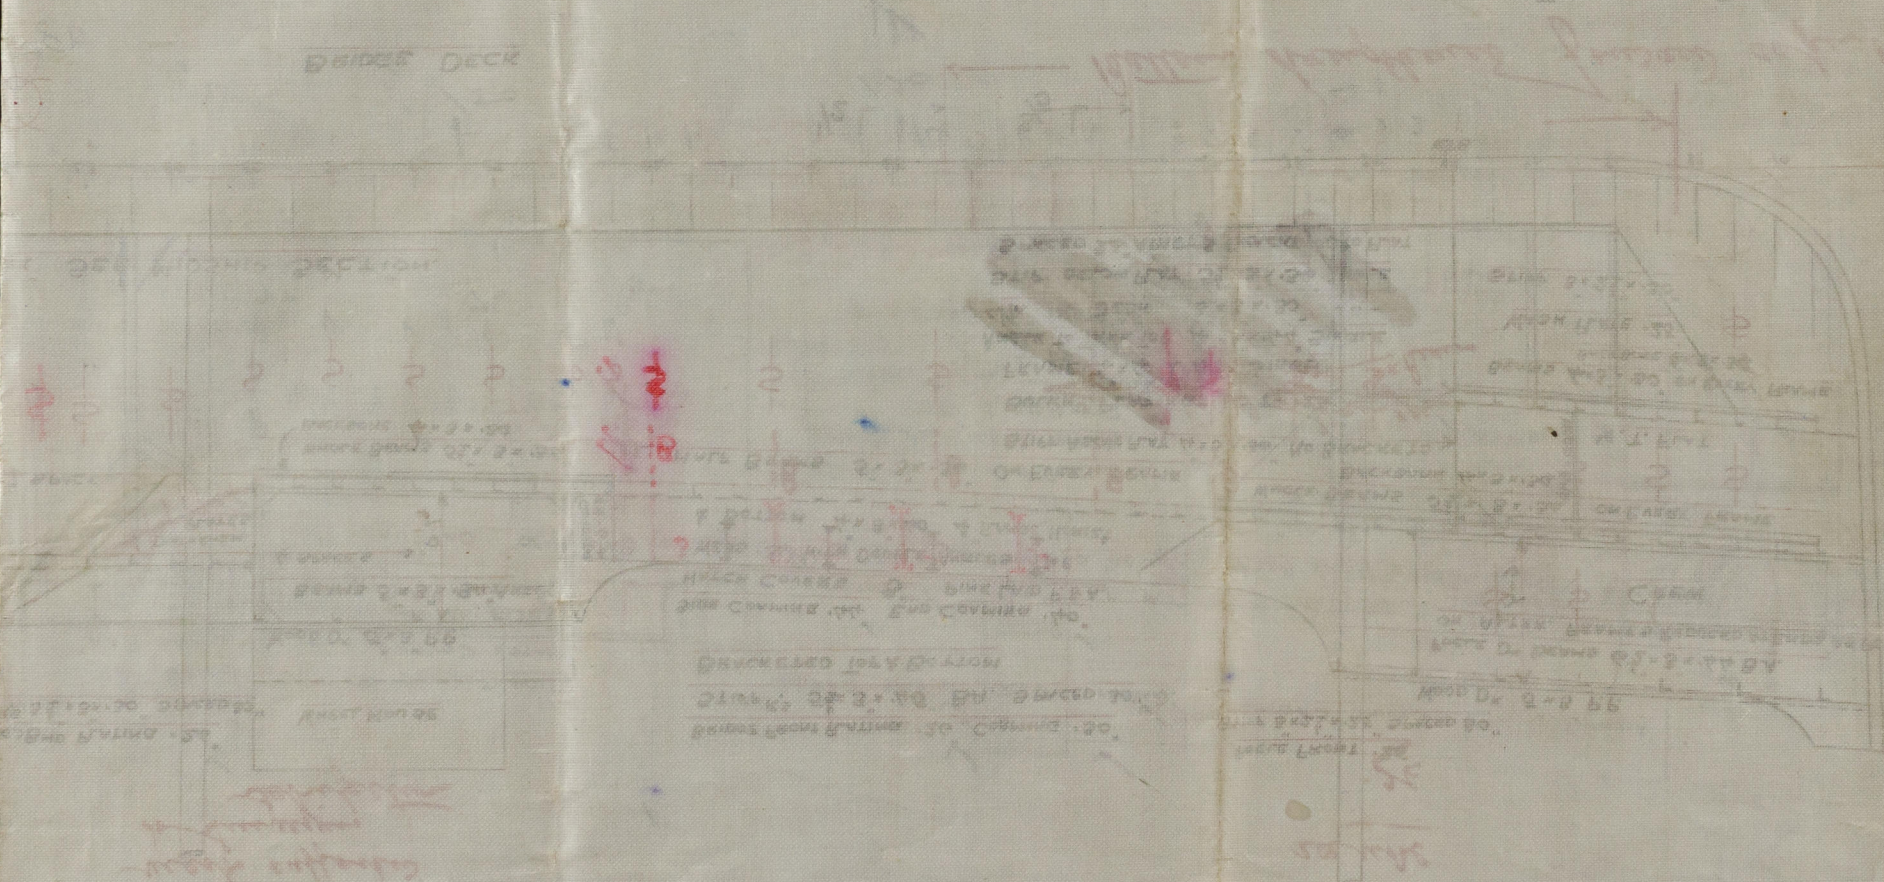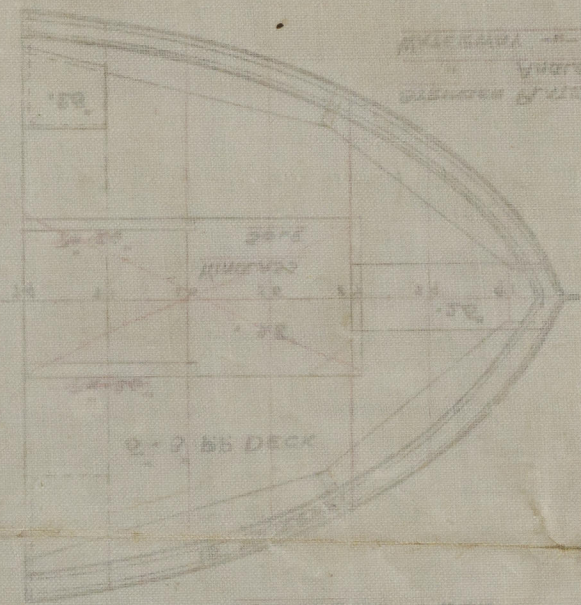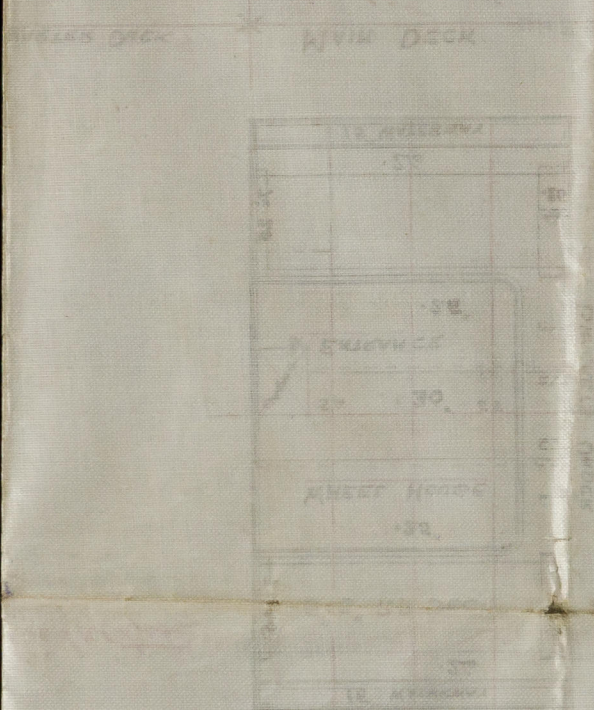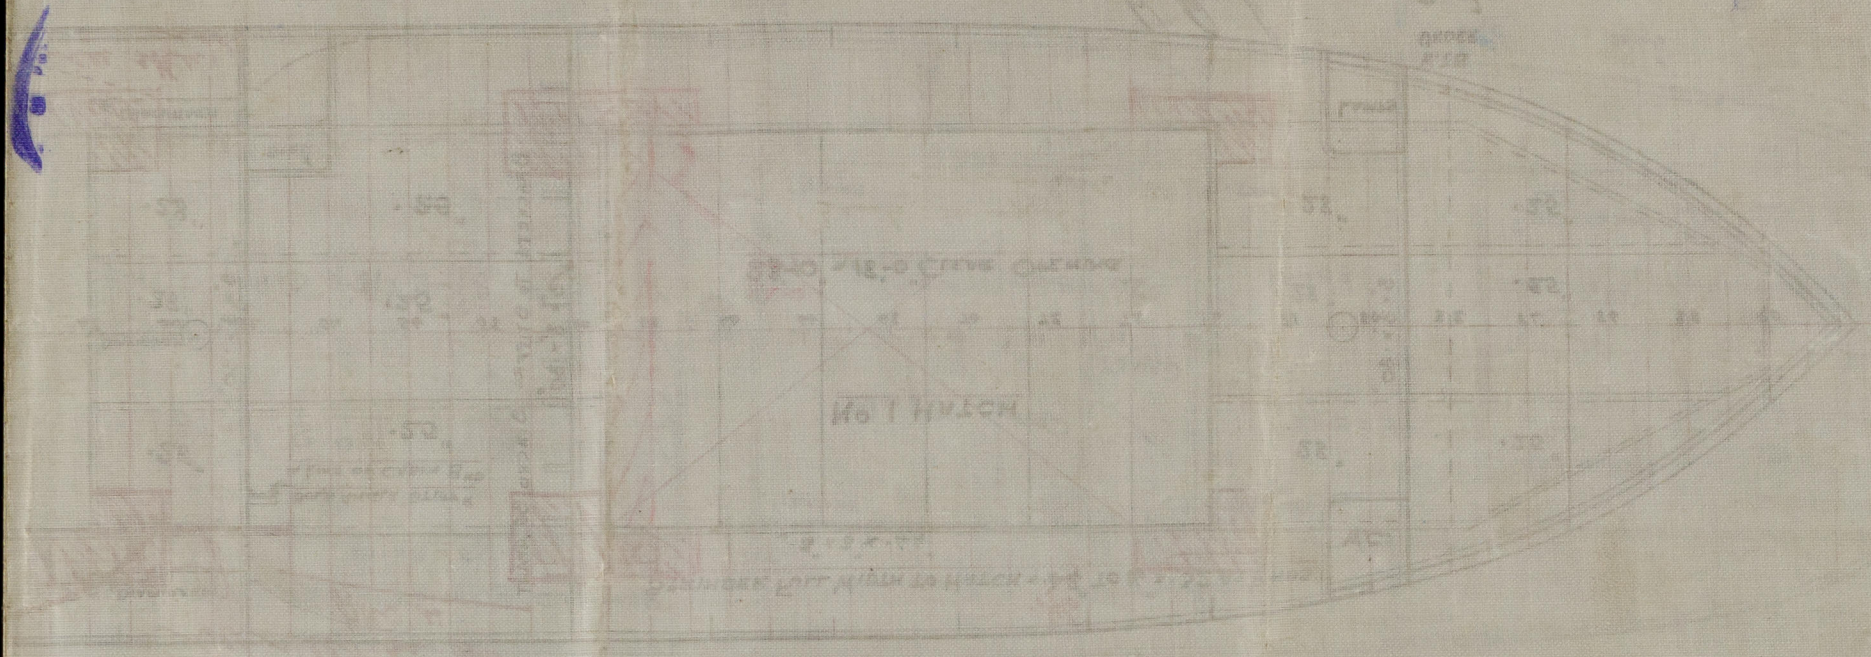

PLAN OF THE
BRIDGE DECK
SCALE 1/4" = 1'-0"

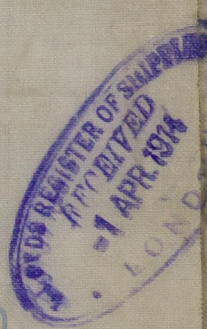 

© 2010
Lloyd's Register
Foundation