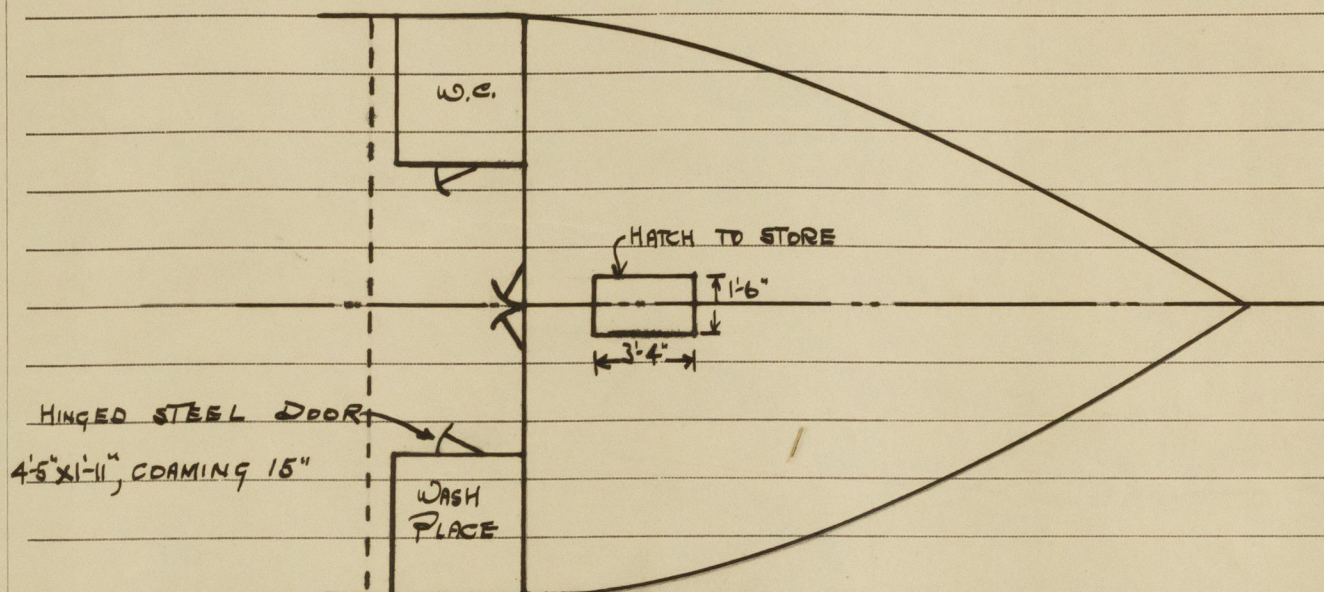


## Lloyd's Register of Shipping.

Ship's Name S.S. "MACVILLE"

Official No. 136753

Memorandum of alterations reported since ship was surveyed for assignment of Load Lines  
in 1/19/5

PLAN OF FO'CLE.ALTERATIONS.

Hatch to chain locker plated over.

Hatch to store plated over and new hatch fitted as shown in above sketch.

Particulars of new hatch

Dimensions 3'-4" x 1'-6"

Coaming 10" x 3/8"

Wood cover 2 1/2"

Plats, battens &amp; tarpaulin supplied.

Hinged steel door to crew's workplace :- Door increased in size from 4'-0" x 1'-11" to 4'-5" x 1'-11" and coaming altered from 18" to 15".

A copy of the above has now been placed on board ship.

J. H. Tait,

Sept., 1950.

G. H. W.

10 OCT 1950