

MIDSHIP SECTION


DIMENSIONS:- 140'-0" BP x 25'-0" MLD x 13'-0" DEPTH MLD

STEEL.

$$\begin{array}{rcl} L & = & 140'-0'' \\ B+D & = & 38'-83 \\ d & = & 12'-41 \\ L \times (B+D) & = & 5436'-20 \\ \frac{1}{D} & = & 10'-12 \end{array}$$

NUMERAL FOR RUDDER = 73. SPEED ¹⁰/₁₂ KNOTS.

1	ANCHOR	8½ CWT	STOCKLESS.
1	"	8½ "	"
1	"	3½ "	EX STOCK
1	80 FATHOMS	1½"	STUD LINK CABLE
60	"	7"	HAWSER
60	"	5½"	WARP

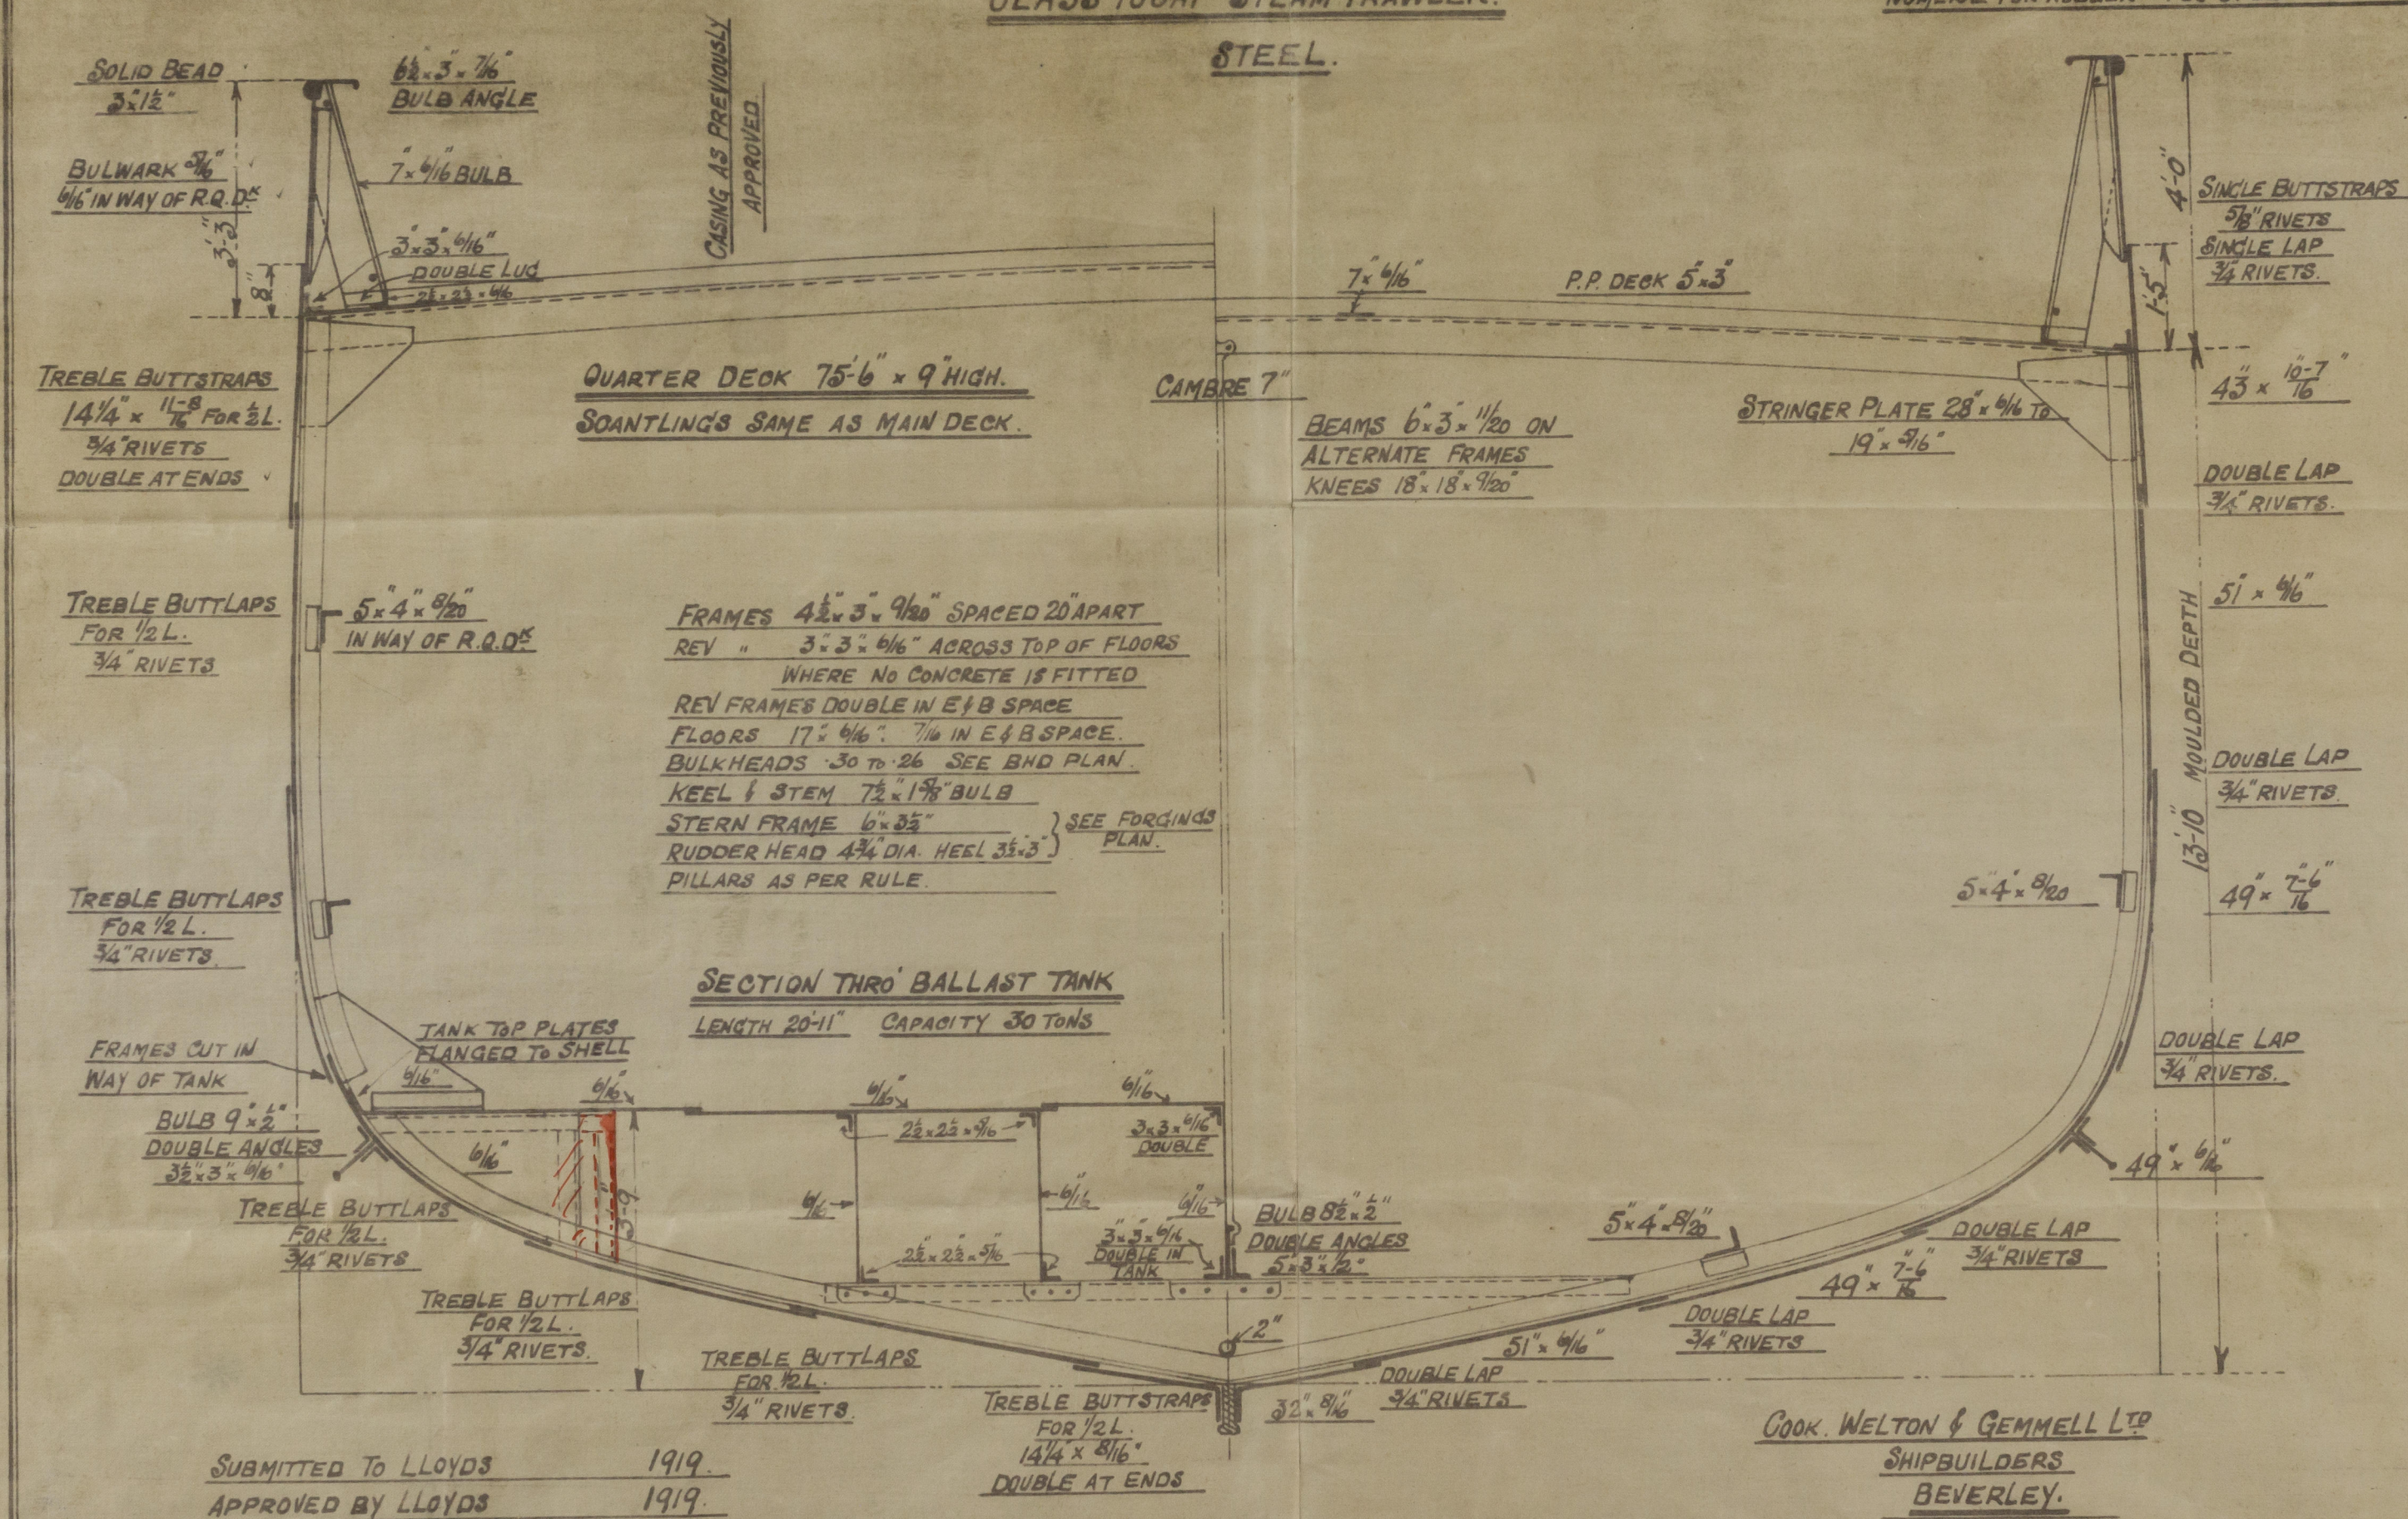

© 2020
29.3.19.
Lloyd's Register
Foundation
002174-002183-0002

MIDSHIP SECTION

COOK WELTON & GEMMELL LTD

N^{os} 370 & 423

N^o 425

S/s. April. Hull R/bk. 31822.



Mai - -

31913

- Kari Solumundarson
3204)



© 2020

Lloyd's Register
Foundation

002174-002183-0002