

SHIPS N° 76-7

MIDSHIP SECTION


TO LLOYDS 100 A.I. ✱

DIMENSIONS 220'0" x 35'0" x 15'10" MLD

SCALE 1/2" = 1 FOOT

391
J.B.C.
21.8.19.


EQUIPMENT	LETTER 'N'	ERECTIONS	LLOYDS NUMERALS
2 BOWER ANCHORS	25 CENTS STOCKLESS	RSD QR DK 77'2" x 3'5"	270.2 ✓
1 STREAM	G2 EXSTOCK	BRIDGE 59'5" x 7'0" x 7'5"	312.37 ✓
1 KEDGE	3/2	FO'LE 23'0" x 7'0" x 7'5"	120.75 ✓
210 FTHMS	1 1/8" STUD CHAIN CABLE	CASINGS ETC 63'50" x 7'0" x 5'0"	222.25 ✓
75	3/2" STREAM STEEL WIRE	385' x 7'0" x 5"	13.40 ✓
90	3/4" TOWLINE	LONGITUDINAL N°	1182.6 ✓
90	6" HAWSER	EQUIPMENT N°	12121.57 ✓
90	5" WARP		

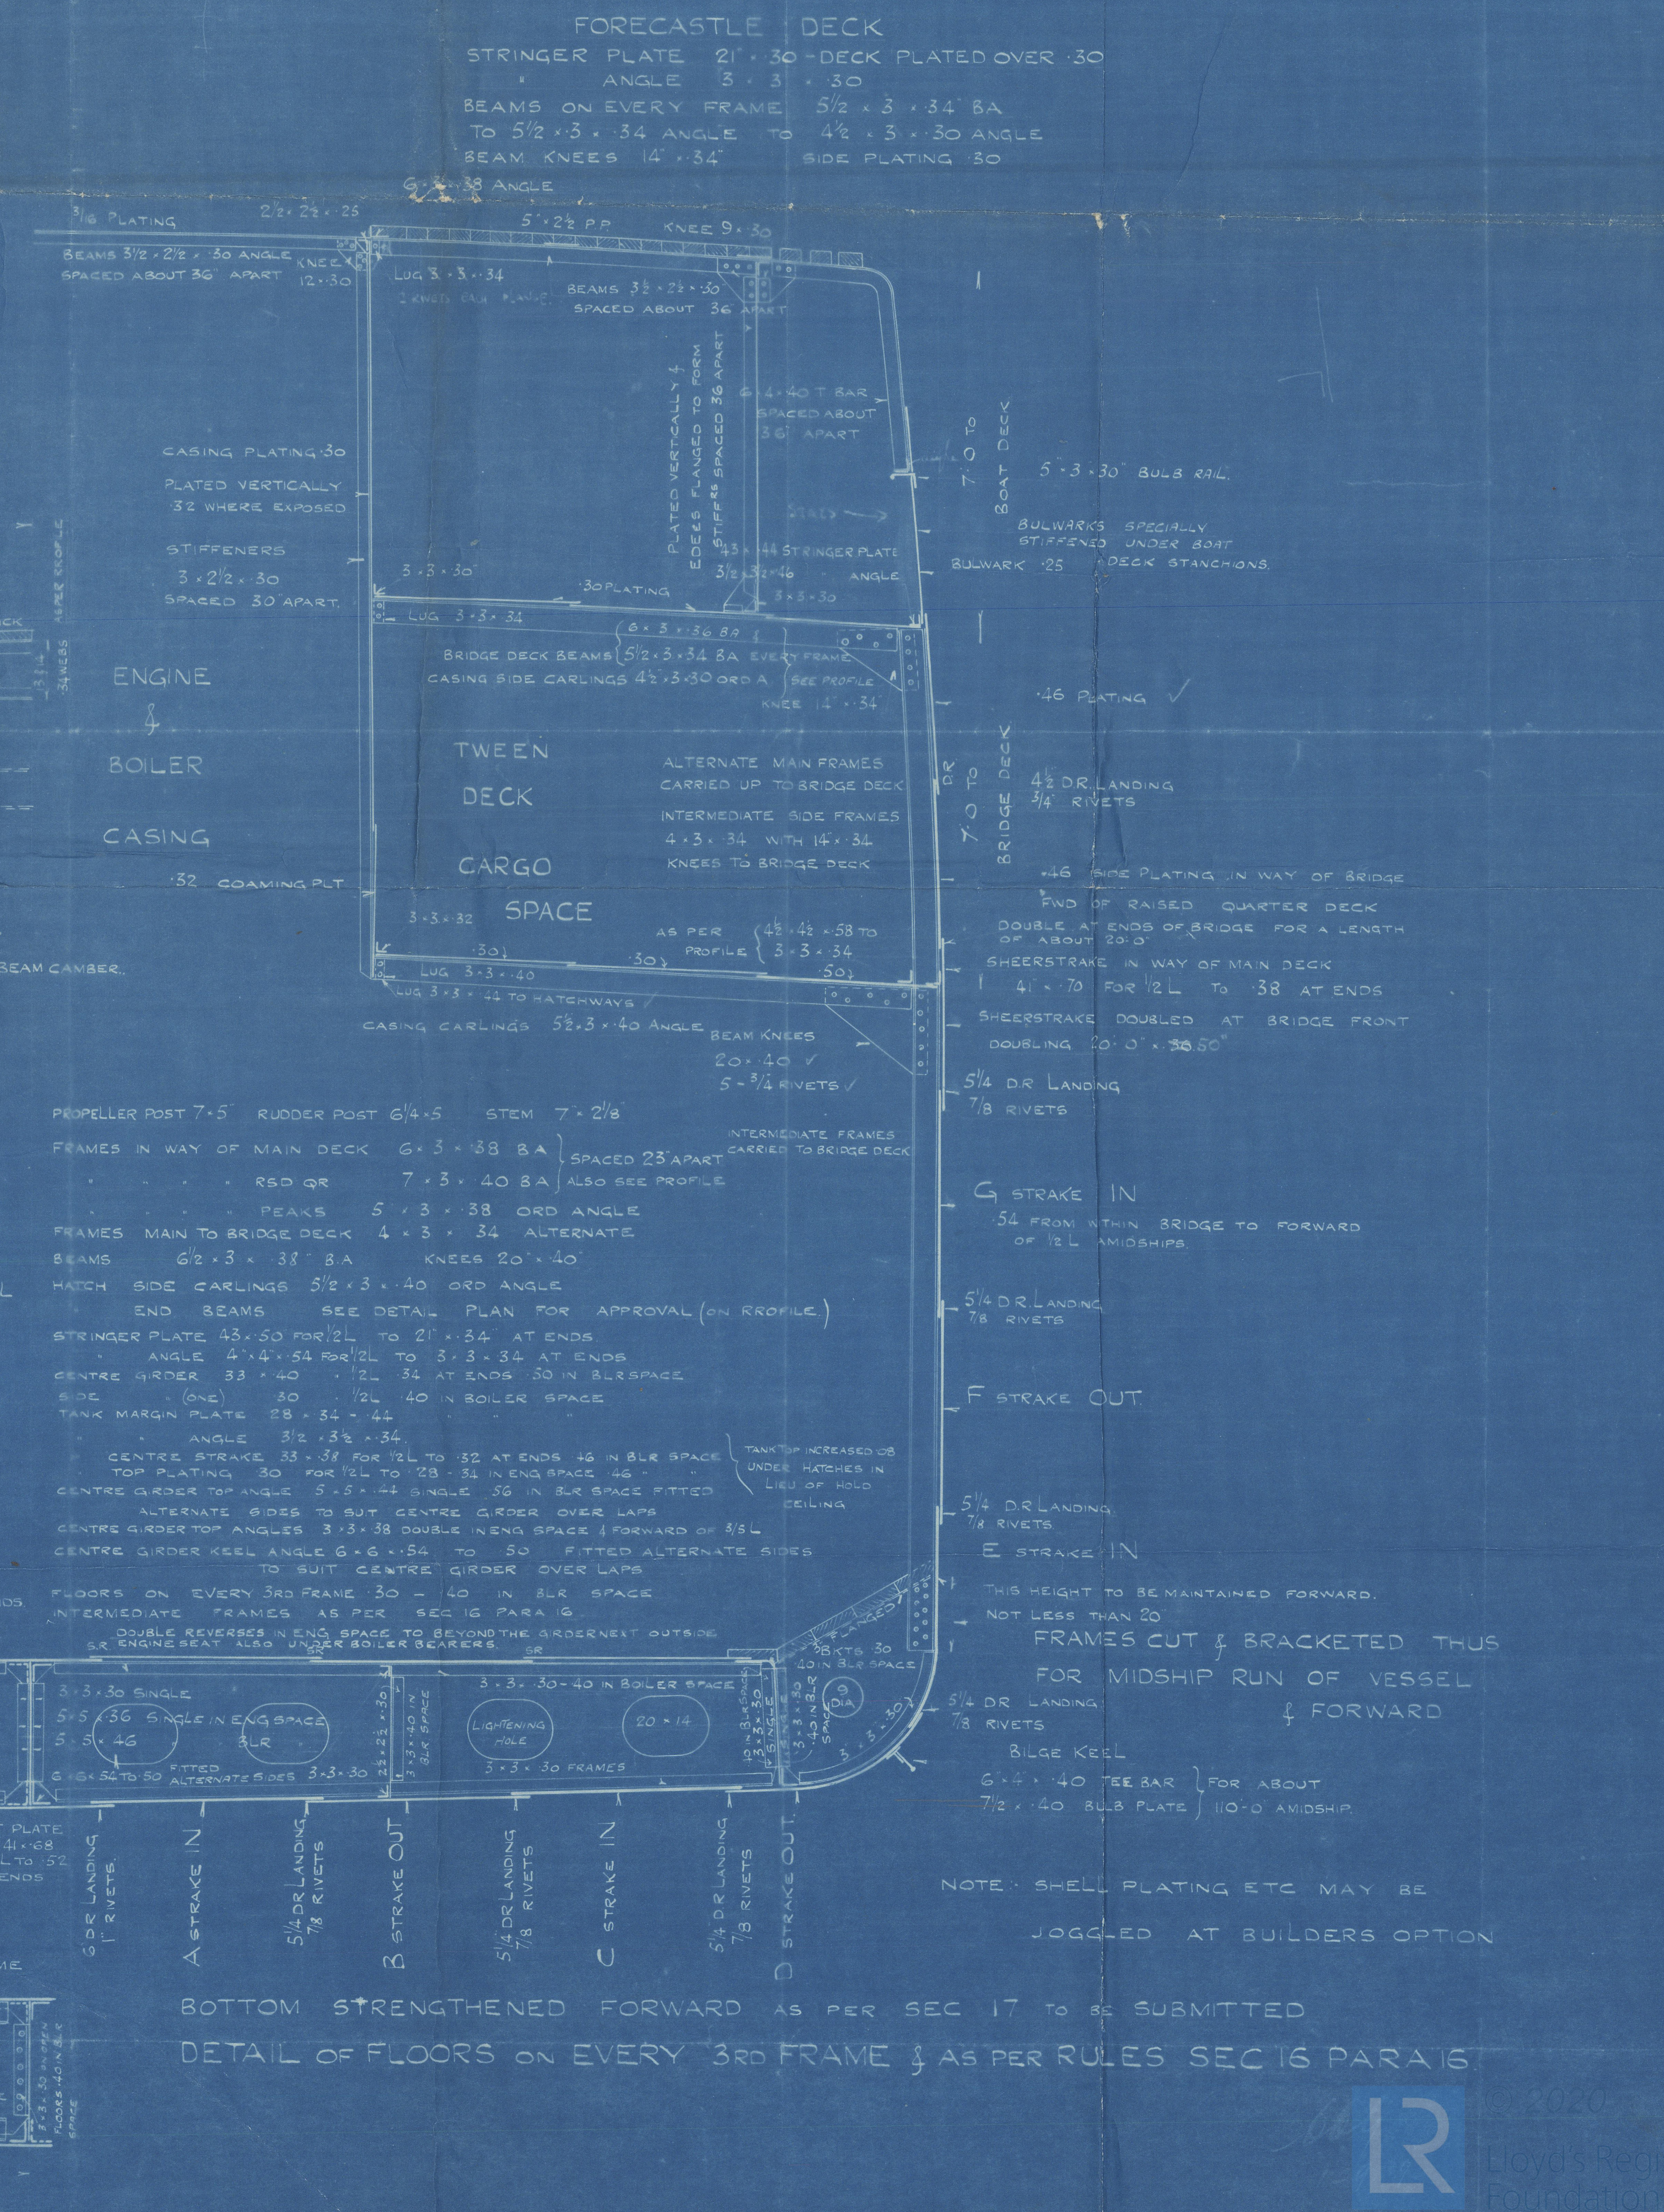

Cuse. S. B. boy 76/77

"
" *Majorca* "

Midship section

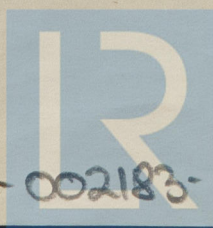

© 2020

002174-002183-0036

Lloyd's Register
Foundation