



19.27 (No 185)

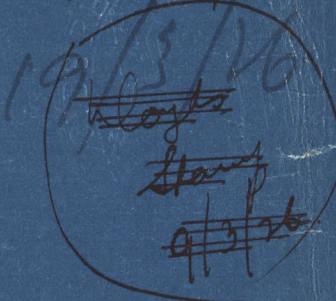

LLOYD'S NUMERALS.
B + D = 65
L x (B + D) = 18825
1/2 D (TRUNK TOP) = 13.93

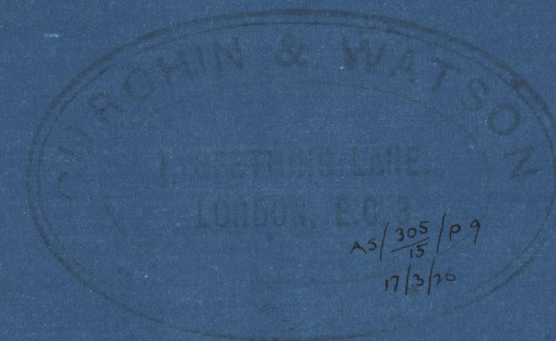







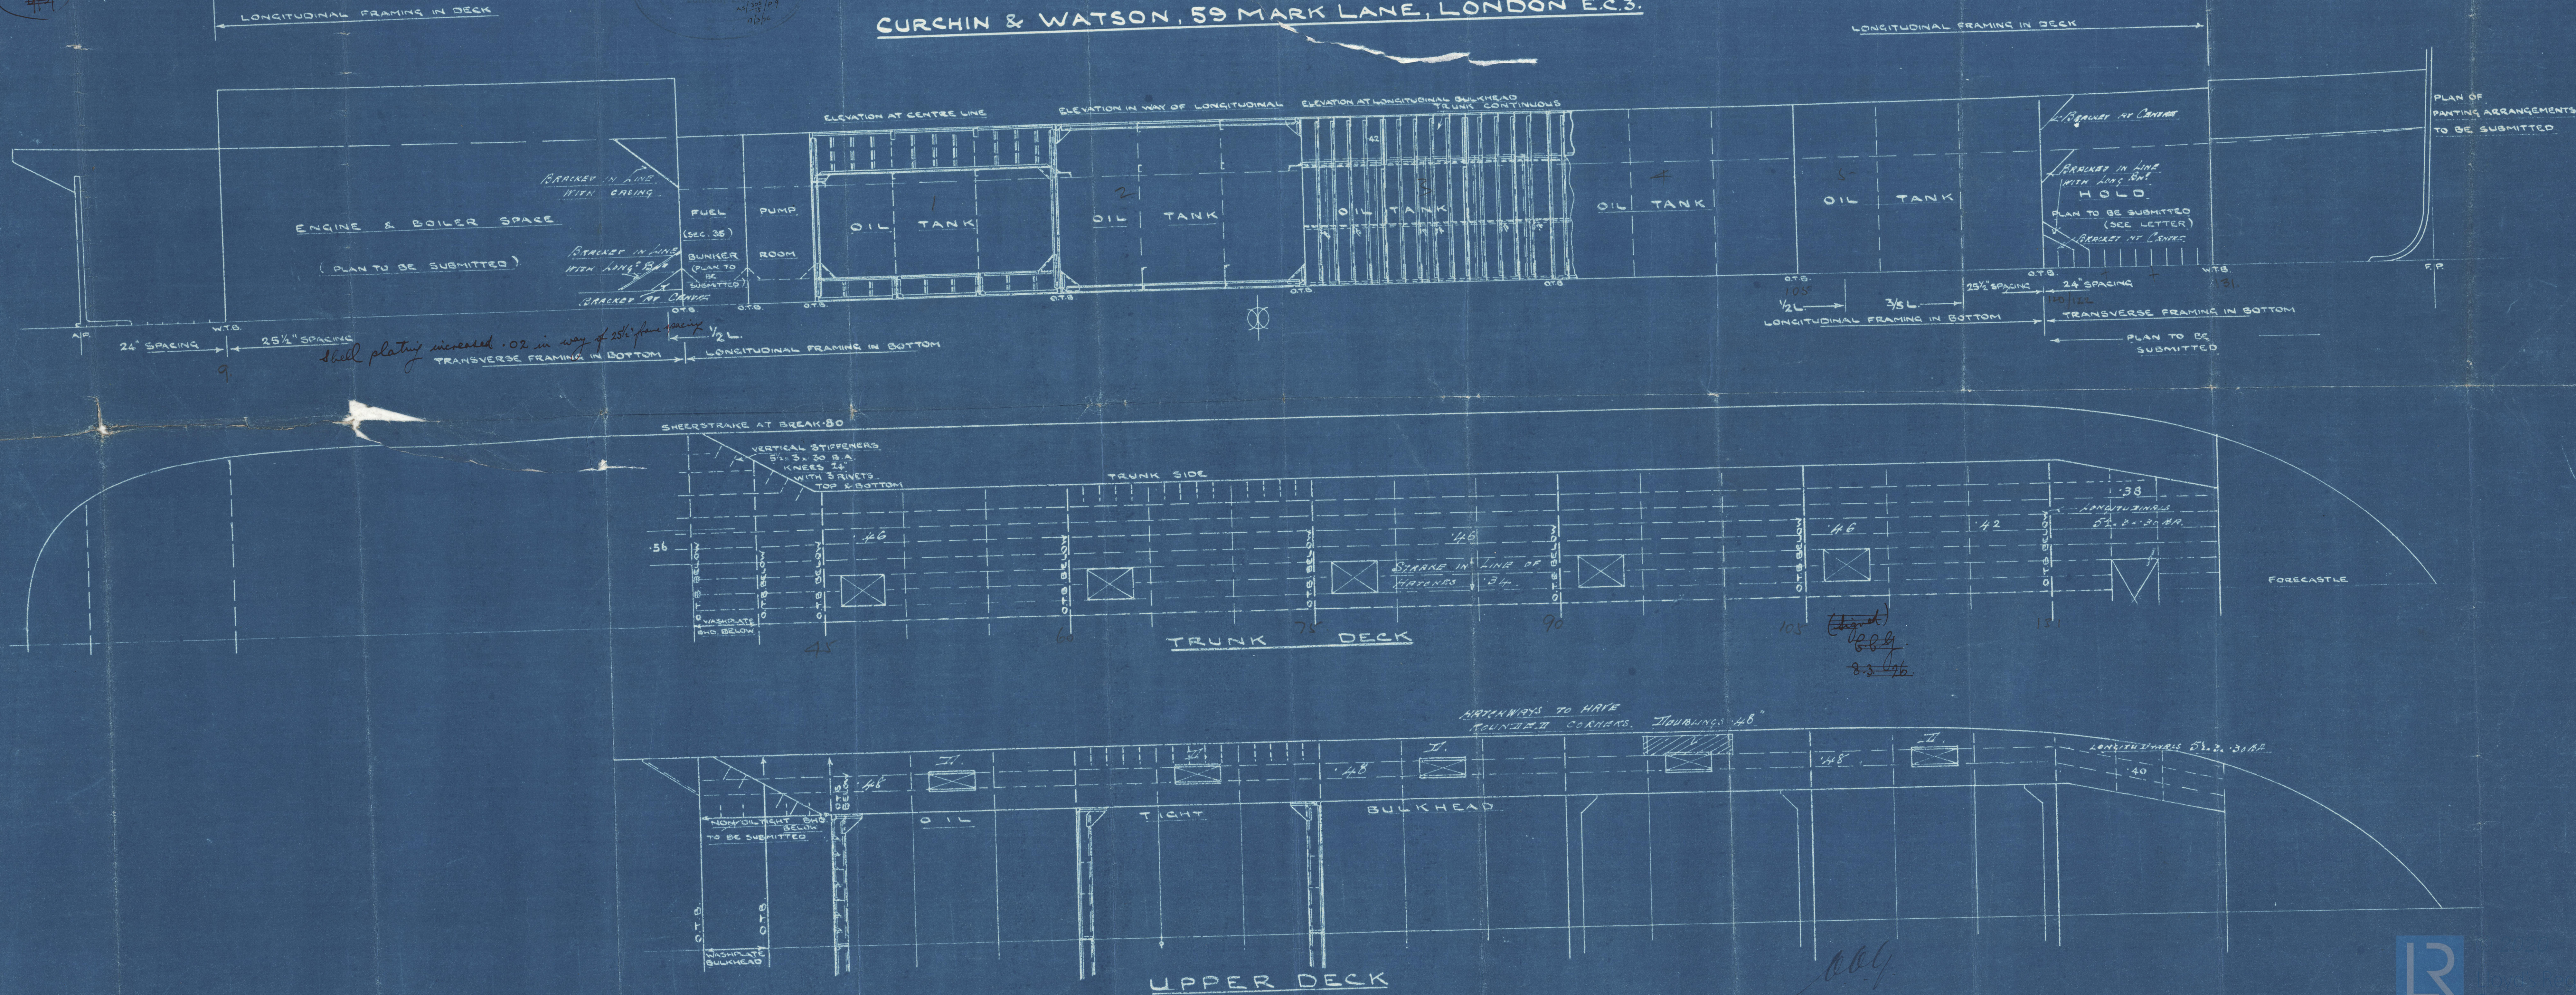

all
11.7.16

C.N.T. Nº 180

12

PROFILE & DECKPLANS

*Sp Lucita**

Trieste Report Nº

7333

(14) Recd from

Louison 24/1/27

L. L. Liseta

Trieste Rpt Nº 7634

C.N.T. 204

L. L. Leonor

Trieste Rpt Nº 8192

E. S. Liseta

MDA RPT. Nº 18129

Not Registered for 1917

wp 616



©2020

Lloyd's Register
Foundation

002174-002183-0112

Profile & Deckplans