


Sezione Maestra

Scala 1/2"=1'-0"

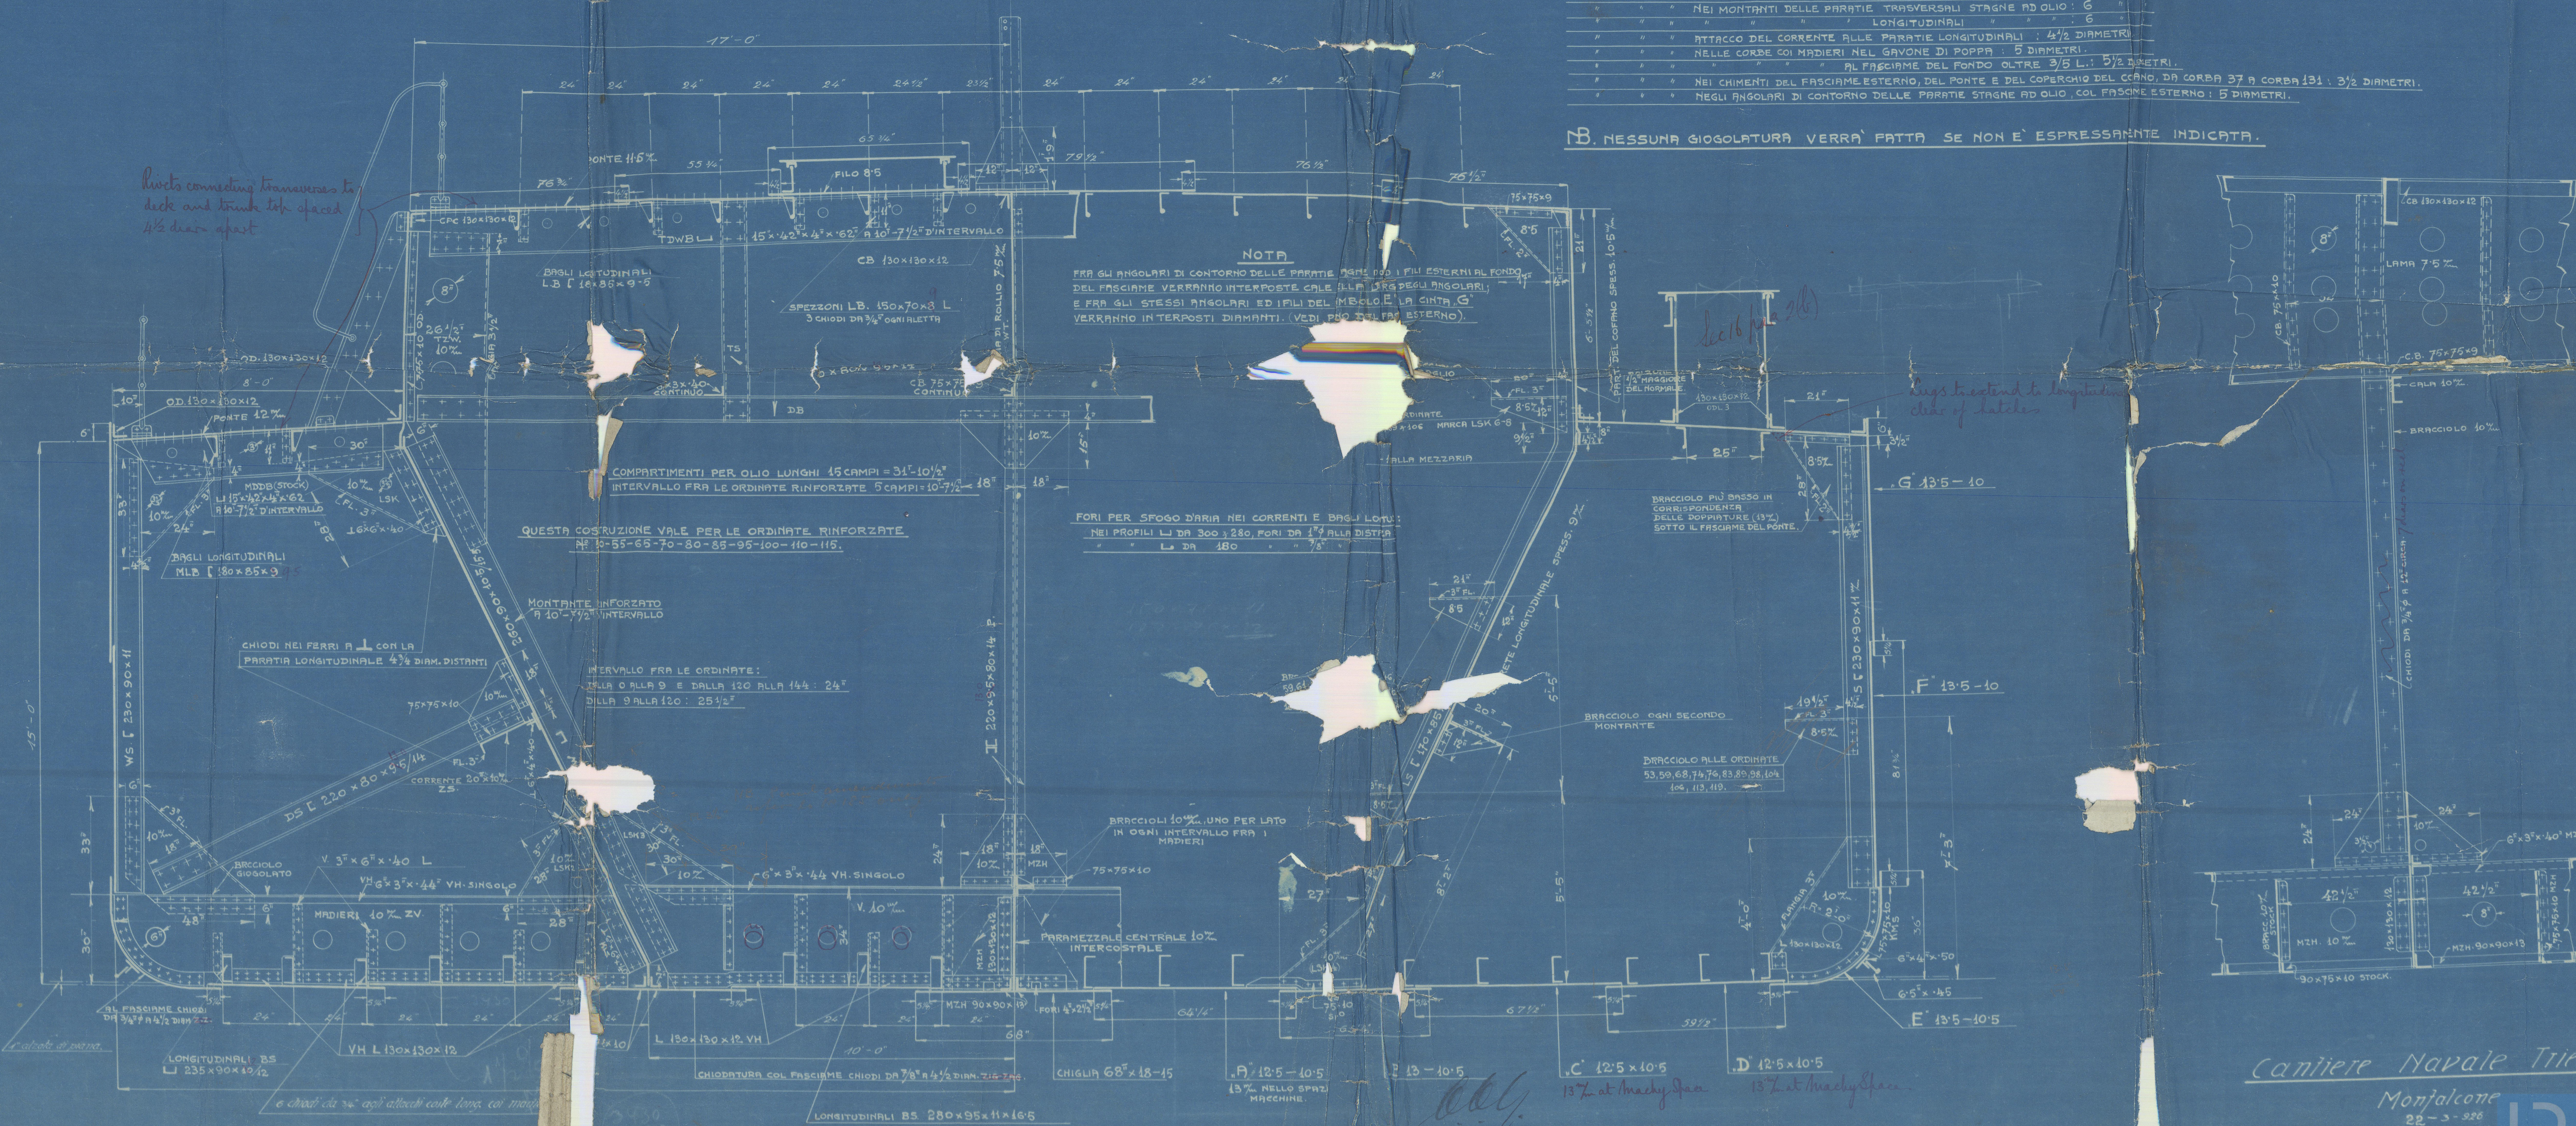

C. N. T. Moufaleau N^o 180

Approved Midship Section

002174-002183-0113



© 2020

Lloyd's Register
Foundation

180



Register
Foundation

2 - Midship Section

Sp. Luceta *

(July)

(September)
G. Ex

Trieste Report No 7333

(13) Rec'd from London 22/1/29

J. S. Liseta

Trieste Rpt No 7634



C. N. T. 204

L. Leonor

Trieste Rpt 188192

C. N. 797

See also report in Sec.

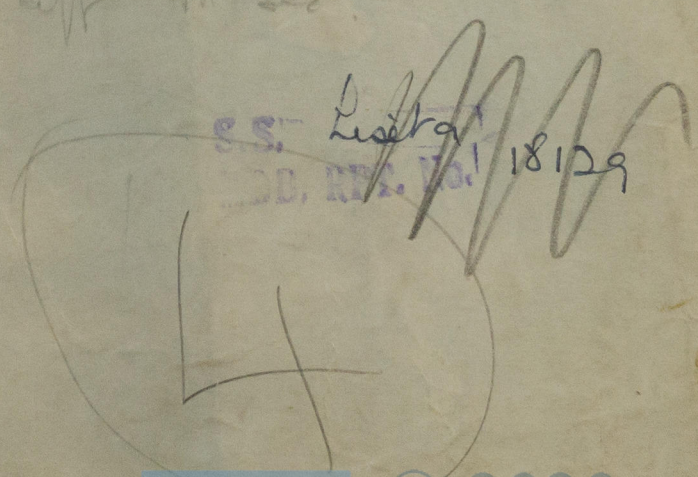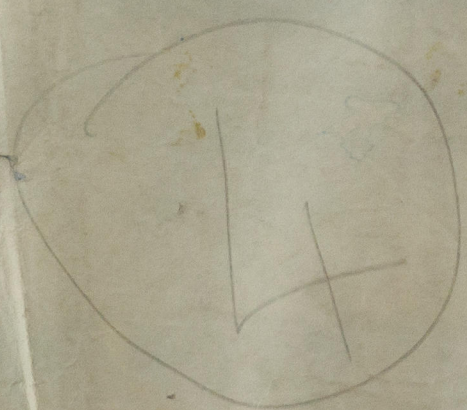

00274-002183-0113



© 2020

Lloyd's Register
Foundation