



MINIMUM SCANTLINGS REQUIRED

SHIP NOS 630-1.

FORGED IRON STERN FRAME.

SCALE:- 1" = 1 FT.

L x D = 1599.

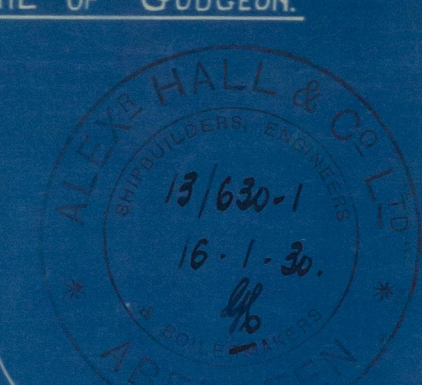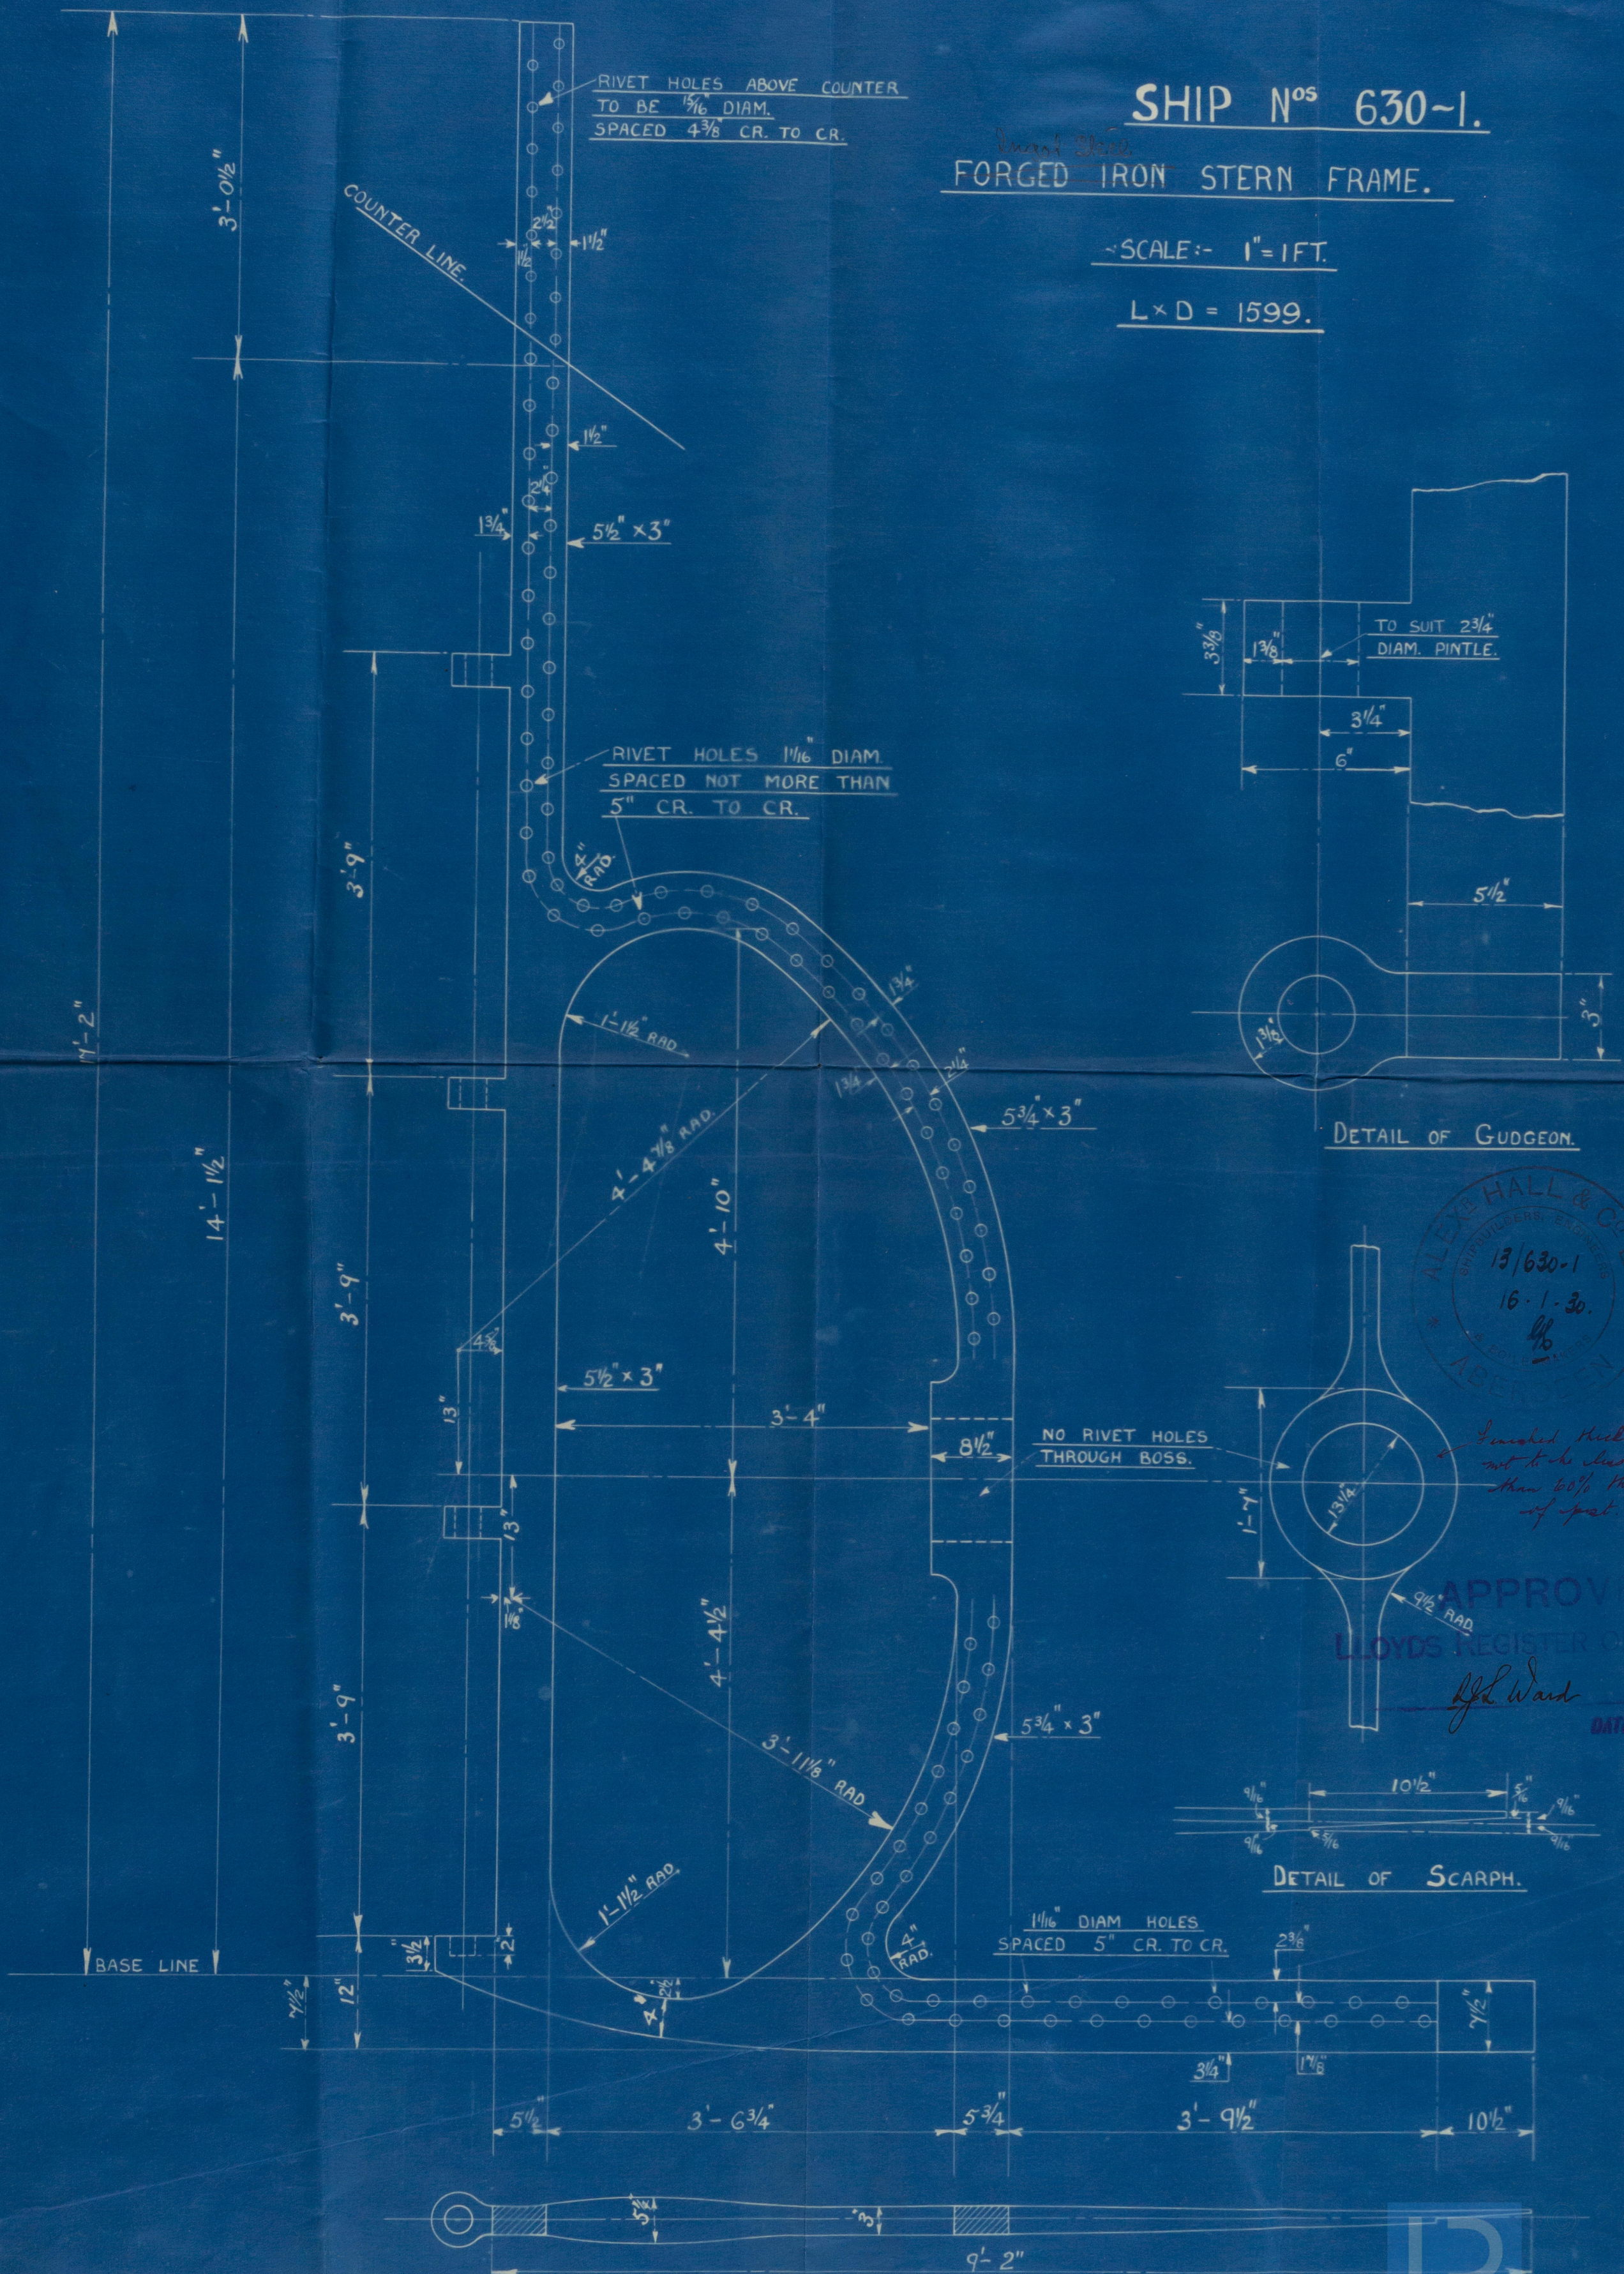

APPROVED  
LLOYDS REGISTER OF SHIPPING  
J. L. Ward  
DATE 27.1.30



002174-002183-0103



N<sup>os</sup> 630 - 631.

Slèn Frame.

A. Hall & Co. Ld.

Sc. K. 630 = MARY A. HASTIE.

abn. Report = 16243.

Sc. K. 631 = MARJORY M. HASTIE

abn. Report = 16244.



© 2020

Lloyd's Register  
Foundation

002174-002183-0213