

SHIP N<sup>o</sup>s 630-1.


RUDDER PLAN.

SCALE: 1" = 1 FT.



A x D = 72.24

SPEED NOT EXCEEDING 10 KNOTS.


MINIMUM SCANTLINGS REQUIRED

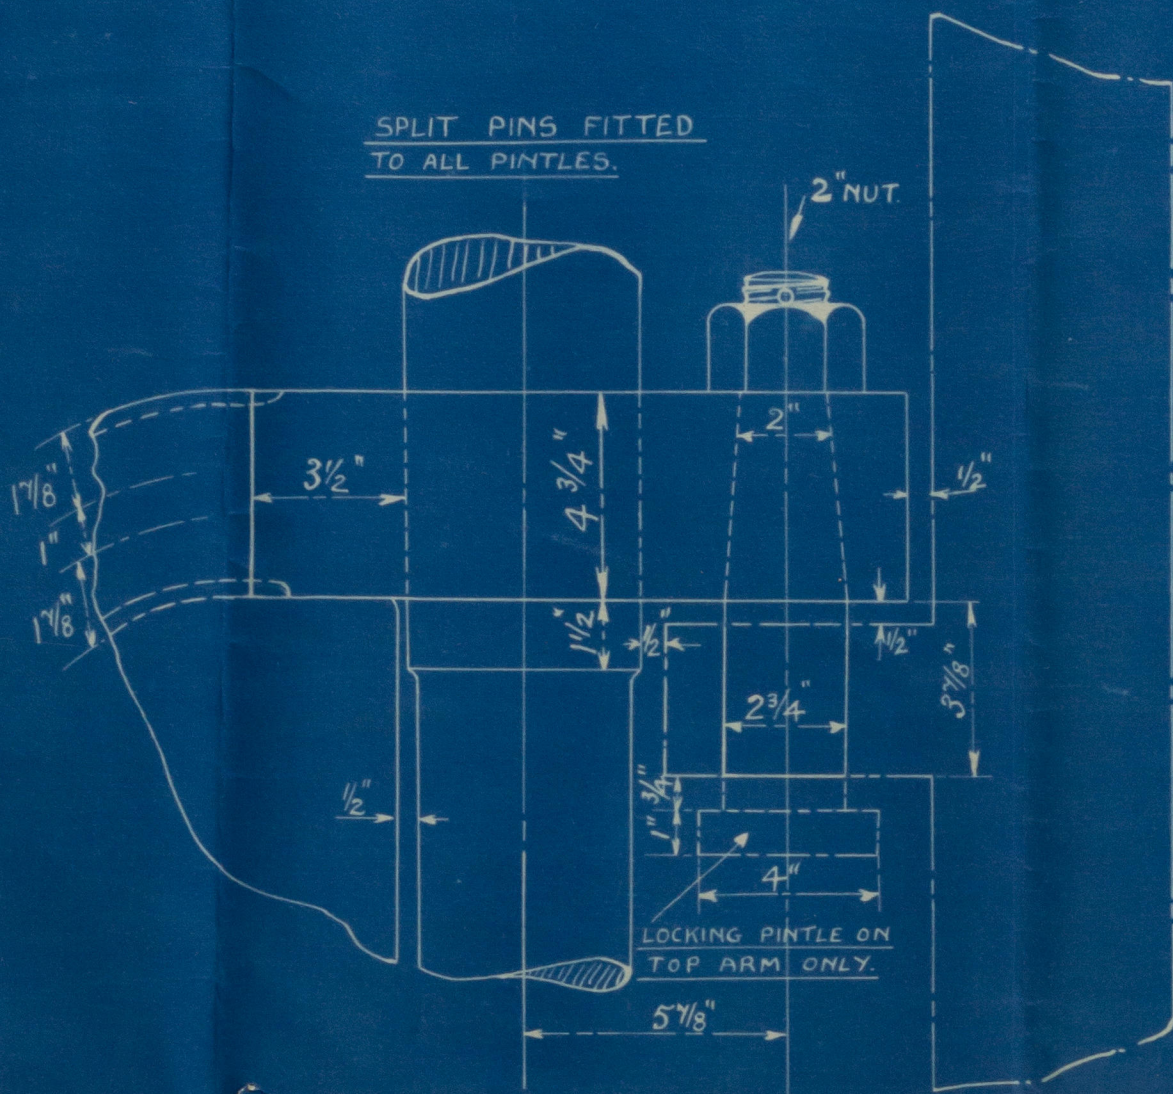

DETAIL OF PINTLES.

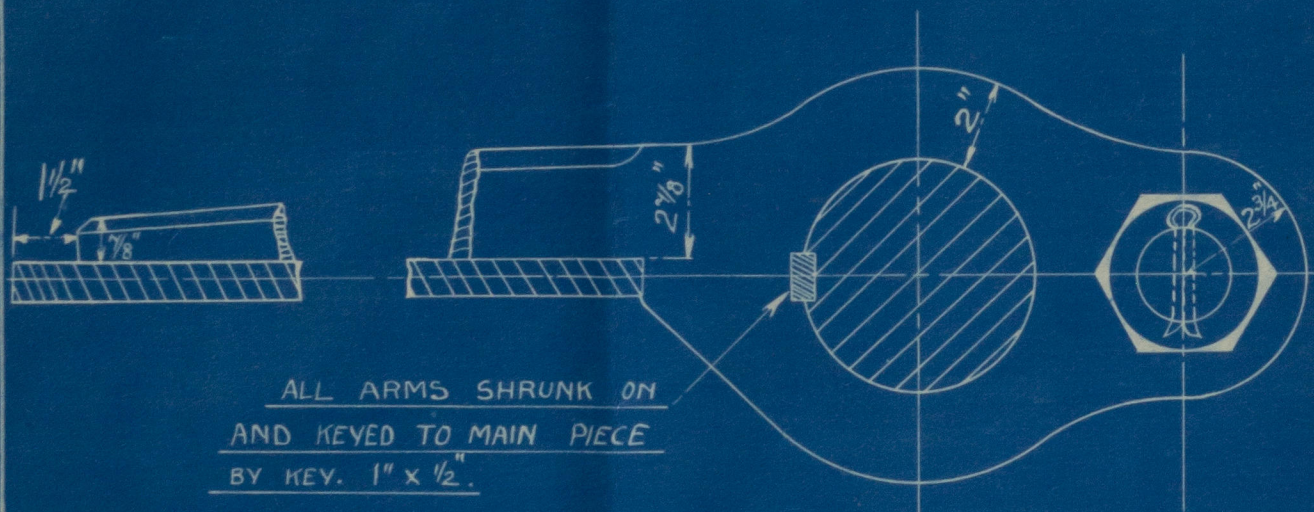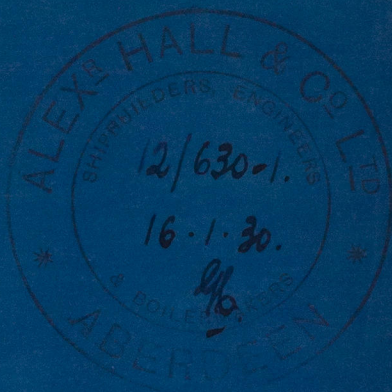

PLAN DETAIL OF ARMS.

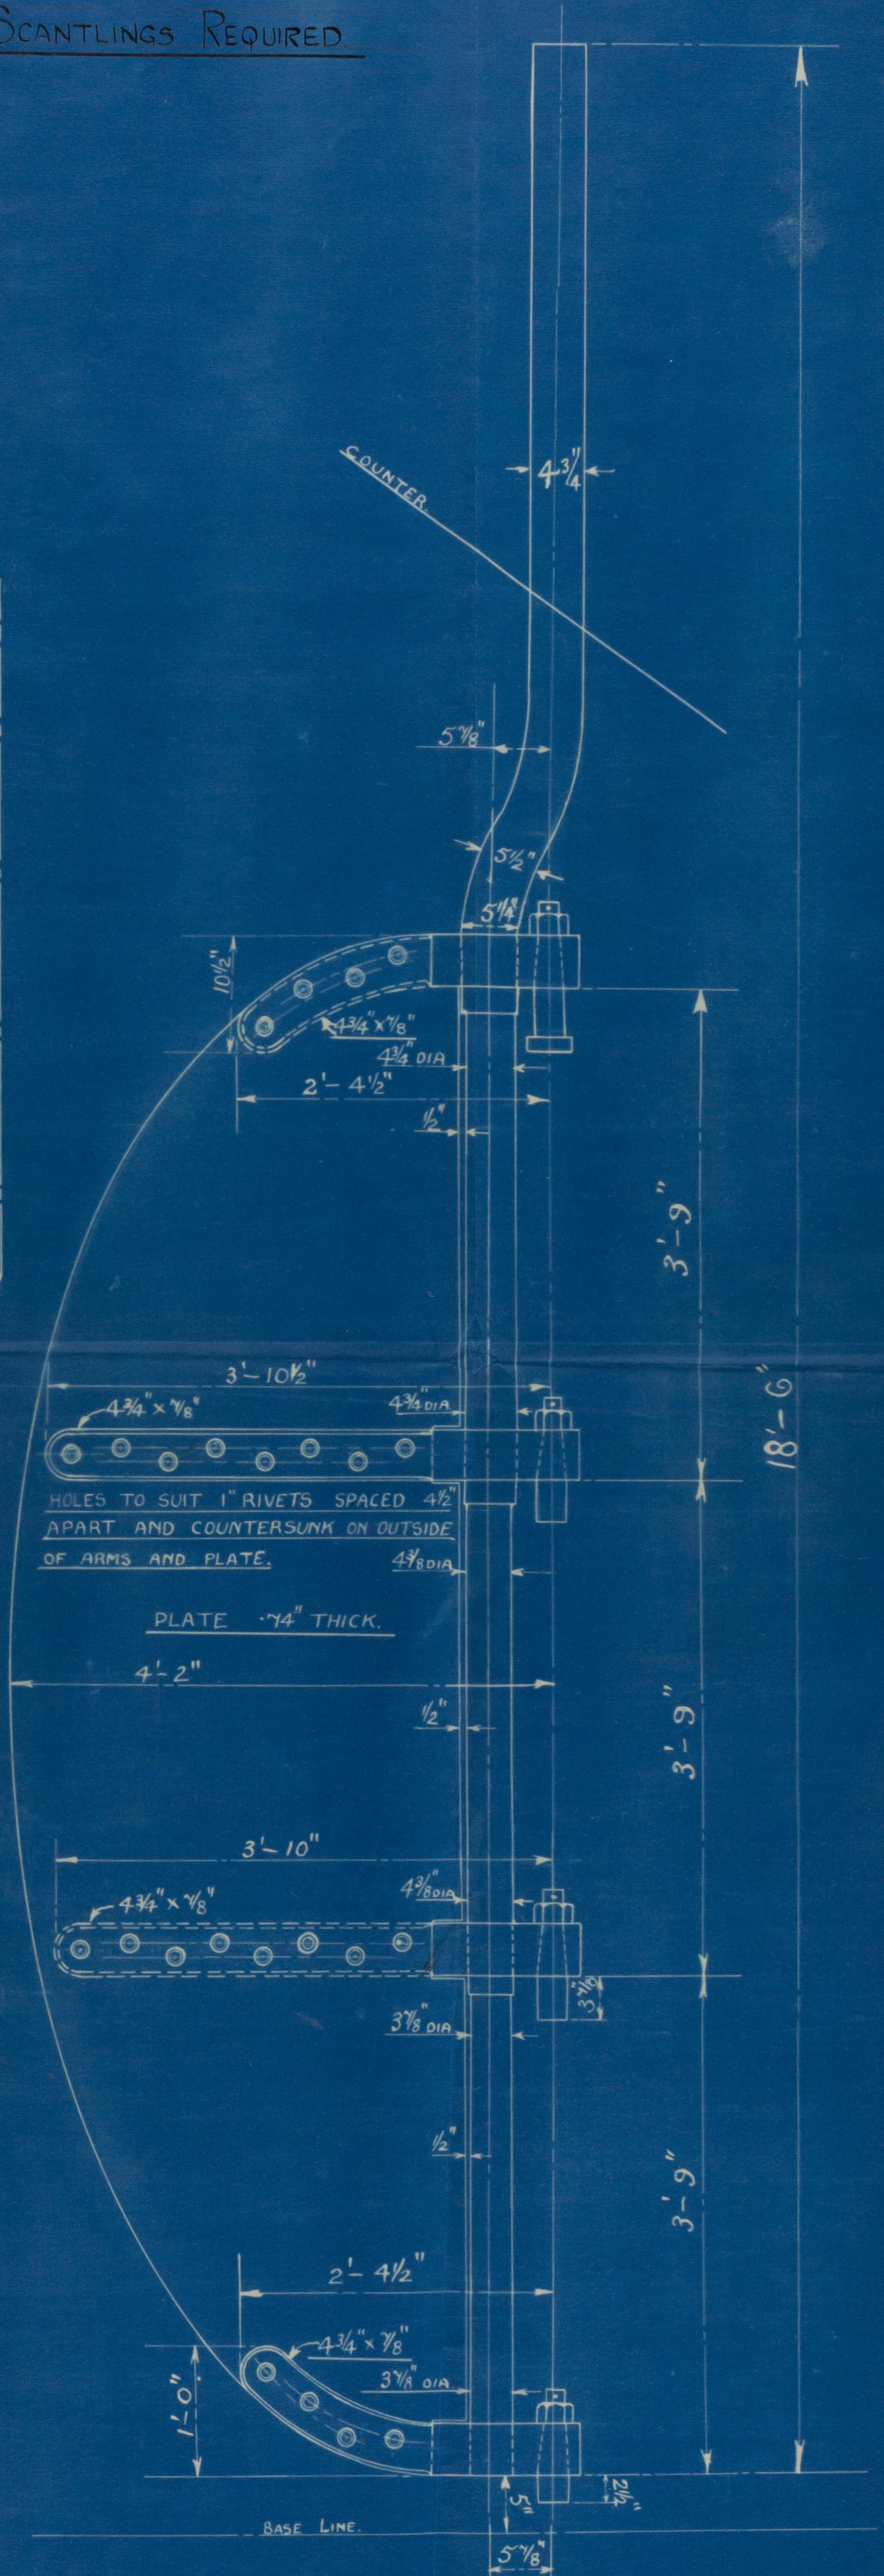

APPROVED  

*R. J. Ward*  
27.1.30

002183-0014



N<sup>os</sup> 630-631.

Rudder Plan.

a. Hall & Co. L<sup>d</sup>.

Sc. K. 630 = MARY A. HASTIE.

abu. Report = 16243

Sc. K. 631 = MARJORY M. HASTIE

abu. Report = 16244.



© 2020

Lloyd's Register  
Foundation

002174-002183-0214