


Lloyd's Register of Shipping.

Ship's Name *S/S "MATHILDA"*

Official No. *4387*

Memorandum of alterations reported since ship was surveyed for assignment of Load Lines in

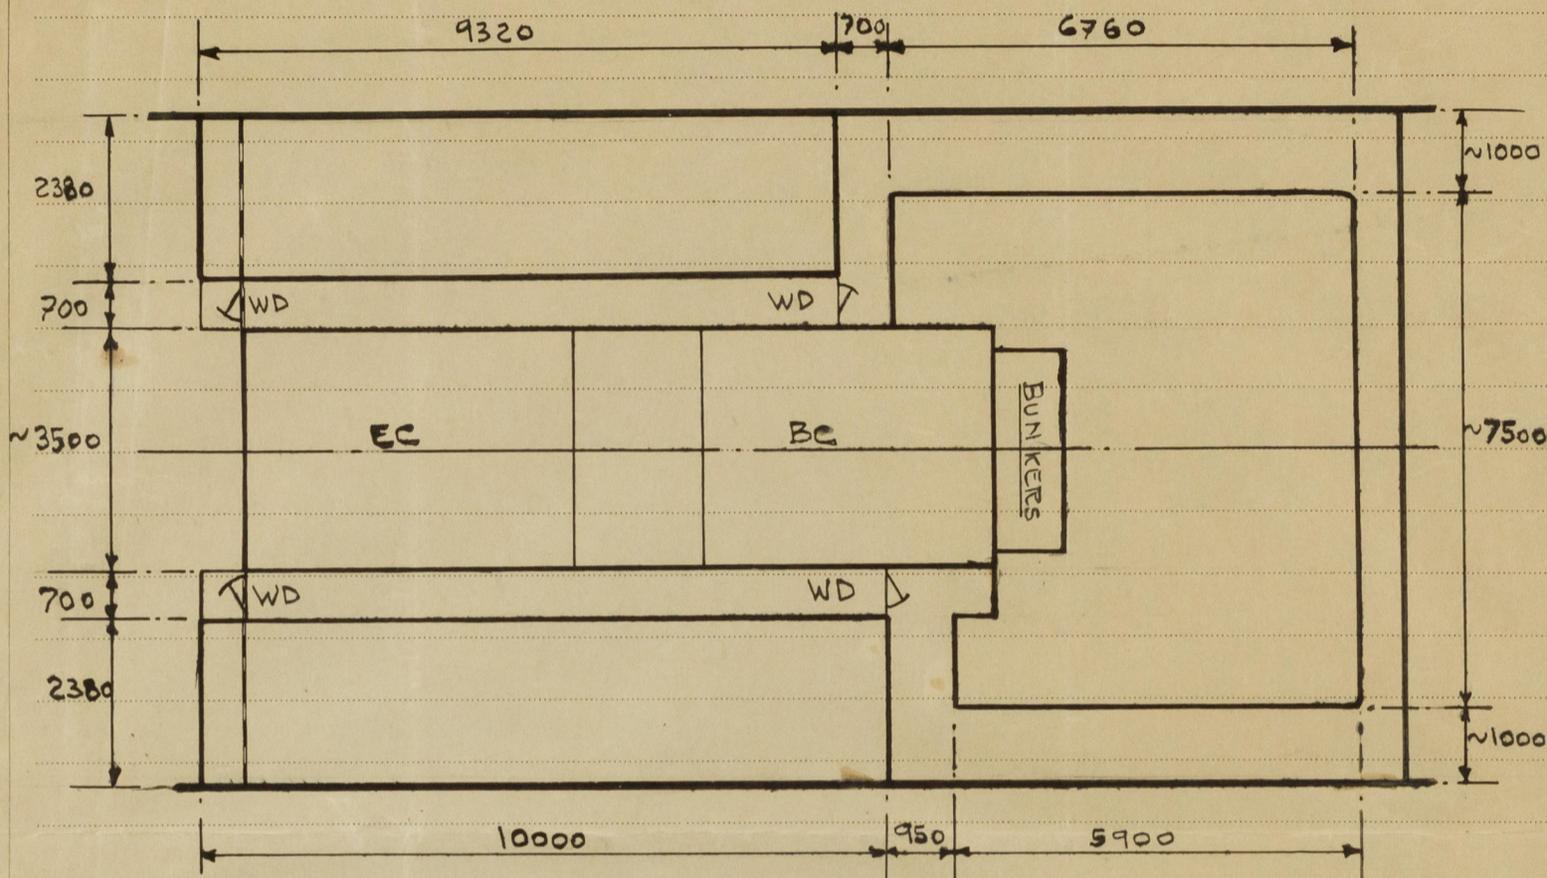

DECKHOUSES ON BRIDGEDECK

*Göteborg 3.1949
Bertrand Hansen*

G.H.W.
5- APR 1949