


29.8.05


LONGITUDINAL SECTION AND DECK PLAN.

S.S. N^o 46.

SCALE $\frac{1}{4}$ " = ONE FOOT.

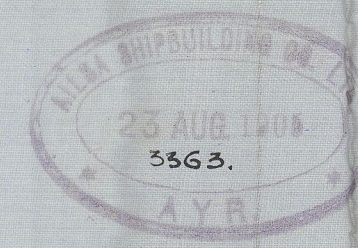

2. ED. 2 solid
2. 11. 01
needed 22
rows of 11. 01
distribution
not
magn

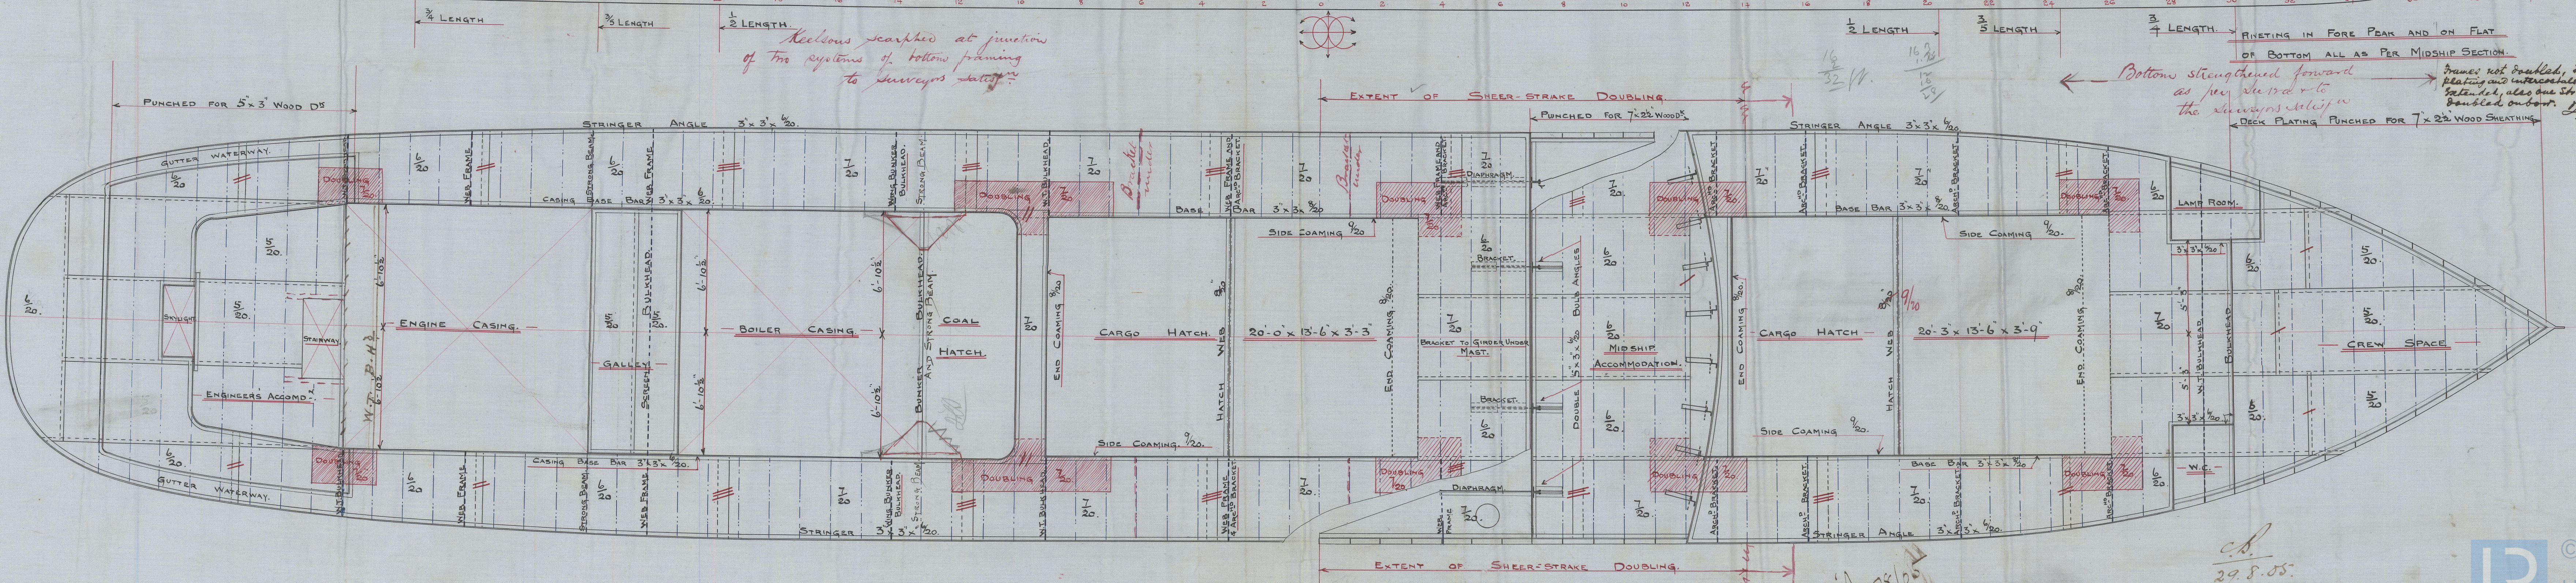

29.8.05

Allen S. B. Co

No. 146

S-S. Wheatear

Spec. rpt. No. 24017

Longitudinal
Section & Deck
Plan

Naweeale



© 2020

Lloyd's Register
Foundation

002151-002193-0211