


28.1.14



Sternframe of cast steel
and
Rudderframe of forged steel.
Scale: 1" = 1'. Details: 3" = 1'.

Horizontal coupling:

Dimensions of ship: 380'-0" x 48'-6" x 22'-0" depth.

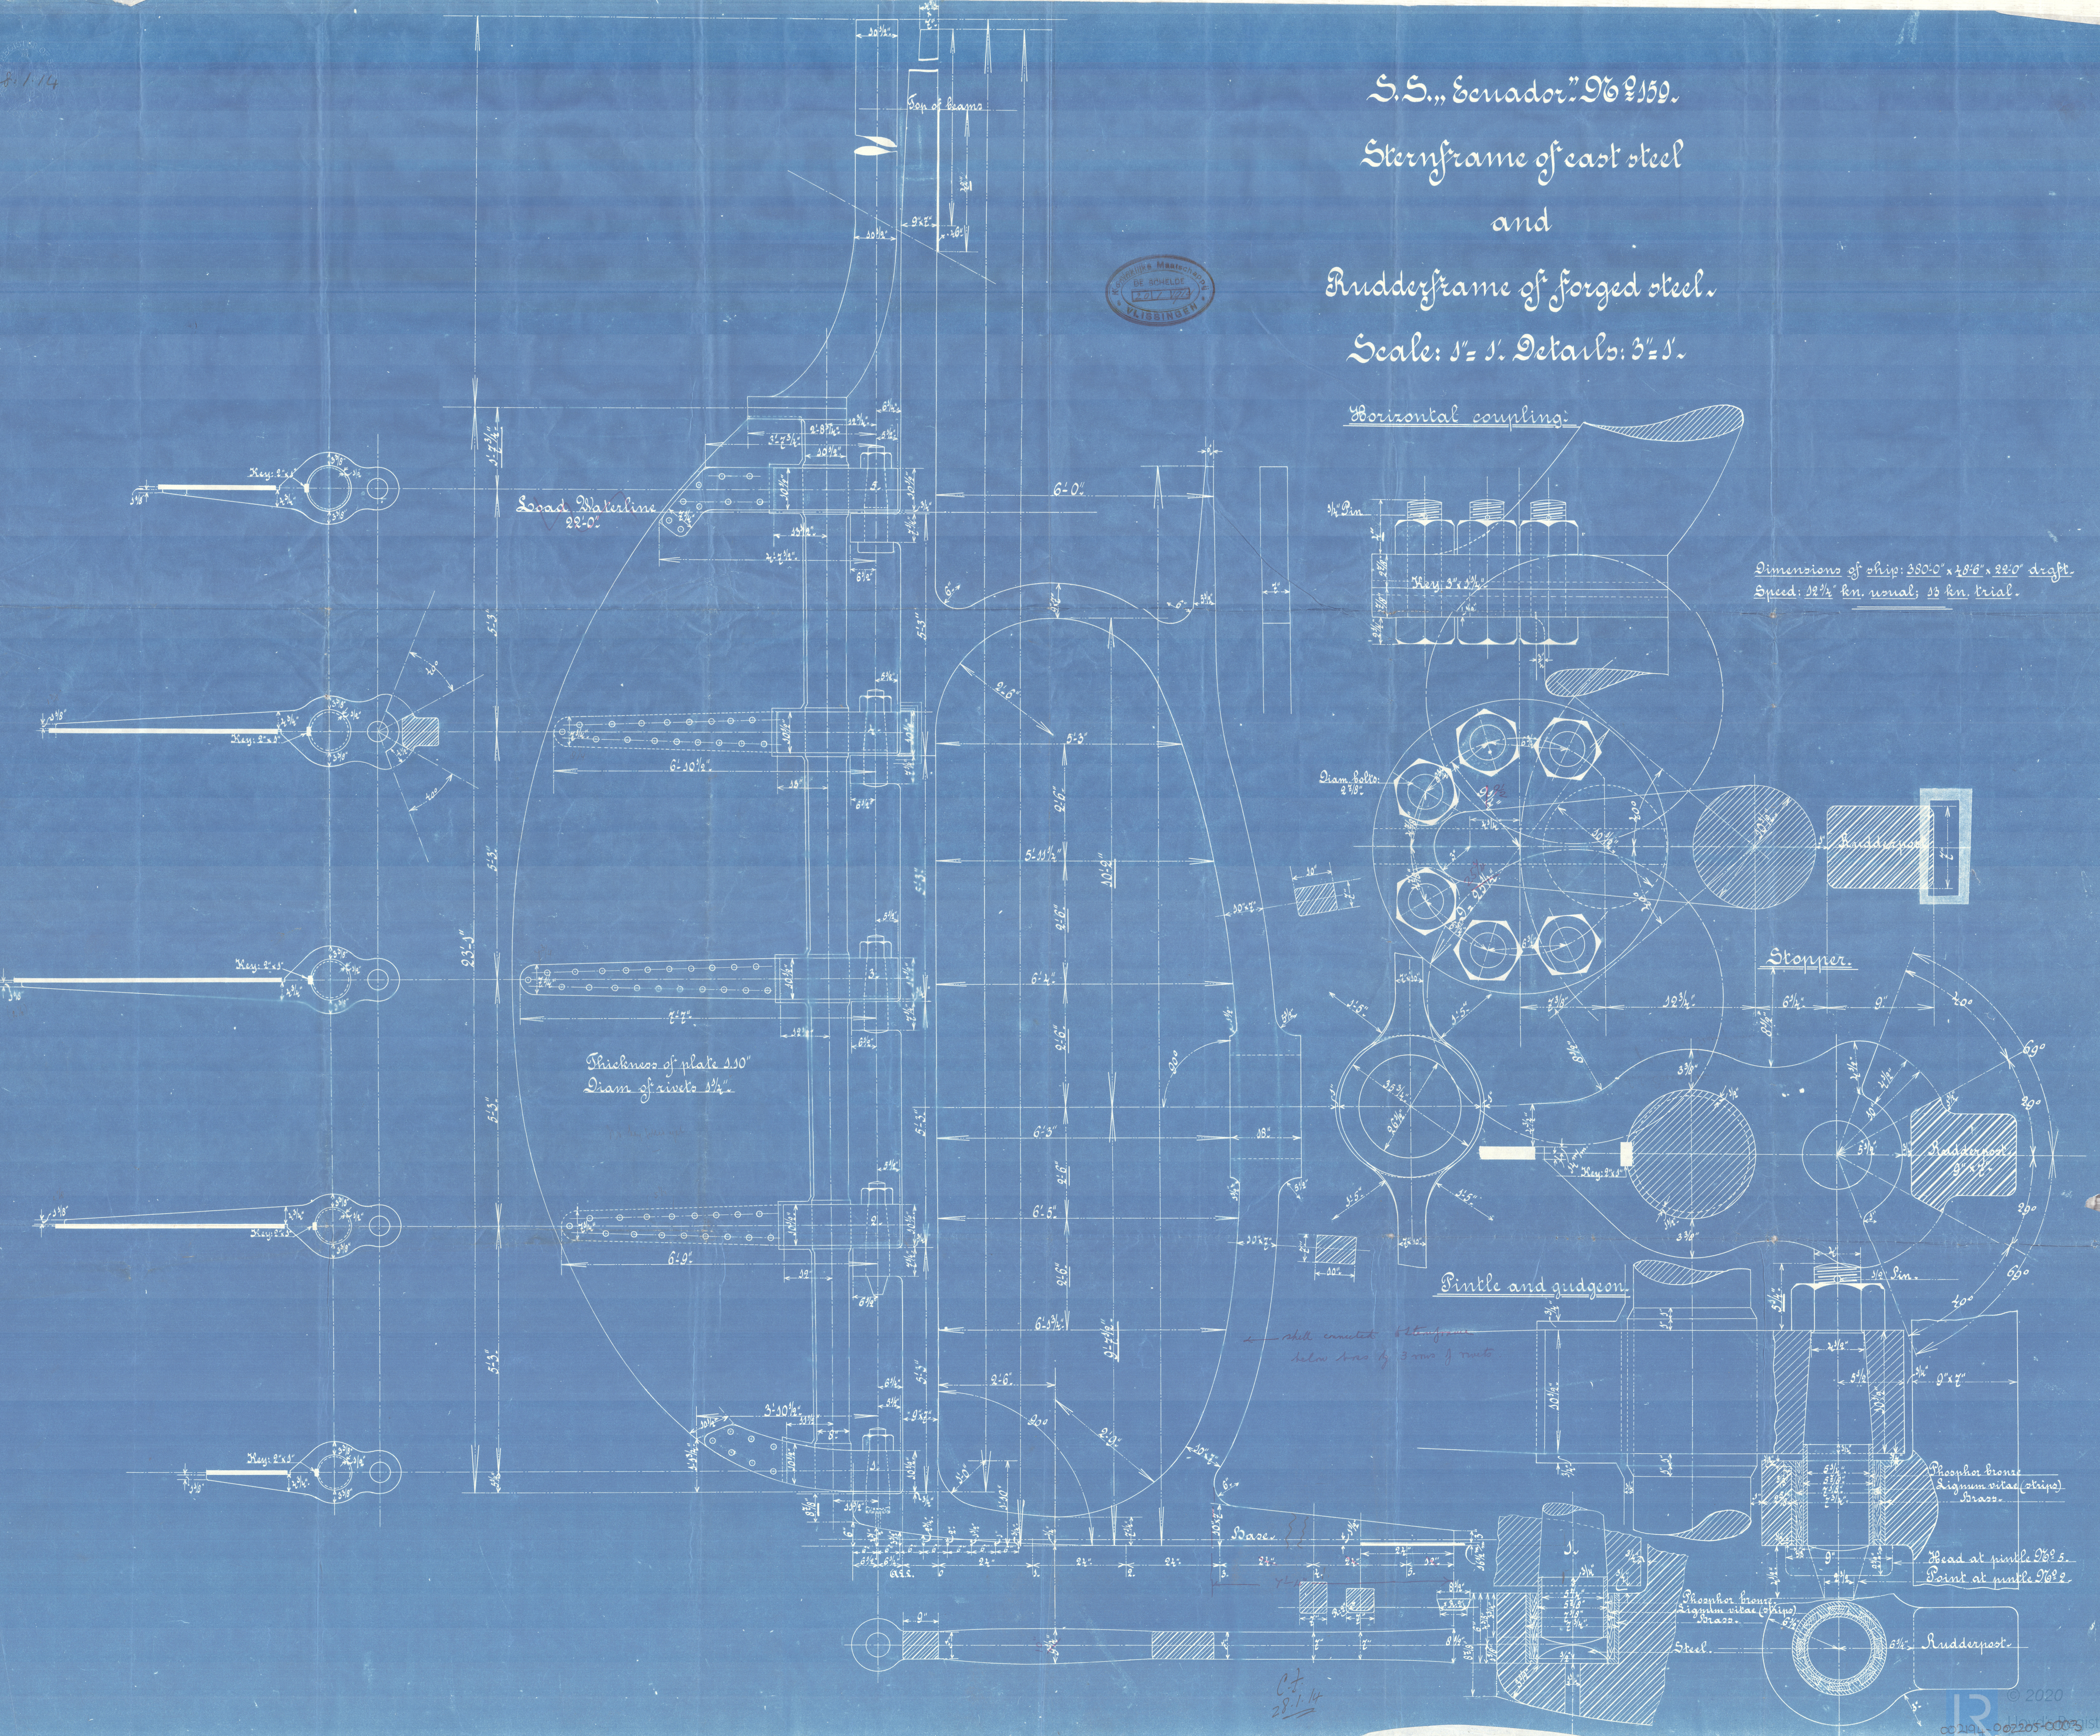

C.F.
28.1.14

~~159~~
F

159.
Approved
Ruolder &
Sternframe

S. S. Ecuador.

plan of Ruolder
and Sternframe

Rotterdam report. 9842



002194-002205-0003



© 2020

Lloyd's Register
Foundation