

Manuscript & drawings
21/8/08

PROFILE OF PROPOSED STEEL SCREW STEAMER



DIMENSIONS

246'-0" B.P. x 36'-0" x 15'-1" M¹⁰ TO MAIN D⁸ 22'-6" M¹⁰ TO SPAR DK

SCALE 1/8" = 1 FOOT


TO CLASS 100 A.I. LLOYDS "SPAR DECK"

2.9.08.
6.7.08.
17.9.08.
19.10.08.
26.10.08

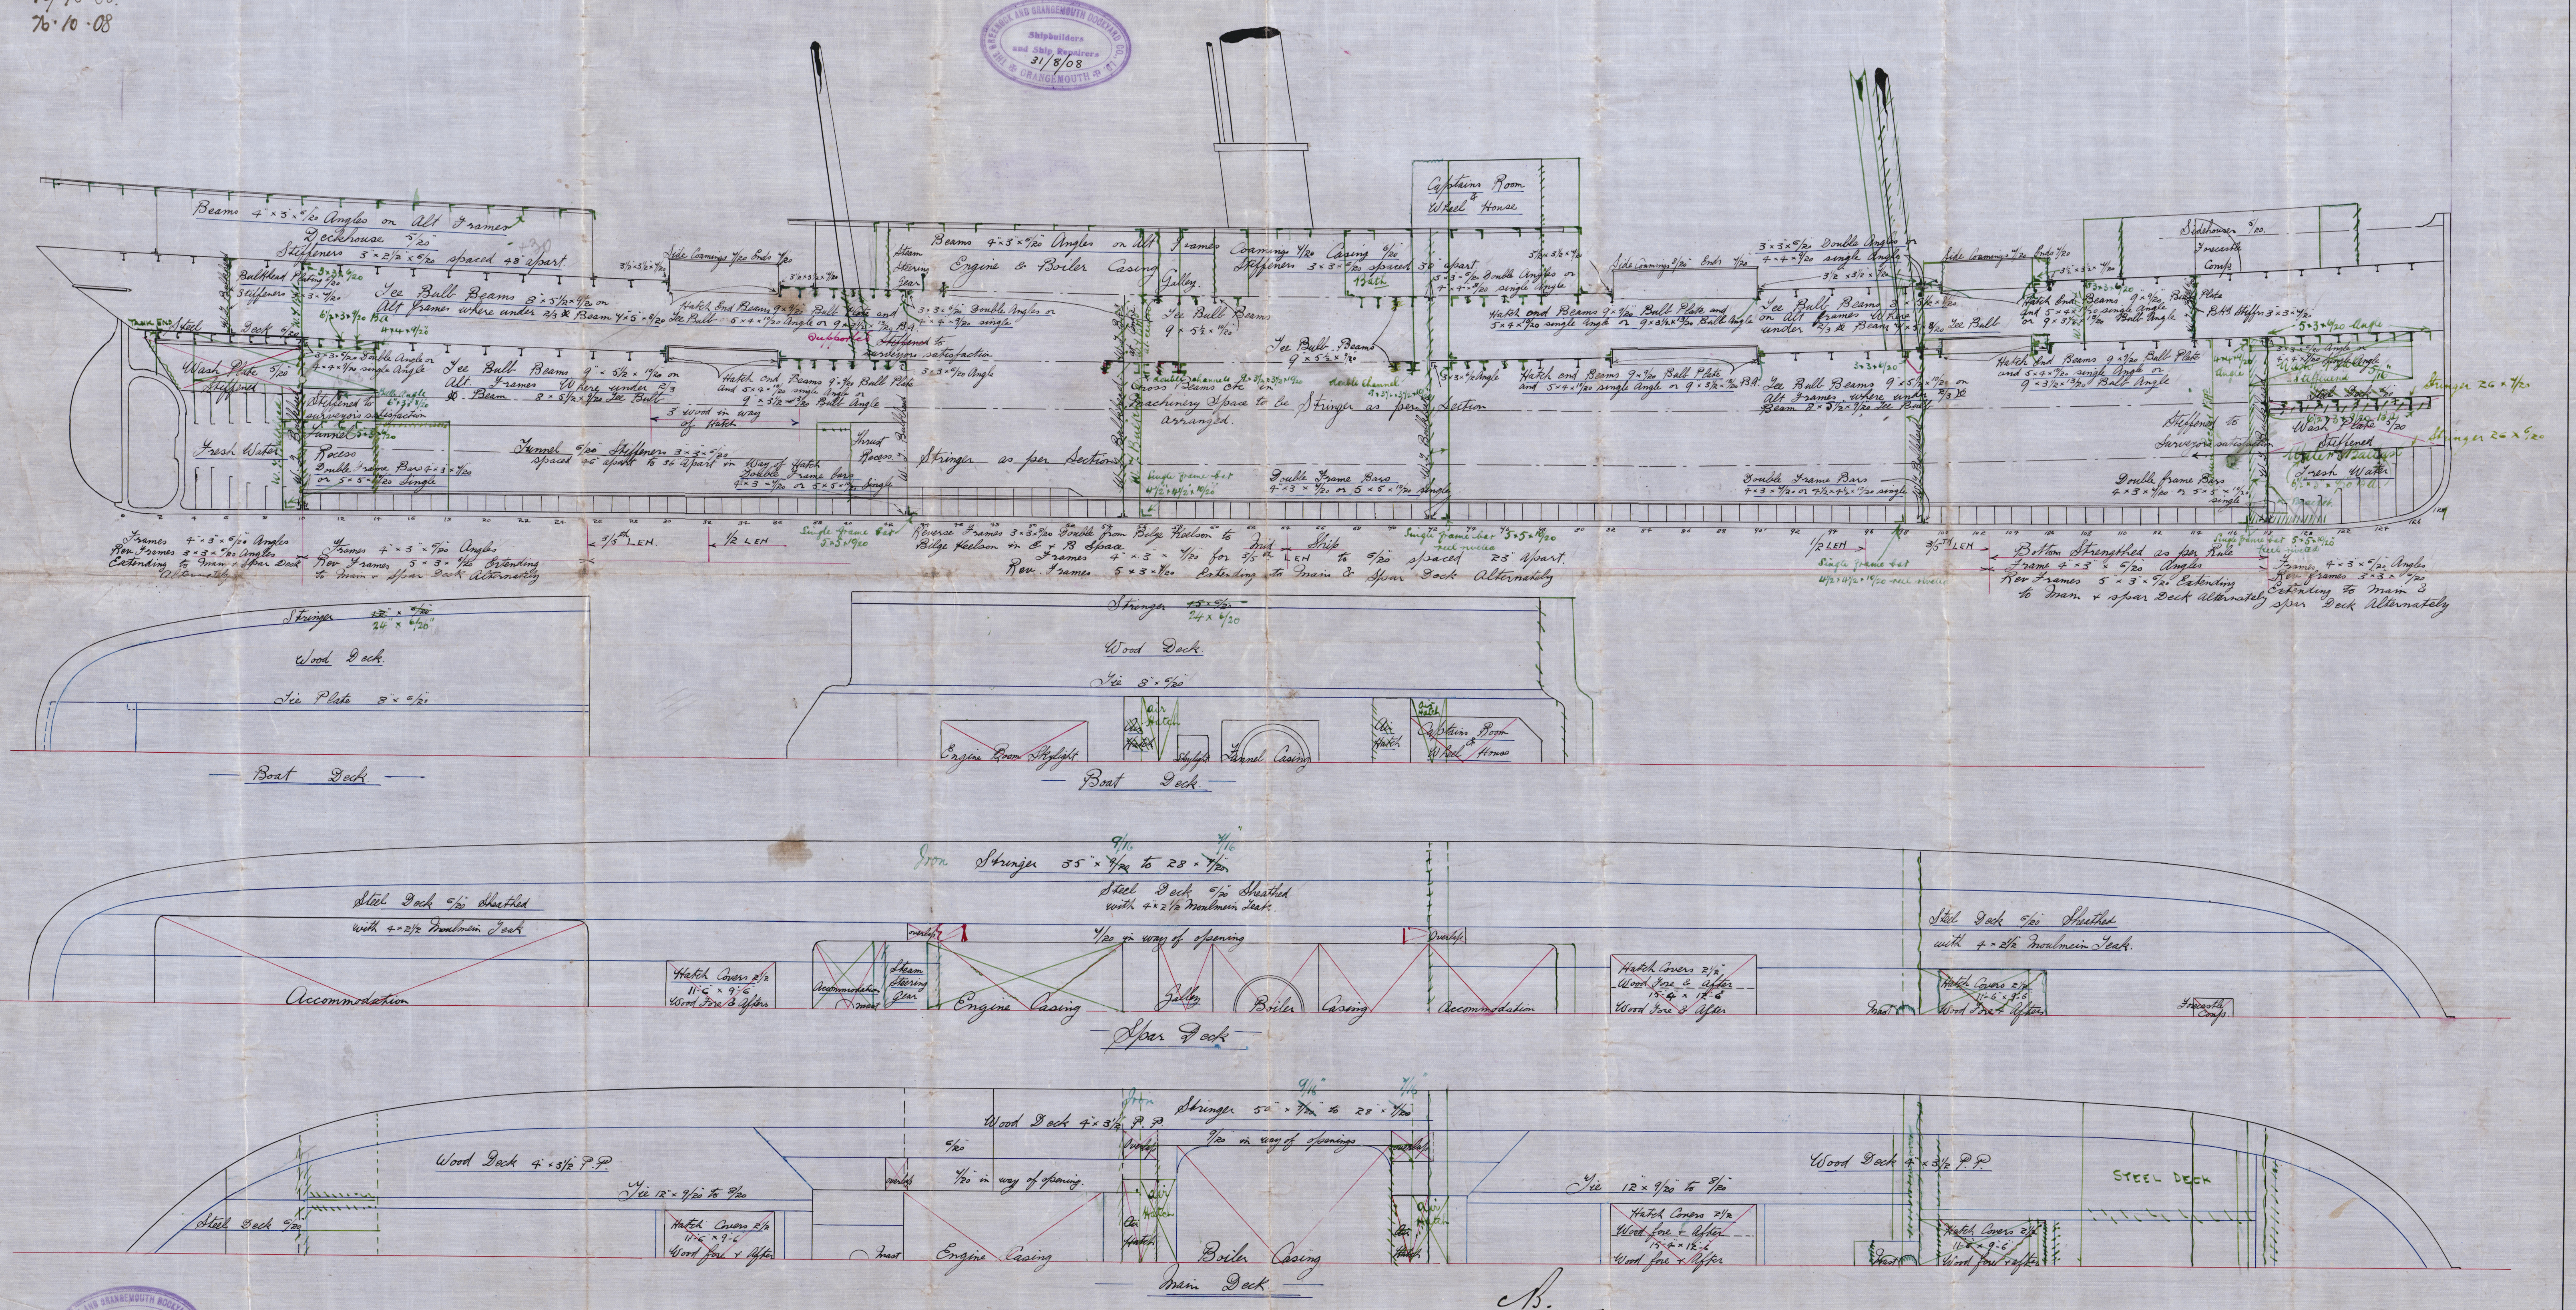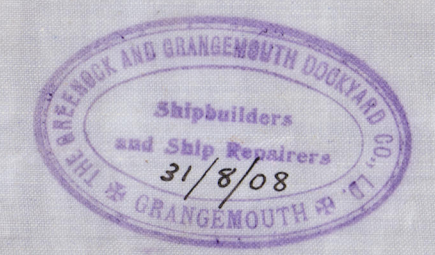

c.B.
2.9.08.

NETRAVATI

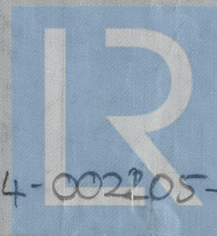

© 2020

Lloyd's Register
Foundation

002194-002105-0035

Grunnack & Grangemount
S/S 3/0. Projin

Netravati

PROFILE OF PROPO

DMGT

TYPE OF P x 30.0

SCALE

TO CLASS 100A

