



No. 1234.
OIL TANK STEAMER.
PROFILE & DECK PLAN.

SCALE $\frac{1}{8}" = 1'.$

DIMENSIONS:- 410'0" P.P. x 53'3" MLD x 31'1" TO UPPER DE.

TO CLASS 100 A-1 AT LLOYDS. (CARRYING PETROLEUM IN BULK.)

UNDER DECK TONNAGE = 5186.08.

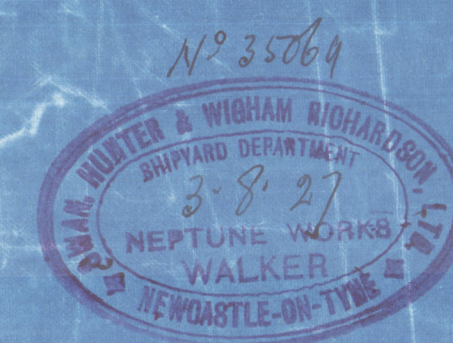 

Swan Hunters' No 1234

Profile and Deers as Buill.

J. S. Gillshepper

NEWCASTLE ON TYNE.

Report No. 81622



© 2020

Lloyd's Register

002194-002205-0088