


(As Fitted

(As Fitted

(As Fitted

(AS FITTED

APPROVED BY LLOYDS IN ACCORDANCE WITH LETTER DATED 2-5-52

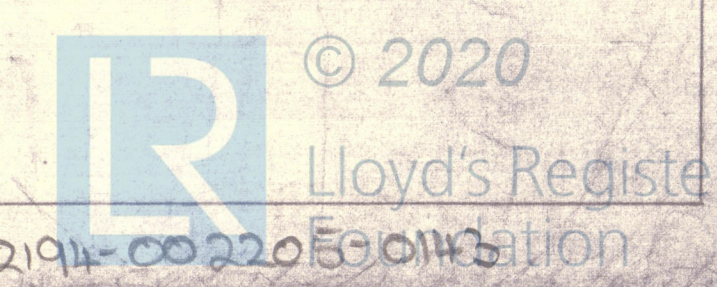



★ "NORTHERN CROWN"

COCHRANE & SONS LTD.,

YARD No 1386

HULL J.E. REPORT No. 59944

PROFILE & DECK (As Fitted)

RECORDS DEPT.  
LONDON.



© 2020

Lloyd's Register  
Foundation

002194-002205-0143