



SCALE $\frac{1}{2}'' = 1 \text{ FT}$

 

APPROVED BY LLOYDS' IN ACCORDANCE WITH
LETTER DATED 2.5.52

TO CLASS  100 A1 STEAM TRAWLER.

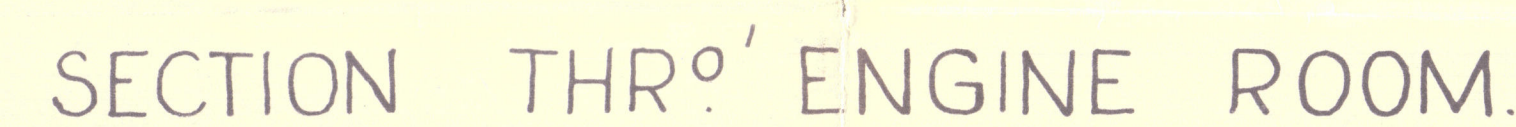

L x D	2,970.
-------	--------

$$L \times (B + D) \quad 8,730.$$

1 ST BOWER ANCHOR	16 CWTs. STOCKLESS.
------------------------------	---------------------

2ND " " 14 " "


KEDGE	"	5	"	EX. STOCK
-------	---	---	---	-----------

165 FATHOMS 1 $\frac{3}{8}$ " STUDLINK CABLE

PLUS 6 FATHOMS FOR PORT ANCHOR (OWNERS REQUIREMENTS).


60 FATHOMS 6" HAWSER.

60 " 6" WARP.

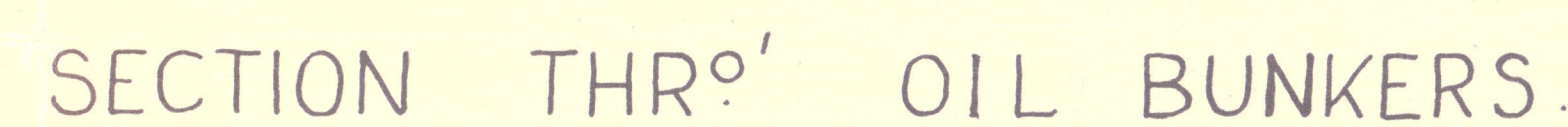

ALL LANDING EDGES DOUBLE RIVETED EXCEPT THE FOLLOWING.

1. TOP EDGE OF SHEERSTRAKE.
 2. SHEERSTRAKE BOTTOM EDGE WELDED IN WAY OF BUNKERS.
 3. F" STRAKE TOP & " " 5 " " " " "
 4. E' " " " " " " GALLOWS TO GALLOWS.
- BUTTS OF GARBOARD STRAKE & SHEERSTRAKE TREBLE RIVETED & STRAPPED -
FOR 1/2 LENGTH, DOUBLE AT ENDS.
- BUTTS OF B, C & D STRAKES OVERLAPPED & DOUBLE RIV'D ALL FORE & AFT.
BUTTS OF E & F STRAKES OVERLAPPED & TREBLE RIV'D FOR 1/2 LENGTH -
OVERLAPPED & DOUBLE RIVETED AT ENDS.
- BUTTS IN REMAINING STRAKES OVERLAPPED & DOUBLE RIV'D ALL FORE & AFT.
BUTTS OF 'F' & SHEERSTRAKE WELDED IN WAY OF OIL FUEL BUNKER.
- " " 'E' STRAKE WELDED FROM GALLOWS TO GALLOWS.
- ALL RIVETS TO BE LEFT FULL.

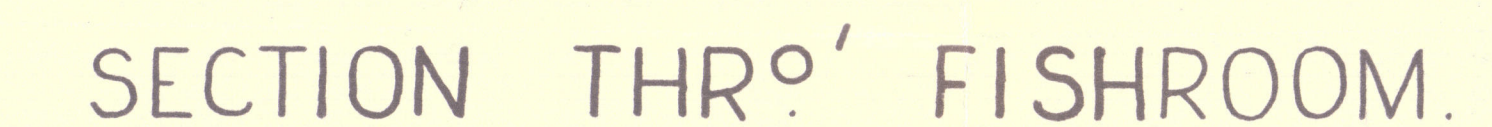

★ "NORTHERN CROWN"

COCHRANE & SONS LTD

YARD No 1386

MULL J.E. REPORT No. 59944.

STRUCTURAL SECTIONS

(As VITTED)

RECORDS DEPT.,
LONDON.

© 2020

Lloyd's Register
Foundation

002194-002205-0144