

M. S. SALSAAS

Lloyd's Register of Shipping.

SURVEYS FOR FREEBOARD.—STEAM SHIPS. 25788.

PARTICULARS RELATING TO ALL STEAM SHIPS EITHER FLUSH DECKED, OR WITH TOP GALLANT FORECASTLES, SHORT POOPS AND BRIDGE HOUSES DISCONNECTED, OR WITH TOP GALLANT FORECASTLES HAVING LONG POOPS, OR RAISED QUARTER DECKS CONNECTED WITH BRIDGE HOUSES, OR OTHERWISE.

Port of Survey Glasgow
Date of Survey 7th May 1918
Name of Surveyor Geo. M. Shaw

Standard Vessel Type A (Converted oil carrier)

Ship's Name.	Port of Registry and Nationality.	Official Number.	Gross Tonnage.	Date of Build.	Particulars of Classification.
<u>WAR AFRICAN</u> aland & Wolff & Co. No. 5276 Number in Register Book 134 in Supp.	<u>London</u> British	<u>142415</u>	<u>5218</u>	<u>1918</u>	<u>+100A1 Carrying fuel oil in bulk F.P. above 150° of (Contemplated)</u>

Registered dimensions from Ship's Register.	LENGTH.	BREADTH.	DEPTH.	UNDER DECK TONNAGE.
	<u>400.6</u>	<u>52.3</u>	<u>28.5</u>	<u>4767.21</u>
Length on LOADLINE.	<u>399.5</u>	Frame Depth <u>4.5</u> Rule " <u>6</u> <u>2 x 5.24 level tanks</u> <u>NO SPARRING</u> <u>+ .33</u>	Ceiling + <u>.20</u> Sheer + <u>1.14</u>	Peak Tanks } <u>Inc</u>
CORRECTED DIMENSIONS.	<u>399.5</u>	<u>51.46</u>	<u>29.84</u>	<u>4767.21</u>

Moulded Depth as measured..... 31.0

Addition for Keel below base line for draught record..... 2 inches.

NOTE.— If the depth is measured when vessel is afloat, the details of measurement should be reported.

CORRECTION FOR LENGTH.

Length of Ship on Loadline..... 399.5
Length in Table 372.0
Difference 27.5
Correction for 10ft., Table A. 1.6 Table C. 27.5
× Difference divided by 10 4.4 (if required.)
If $\frac{1}{10}$ ths length covered divide by 2 2.2

CORRECTION FOR IRON DECK.

Proportion covered, if less than $\frac{7}{10}$ ths length covered503
Thickness of usual wood deck, less stringer 3 1/2 = 1 3/4

CORRECTION FOR ROUND OF BEAM.

Breadth at Gunwale amidships..... 52.0
Round of Beam 13
Normal round..... 13
Difference 0 ÷ 2 =
Proportion of Deck uncovered (Para. 19)

Co-efficient of fineness..... .77
Any modification necessary } .02 Cell D.B
[Para. 4 (a) to (e)]*
Co-efficient as corrected75

Sheer { Stem..... 120 }
at { Sternpost ... 60 } $180 \div 2 = 90$... Mean 90.9
36/40.95

Sheer at $\frac{1}{2}$ of the length from { Stem 67 }
{ Sternpost 33 } $100 \div 2 = 50$... Mean 90.9
+ .55 = 90.9

Gradual mean Sheer 90.45 Correction
Standard mean Sheer [Table, Para. 18]
Difference..... 49.95 ÷ 4 =
§ If limited as Para. 18 (f)..... 40.50 10 1/4

Rise in Sheer { At front of bridge house..... }
from amidships { At after end of forecastle }

Fall in Sheer }
Para. 18 (d) } ÷ 2 =
Length uncovered Correction

ALLOWANCE FOR DECK ERECTIONS:—

Freeboard, Table C..... 4.9
Correction for Length, if required (Para. 12, 13, and 14) ...+ 2 1/4
4 - 11 1/4
Freeboard by Table A, corrected for sheer, and for length, if required (Para. 12, 13, and 14) } 7.43
} 2.52
Difference 52.08
Percentage as below..... 32.28
9.46
952

Correction for R. Q. Dk. if engine and boiler openings not covered by bridge house (Para. 11) }
Allowance for Deck Erections - 9 1/2

Freeboard, Table A 7 10 1/2
Correction for Sheer - 10 1/4
Correction for Length + 4 1/2
Allowance for Deck Erections - 9 1/2
Correction for Round of Beam..... - 6 7 1/4

Correction for fall in Sheer (if any).....
Correction for Iron Deck (if required) - 1 3/4
6 5 1/2

Additions for non-compliance with provisions of Para. 11 (d) and (e) †
Other Corrections (if any)

Winter Freeboard 6 5 1/2
Summer Freeboard 6 0
Indian Summer Freeboard 5 1 1/2
N. A. Winter Freeboard

Correction necessary because clearside amidships, measured in accordance with the Statute is not taken at the intersection of the wood or iron deck with side. 1 1/2

Winter Freeboard from deck line 6 7
Summer " " " 6 1 1/2
Indian Summer " " " 5 8
N. A. Winter " " "

	Length.	Length allowed.	Height.
Forecastle.....	<u>39.25</u>	<u>39.25</u>	<u>7.11 1/2</u>
Bridge House.....	<u>112.67</u>	<u>112.67</u>	<u>7.11 1/2</u>
† Raised Qr. Dk.....			
Poop.....	<u>49.25</u>	<u>49.25</u>	<u>7.11 1/2</u>
Total	<u>201.17</u>		<u>5035</u>
Length of Ship	<u>399.5</u>		
Corresponding percentage (Para. 11, 12, 13, or 14) }	<u>32.28%</u>		

FREEBOARD recommended amidships from centre of Disc to top of Statutory Deck Line, Wood (Iron) Deck:—

10. 5. 18.

Fresh Water Line above centre of Disc
Indian Summer Line " " "
Winter Line below " " "
Winter North Atlantic Line " " "

† If the frames, skin planking, or ceiling are of unusual thickness the breadth of vessel to inside of ceiling should be reported if possible.
‡ In vessels obtaining an allowance for deck erections under Para. 11 where the sheer drops abaft amidships the height of the R.Q.D. is to be taken from the level of the top of the amidship beam.
§ In flush-decked vessels the total standard mean sheer means the sheer measured at the stem and sternpost. In vessels having poops and forecastles it means the sheer measured at points distant from the vessel's length from stem.

† State dimensions of freeing port area on back of this form.
‡ The Surveyor should state whether the fall in sheer as reported is measured relatively to the straight line of keel or to the water line. If measured relatively to water line the vessel's draft at time of survey and also the usual load draft forward and aft should be reported.

002194-002205-0274

MARKING FORM
15 OCT 1926
RECEIVED

Lloyd's Register
FOUNDATION REPORT
NOV 5 1918

Do all the Frames extend to the top height in the Poop? *yes* Raised Quarter Deck? *no* Bridge House? *yes* Forecastle? *yes*
 To what height do the Reverse Frames extend? *Cupper Deck no reverse frames in way of E. or B. chaise*
 Has the Poop or Raised Quarter Deck an efficient Iron Bulkhead at the fore end? *yes*
 Give particulars of the means for closing the openings in Bulkhead *no openings*
 Is the Poop or Raised Quarter Deck connected with the Bridge House? *no* Has the Bridge House an efficient Bulkhead at the fore end? *yes*
 Give particulars of the means for closing the openings in Bulkhead *no openings*
 What is the thickness of the Bridge Front plating? *40* and Coaming plate? *44*
 Give scantlings and spacing of the Stiffeners *9 x 3 1/2 x 56 Bull angles 30 apart*
 Are bracket plates fitted at each end of the Stiffeners? *yes* Are hor'l. brackets fitted connecting Bridge Bulk'd. with Bulwarks? *yes*
 Has the Bridge House an efficient Iron Bulkhead at the after end? *yes*
 How are the openings closed? *Shifting boards in riveted channels full height*
 Is the Forecastle at least as high as the main or top-gallant rail? *yes* Has the Forecastle an efficient Iron or Wood Bulk'd. at after end? *yes*
 Are the Engine and Boiler openings covered by a Bridge, Poop, Raised Quarter Deck, or enclosed by a Strong Iron or Steel Deckhouse? *Covered by bridge deck*
 If the openings are not so protected are the exposed parts of the Casings efficiently constructed? *no*
 Give thickness of plating; scantlings and spacing of Stiffeners *no*
 What is the height of the exposed Casings? *no* Are suitable means provided for closing all openings in them in bad weather? *yes*

Are the Weather Deck Hatchways efficiently constructed and at least equal to the requirements of Section 28 of the Rules for 1904-5? Give particulars below: *yes*
 < ON BRIDGE DECK >

Position and Size.	No 1: 32.6 x 26.0		No 2: 34.8 x 26.0		No 3: 10.10 x 18.0		No 4: 34.8 x 26.0		No 5 (See below)	
	Ship.	Rule.	Ship.	Rule.	Ship.	Rule.	Ship.	Rule.	Ship.	Rule.
COAMING.	Height above top of DECK	30	30		18		30		30	
	Thickness	Sides	44	44	44		44		44	
		Ends	44	44	44		44		44	
SHIFTING BEAMS OR WEB PLATES.	Number	Covered with 42	Covered with 42		3 (fore & aft)		Covered with 42		at aft end 3	
	Section and Scantlings	plating beams on every	plating beams on every		7 1/2" 10 x 30		plating beams on every frame		2 1/2" 24 x 38	
	Material	steel	steel		Steel		steel		6 x 3 1/2 x 46 Steel	
* FORE AND AFTERS.	Number	frame	frame		3 x 3 x 40		oil tight		fore end	
	Section and Scantlings	oil tight	oil tight				hatches		plated over	
	Material	3.0 x 3.0 on top	3.0 x 3.0 on top				3.0 x 3.0 on top			
HATCHES Thickness					3				3	
Remarks										

* The depth of Fore and Afters should be stated from the underside of the hatches in all cases.
 (If the sill of the lowest side scuttle will be less than 6 inches above the Indian Summer Load Line if assigned under the tables, state vertical distance from top of deck at side amidships to lower edge of lowest side scuttle.)

The following information is to be given in all Cases of vessels dealt with under Paras. 11, 12 (under 15 feet Moulded depth) and under Shelter Deck Rules.
 What is the thickness of the Bridge Sheerstrake? _____ Strake between Main and Bridge Sheerstrakes? _____


Delete the words { The Crew are, are not, berthed in the bridge house.
 that do not apply { The arrangements to enable them to get backwards and forwards from their quarters are, are not satisfactory.

Length of Bulwarks in well _____

Area of Freeing Ports required by Para. 11 (e) each side of vessel = _____ Sq. ft.

Ft.	Tenths.	Ft.	Tenths.	No.	} Freeing Ports (each side of vessel) = _____ Sq. ft.
x	x	x	x		
x	x	x	x		

Total deficiency or excess = _____ Sq. ft.

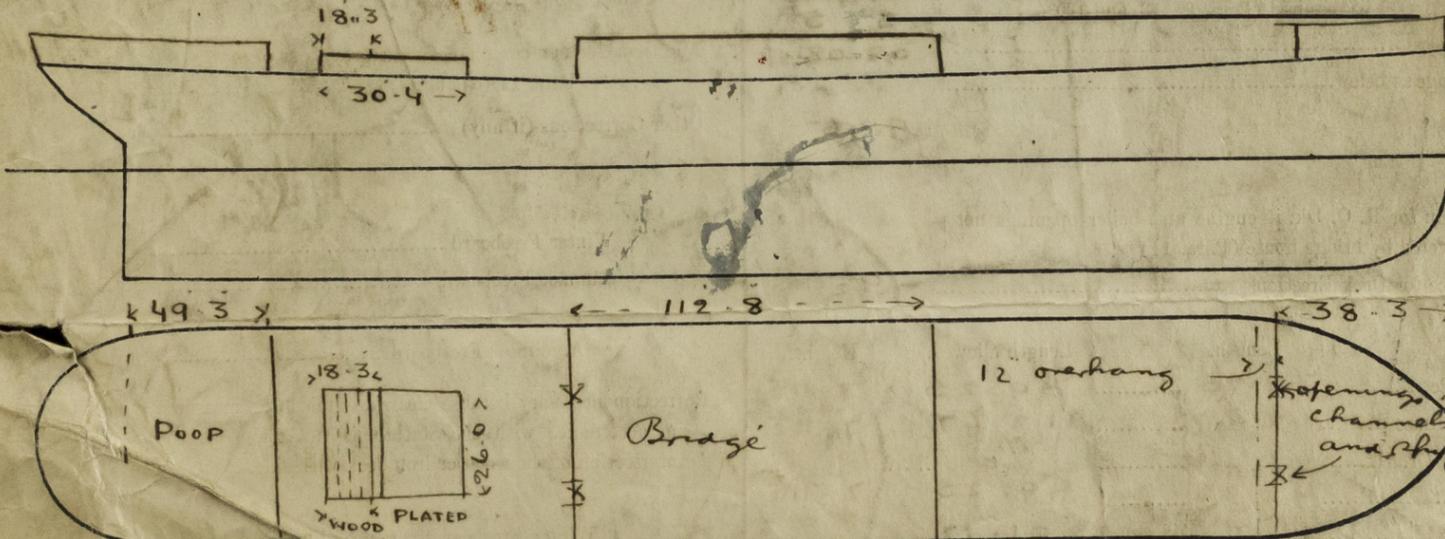

Show hereon use of Floors or Tank Top with position of any Breaks in same; also height of Peak Tank tops, &c., &c.

State any special features in the construction of the Vessel *Vessel is an A Type Standard Copies of the approved plans are in the London office a preliminary freeboard was assigned to this vessel see London letter M dated 10th Sept 1917 This is a sister vessel to the same Builder No. 526 S.S. was expert Glasgow Owners*

Address _____

Fee £ 7 : 7 : 0

Received by me _____ 13/6/18

