

B.P. 31'6" BREADTH M^{LD}, 14'6" DEPTH M^{LD} TO UPPER DECK AT SIDE.
SCANTLINGS TO LLOYD'S RULES.
CAMBER OF BEAMS 8".
FRAMES SPACED 22" THROUGHOUT.

QUARTER DECK NUMERALS


LONG⁴ N° = $L \times (B+D)$ =

TRANSVERSE N° = $B \cdot D$ =

PROPORTIONS = $\frac{B}{D}$ =

d =

2 POWER STOCKLESS ANCHORS AT 2 1/4 CWT	COLL W/ 60% CWT
1 " " " " " 18 " }	
1 STREAM ANCHOR AT 5 1/4 CWT	
1 WEDGE " " " 2 1/4 " EX. STOCK	
210 FATIGMS 1 1/2" STUD CHAIN CABLE	
60 " " 3/4" WIRE (IN LIEU OF SINGAM CHAIN)	
90 " " 2 1/4 " "	
2-90 " " 2 1/4 " "	
90 " " 3 " TOWLINE	

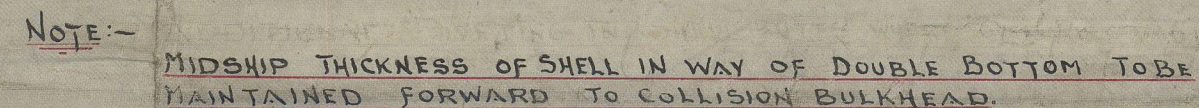

HAWTHORNS & CO. LTD.
MARINE ENGINEERS & ENGINEERS
V 19/180
28/6/19
Messrs Lloyds, Leith.

Mont Jomieu 28/11/19



© 2020
Lloyd's Register
Foundation

S. S. No. 180 + 182

Misses Scher

Mrs. Hawthorn & L.
Luth

Amended

Wry Freighter
Ss. Ardenya

Lth. 15876

Ss. "

Ardenya

Lth 15958

002215-002221-0044