


Lloyd's Register of Shipping.

Ship's Name S/S "HEDERA" Official No. 3578

Memorandum of alterations reported since ship was surveyed for assignment of Load Lines in

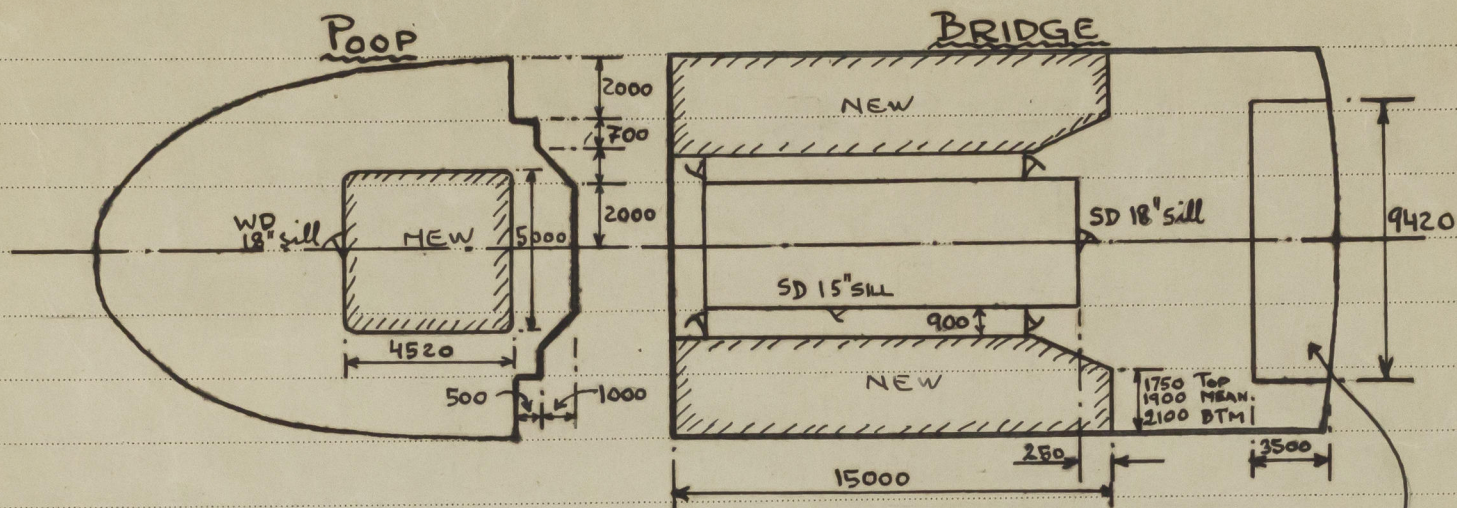

New Hatch Escape from after hold.

Opening = $800 \times 610 \times 9 \frac{m}{m}$
 Height = $850 \frac{m}{m}$
 Cover = $5 \frac{m}{m}$ (steel)
 4-3/4" toggles, closed WT.

Existing deckhouse but not reported on memo for report no 1142 (index no 14195) of the 21st July 1932 ✓

Opening in Bridge forward bulkhead has been placed nearer shell and has 42" sill now (starboard side).

New Poop Deckhouse:

L = $4520 \frac{m}{m}$
 B = $5000 \frac{m}{m}$
 H = $2200 \frac{m}{m}$

New Bridge Side Deckhouses:

L = $15000 \frac{m}{m}$
 B = $2900 \frac{m}{m}$ (mean value)
 H = $2200 \frac{m}{m}$

The Poop deck has received a recess or platform for winch.

Gothenburg, 20th Nov. 1945
 Berndt L. Hansen

T. L. L.

11/12/45



© 2020

Lloyd's Register
 Foundation

002215-002221-0138