

Lloyd's Register of Shipping.

SURVEYS FOR FREEBOARD.

(CONDITIONS OF ASSIGNMENT.)

Ship's NameS/s "ODDEVOLD"

Port of SurveyLönsborg.


Official Number4611

Surveyor's SignatureA. Börning

Nationality and Port of RegistrySwedish, Stockholm.

Date of Survey14th Oct. 1942

Disposition and dimensions of superstructures, trunks, deckhouses and machinery casings to be inserted in the diagrams and tabular statement:—

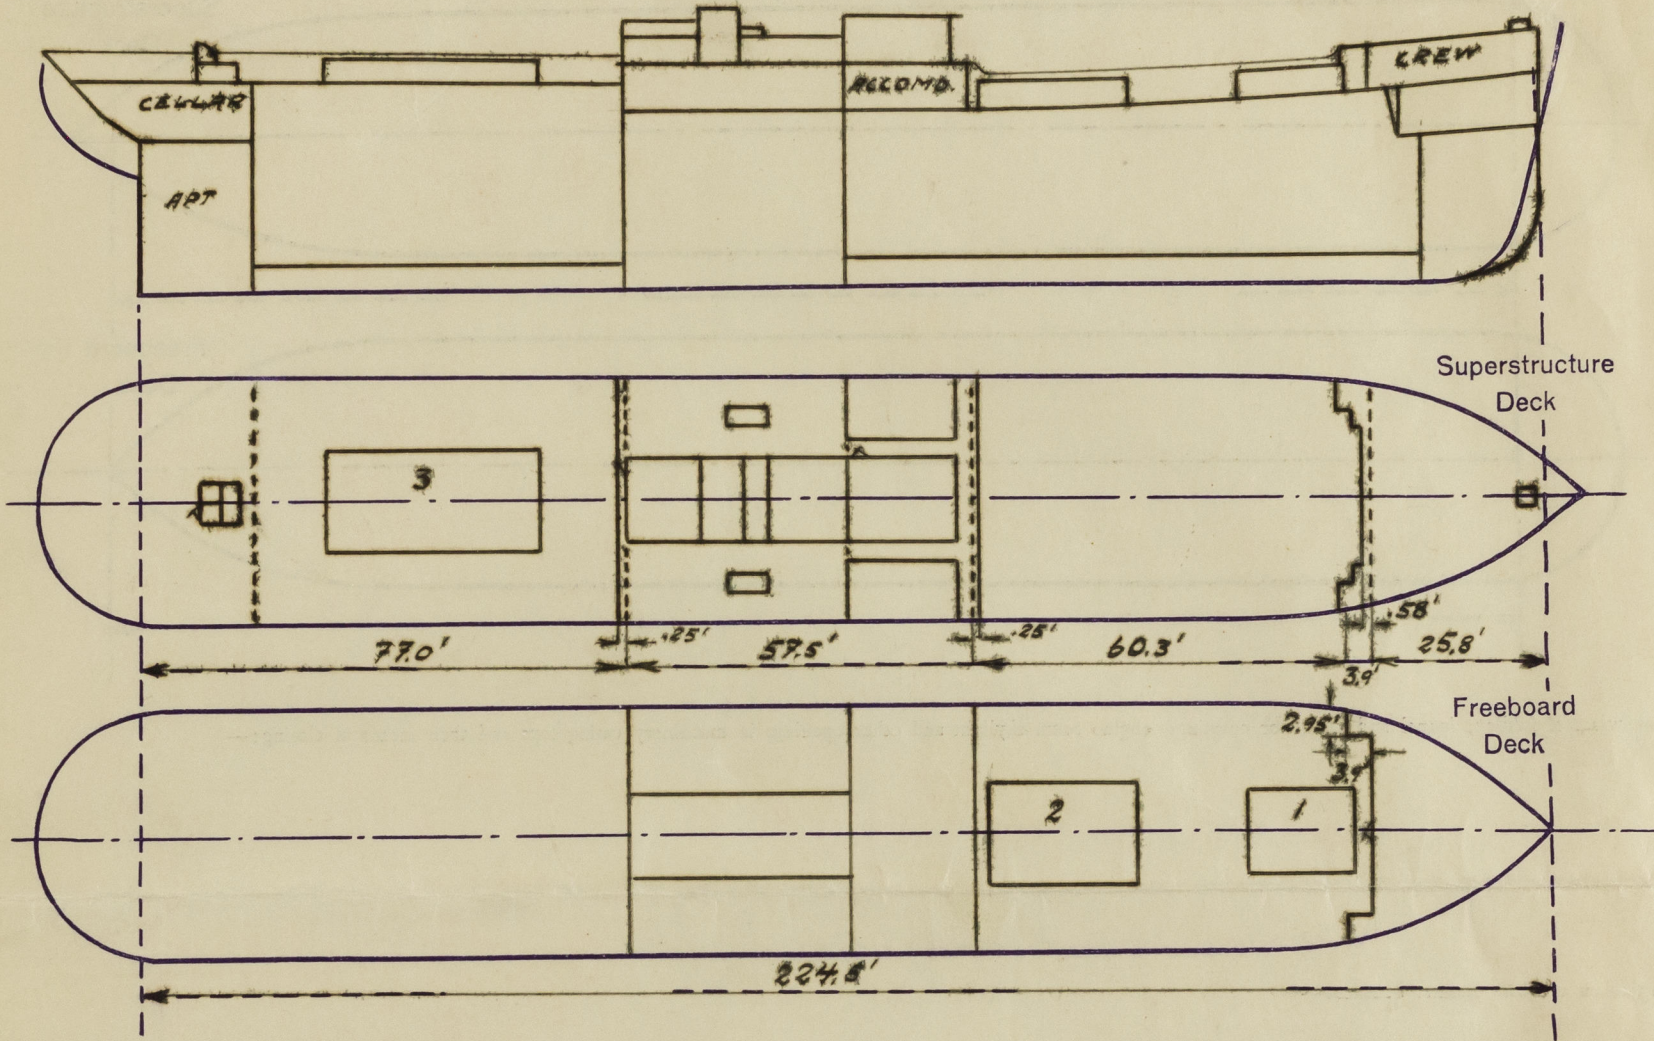


Particulars of Superstructures, Trunks, Casings, Deckhouses.								
	Coaming	Plating	Stiffeners	Spacing	End Attachments of Stiffeners	Size of Openings	Height of Sills	Height of Casings
Poop Bulkhead								
Raised Quarter Deck Bulkhead								
Bridge, After Bulkhead								
Bridge, Forward Bulkhead								
Forecastle Bulkhead						54" x 25"	25"	
Trunk, Aft								
Trunk, Forward								
Exposed Machinery Casings on Freeboard or Raised Quarter Decks								
Exposed Machinery Casings on Superstructure Decks								
Machinery Casings within Superstructures not fitted with Class I Closing Appliances								
Deckhouses on Flush Deck Ships								
Particulars of Closing Appliances (state if capable of being manipulated from both sides).								
Poop Bulkhead								
Raised Quarter Deck Bulkhead								
Bridge, After Bulkhead								
Bridge, Forward Bulkhead								
Forecastle Bulkhead								
Exposed Machinery Casings on Freeboard or Raised Quarter Decks								
Exposed Machinery Casings on Superstructure Decks								
Machinery Casings within Superstructures not fitted with Class I Closing Appliances								
Deckhouses on Flush Deck Ships								

Odddevold.

PARTICULARS OF PROTECTION TO OPENINGS, ETC.

The following diagrams should be used to indicate the positions of cargo and coaling hatchways gangway, cargo and coaling ports, ventilators, companionways, etc., which would affect the seaworthiness of the ship:—

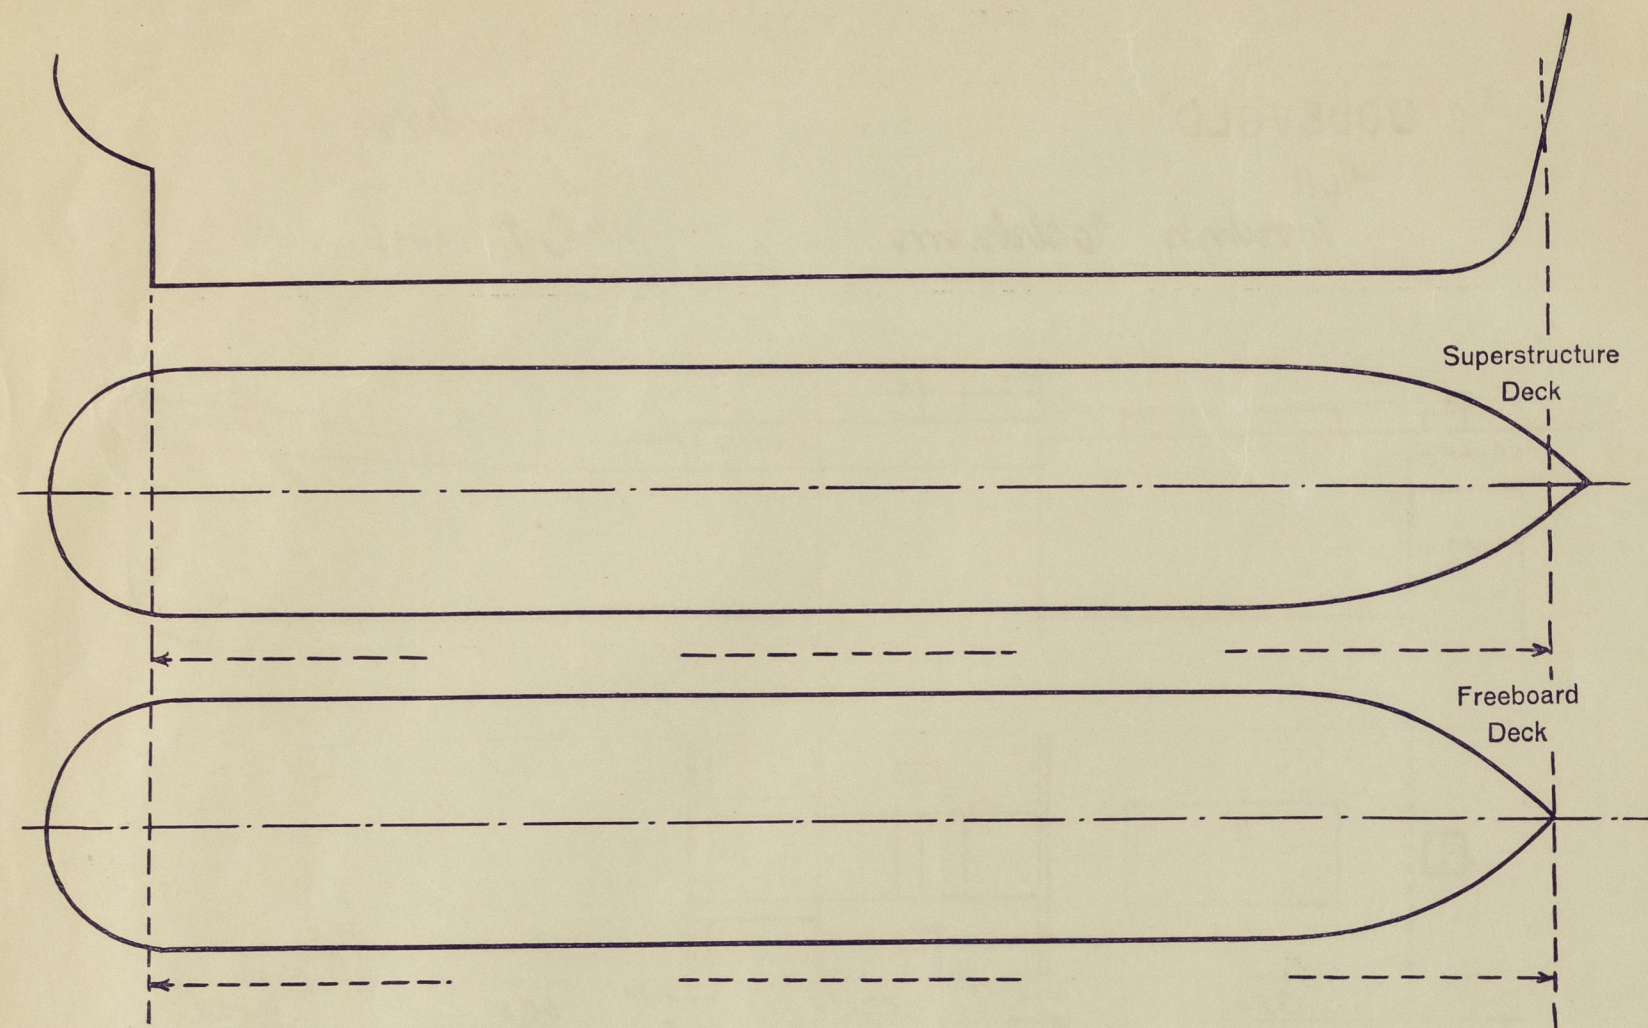

Particulars of fiddle, funnel and ventilator coamings, engine room skylight and other openings in machinery casing tops and their means of closing:—

Particulars of Flush Bunker Scuttles:—

Particulars of Companionways:—

Particulars of Ventilators in exposed positions on freeboard and superstructure decks:—

Particulars of Air Pipes in exposed positions on freeboard, raised quarter, or superstructure decks:

Particulars of Gangway Cargo and Coaling Ports:—

Particulars of Scuppers and Sanitary Discharge Pipes:—

Particulars of Side Scuttles:—

Vertical distance of Sill of lowest Scuttle above top of keel

Particulars of Guard Rails:—

Particulars of Gangways, Lifelines, etc.:—

Particulars of Freeing Arrangements.

	Length of Bulwark	Height of Bulwark	Size of Freeing Ports	Number each side	Area each side	Rule area each side
After Well						
Forward Well						

State position of each freeing port } After Well:—
(F. and A. position and height above deck edge) } Forward Well:—

State whether the freeing ports are fitted with shutters, bars, or rails, and give particulars of such:—

Additional area where sheer is less than standard.

PARTICULARS OF PROTECTION TO OPENINGS, ETC.

Hatchways on Freeboard and Superstructure Decks.									
Description of Hatchway	No. 1	No. 2	No. 3	Forecastle.					
Dimensions of Hatchway			34 1/2' x 16'	700 x 450 mm.					
COAMINGS			800 mm. ✓ 11 mm. ✓ 11 mm. ✓						
{ Height above Deck									
{ Thickness { Ends									
{ { Sides									
Stiffeners	180 x 90 x 11 L		200 x 75 x 12 L						
Brackets, Stays	1 ✓	2 ✓	3 ✓						
HATCH BEAMS			4.7' - 5' ✓ 90 x 90 x 11 ✓ 370 x 10 pl. ✓ 190 x 16 pl. ✓ 3" ✓						
{ Number									
{ Spacing									
{ Scantling and Sketch									
{ Bearing Surface									
FORE AND AFTERS			None ✓						
{ Number									
{ Spacing									
{ Unsupported Lengths									
{ Scantling* and Sketch									
{ Bearing Surface									
HATCH COVERS			Wood ✓ 2 1/2" ✓ F. & A. ✓ 3" ✓	Steel Hinged W.T. cover. ✓					
{ Material									
{ Thickness									
{ How fitted									
{ Bearing Surface									
Spacing of Cleats			24" ✓						
Number of Tarpaulins			2 ✓						

*) Are wood fore and afters steel shod at all bearing surfaces?
Are tarpaulins in good condition and in accordance with rule requirements?
Are battens and wedges efficient and in good condition?
Are lashings provided in accordance with rule requirements?

Particulars of any special features:—

Endorsement at first surveys and at surveys for renewal of Certificate:—

The fittings and appliances are in accordance with the particulars shown on this form (or as now modified) and are in good condition.