
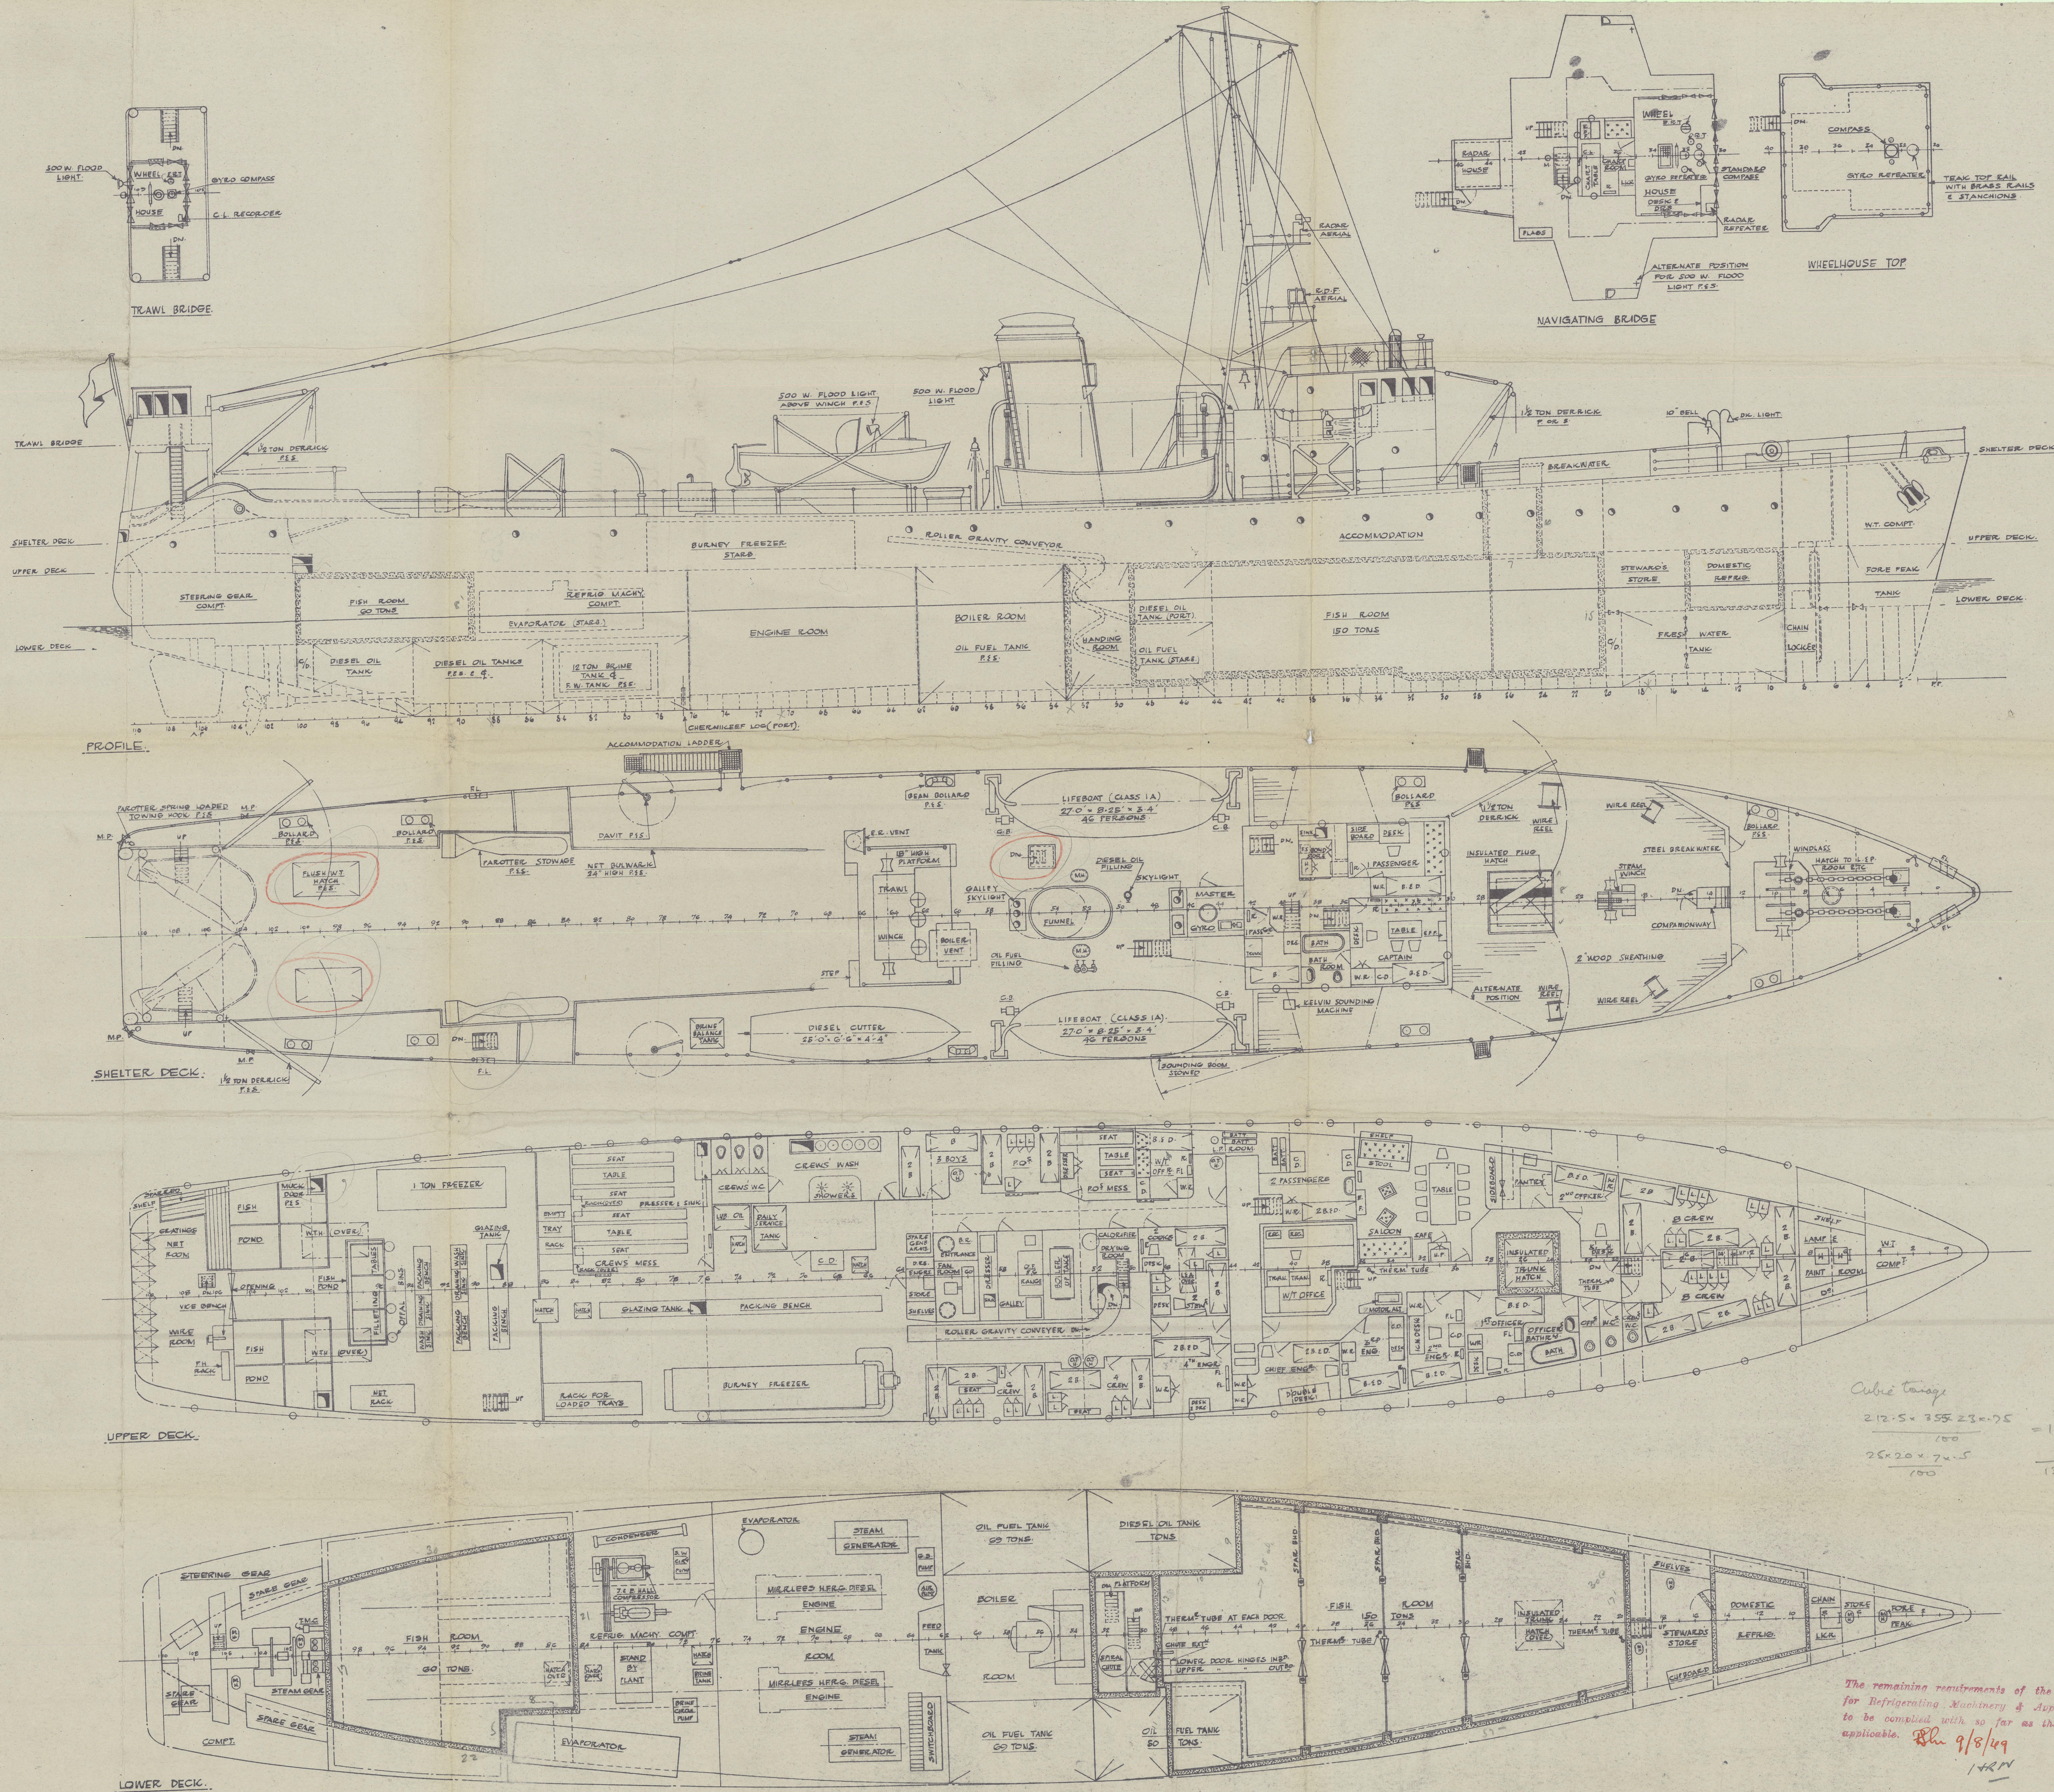


T.S.F.V. 'FAIRFREE'

GENERAL ARRANGEMENT.

SCALE: 1/8" = 1 FOOT.

DIMENSIONS: 212'-6" B.F. x 35'-6" x 23'-0"

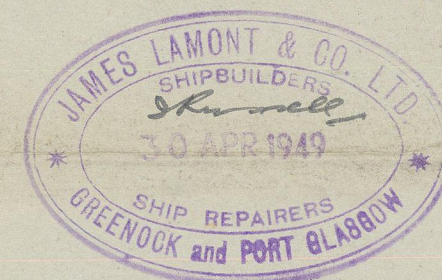

Cubic Tonnage
 $212.5 \times 35.5 \times 23.0 = 1318$
 $25 \times 20 \times 7 \times 5 = 1750$
 $1750 \div 100 = 17.5$
 $1318 + 17.5 = 1335.5$

The remaining requirements of the Rules for Refrigerating Machinery & Appliances to be complied with, so far as they are applicable. Rln 9/8/49
 14211

25

General Arrangement.

(2nd Conversion)

J. Lament & Co

T^{am} FAIRFREE

✓

Handwritten signature



© 2021

Lloyd's Register
Foundation

002229-002231B-0043