


"FELICITY" SO. 1228

GENERAL ARRANGEMENT

PROFILE

SCALE - 1/4" INCH = 1 FOOT

 

EQUIPMENT NO
 $\frac{214.5 \times 23.5 \times 35.5 \times 75}{100} = 1345 \times 1$
 $\frac{24.5 \times 19.5 \times 7.5 \times 5}{100} = \frac{18}{13.63}$

$\frac{214.5 \times 17 \times 35.5 \times 16}{100} = 775$
 $\frac{214.5 \times 15.5 \times 8 \times 17.5}{100} = \frac{304}{1079}$

6016
25 NOV 1946

6.12.46

A WHITE

Profile

"Felicity"


25 NOV 1946

Bay



© 2021

Lloyd's Register
Foundation

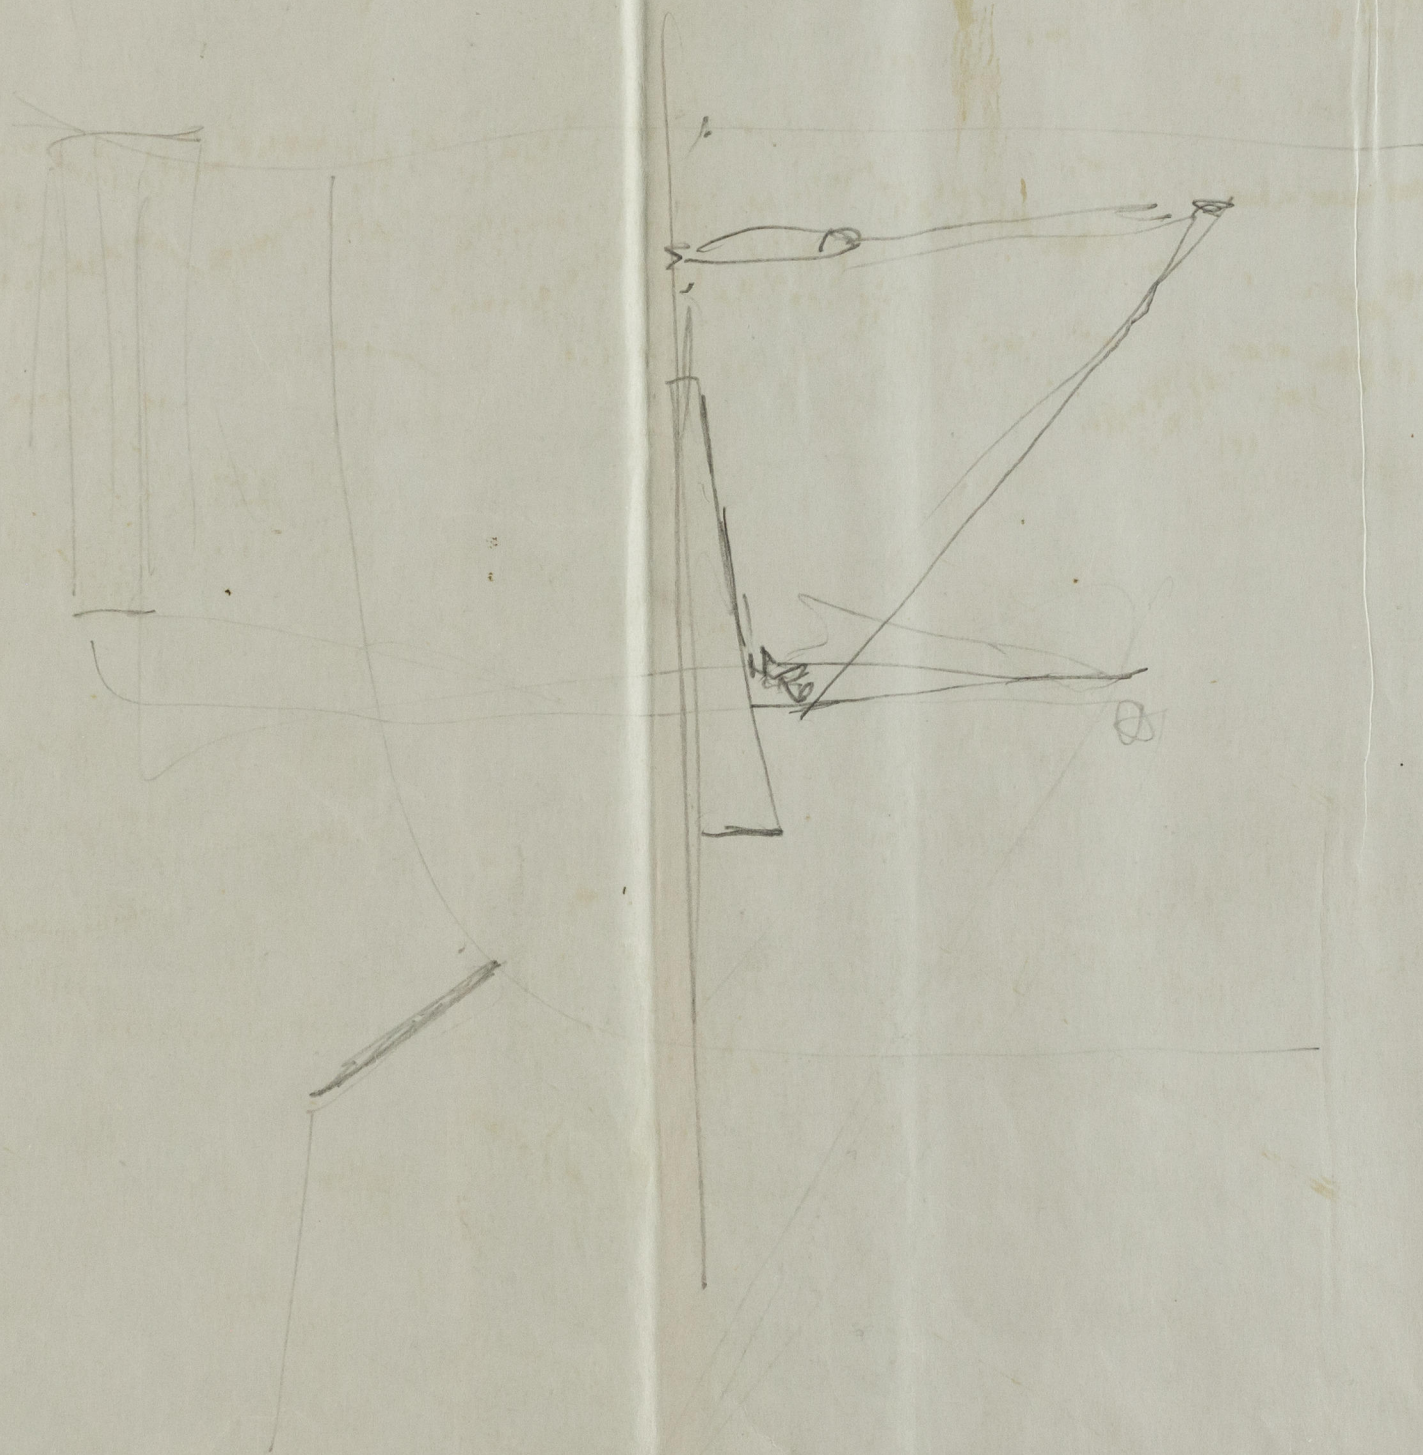

© 2021

Lloyd's Register
Foundation

1.

General Origl - Profile.

⁴ Fairfield S & Co.

FAIRFREE

T.S.S. ^{EX} FELICITY. ~~NOW FAIRFACE~~

6.12.16.



© 2021

Lloyd's Register
Foundation

002229-002231B-0050