


^a Part electrically welded including deck

EQUIPMENT AS PER RULES.

FEED HELD AT SHIP ✓ is to be submitted

CONTINUOUS WELD
SIDE TO SIDE

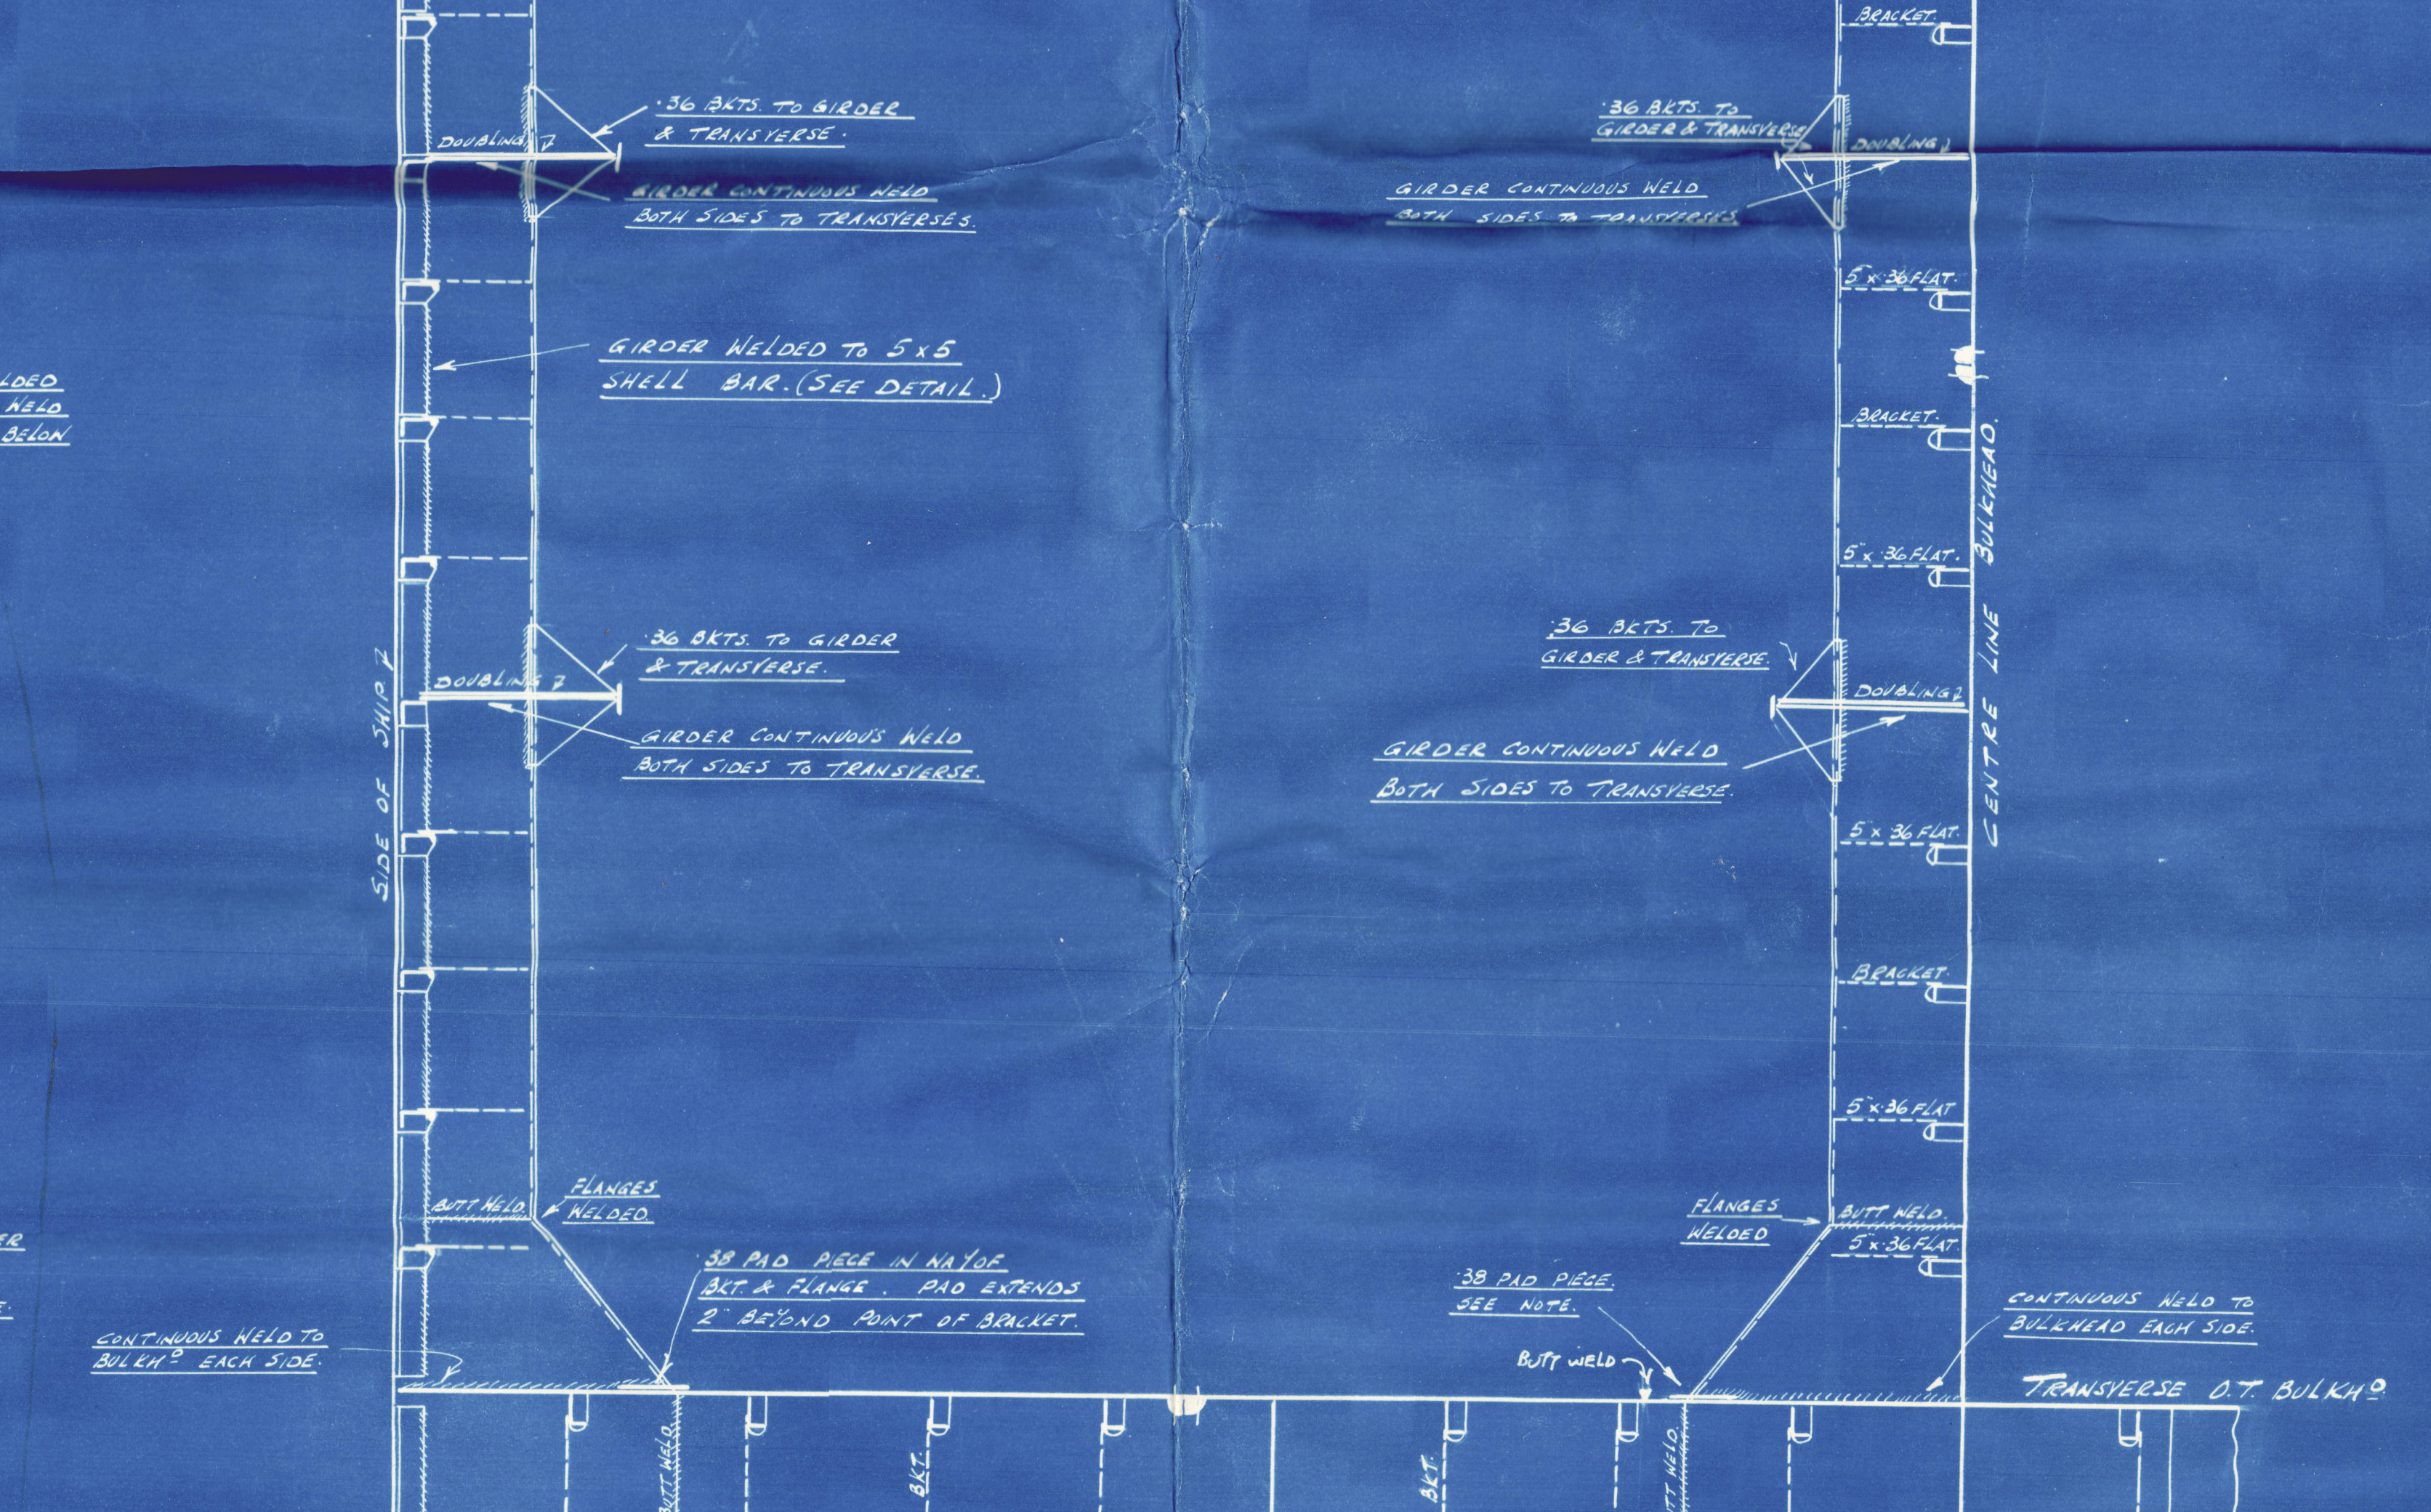

FLANGES Welded

T.S.S. "AVILA"

Messrs. Smith's Dock Co. Ltd., Yelk 1038.


Midship. profile & decks.

ESSO EL SALVADOR

EX

S.S. "Avila"

HDB. RPT. No. 16386

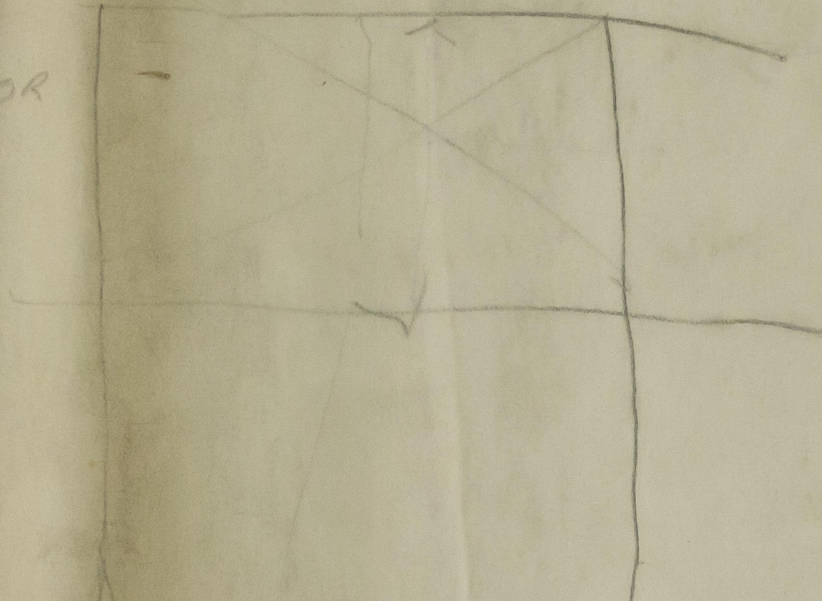

008

002232-002240-0001

002232-002240-0001


- WELDED BUTT
- 6" x 40" FLAT.
- 39"
- NO. 3 TANK
- 2 COMPLETE
- 115. 42" DIAS CR
- 0 TO WEB
- 0 BOTH SIDES
- 36 DKT.
- EACH SIDE
- STEEL .36.
- 4" x 36.
- 4" x 40" FLAT.
- THICKNESS
- DOUBLE RIV
- TRIPLE RIV
- AKES A.B.
- 37A
- 3 x 32 x .50
- 38
- "A"