


Lloyd's Register of Shipping.

Ship's Name "FOLDA"Official No. 145981

Memorandum of alterations reported since ship was surveyed for assignment of Load Lines
in _____

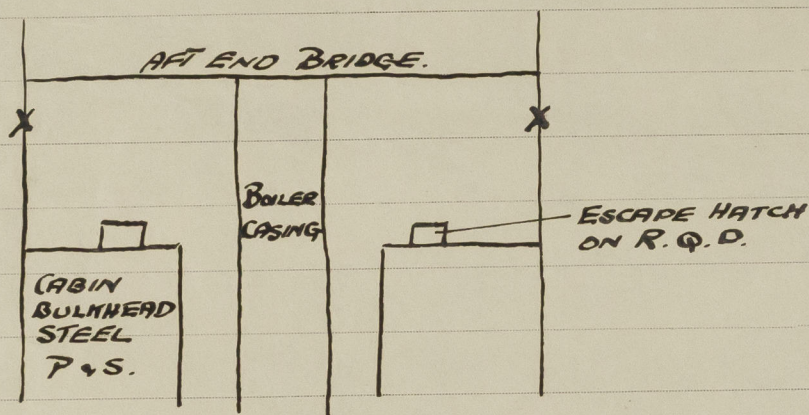

SKETCH SHOWING POSITION OF ESCAPE HATCHES 17/4/39.

It is noted that the escape hatches to bunkers (P.S.) fitted 17/4/39 in way of Cabin bulkhead in recess passage to ash shoots on R.Q.D., size 23" x 18", have been modified by the construction of trunkways extending through to the wood deck. Closing arrangements have been provided by the fitting of flush bunker scuttles. These were found without chain attachments, but have now been fitted.

R. W. Stonehouse

*Noted
10/3*

15 JUL 1940