


No. 555.

DIMENSIONS:- 142'-6" B.P. x 25'-0" B.M.L.D x 15'-0" D.M.L.D.

SCALE  $\frac{1}{4}" = 1 \text{ FOOT}$ .

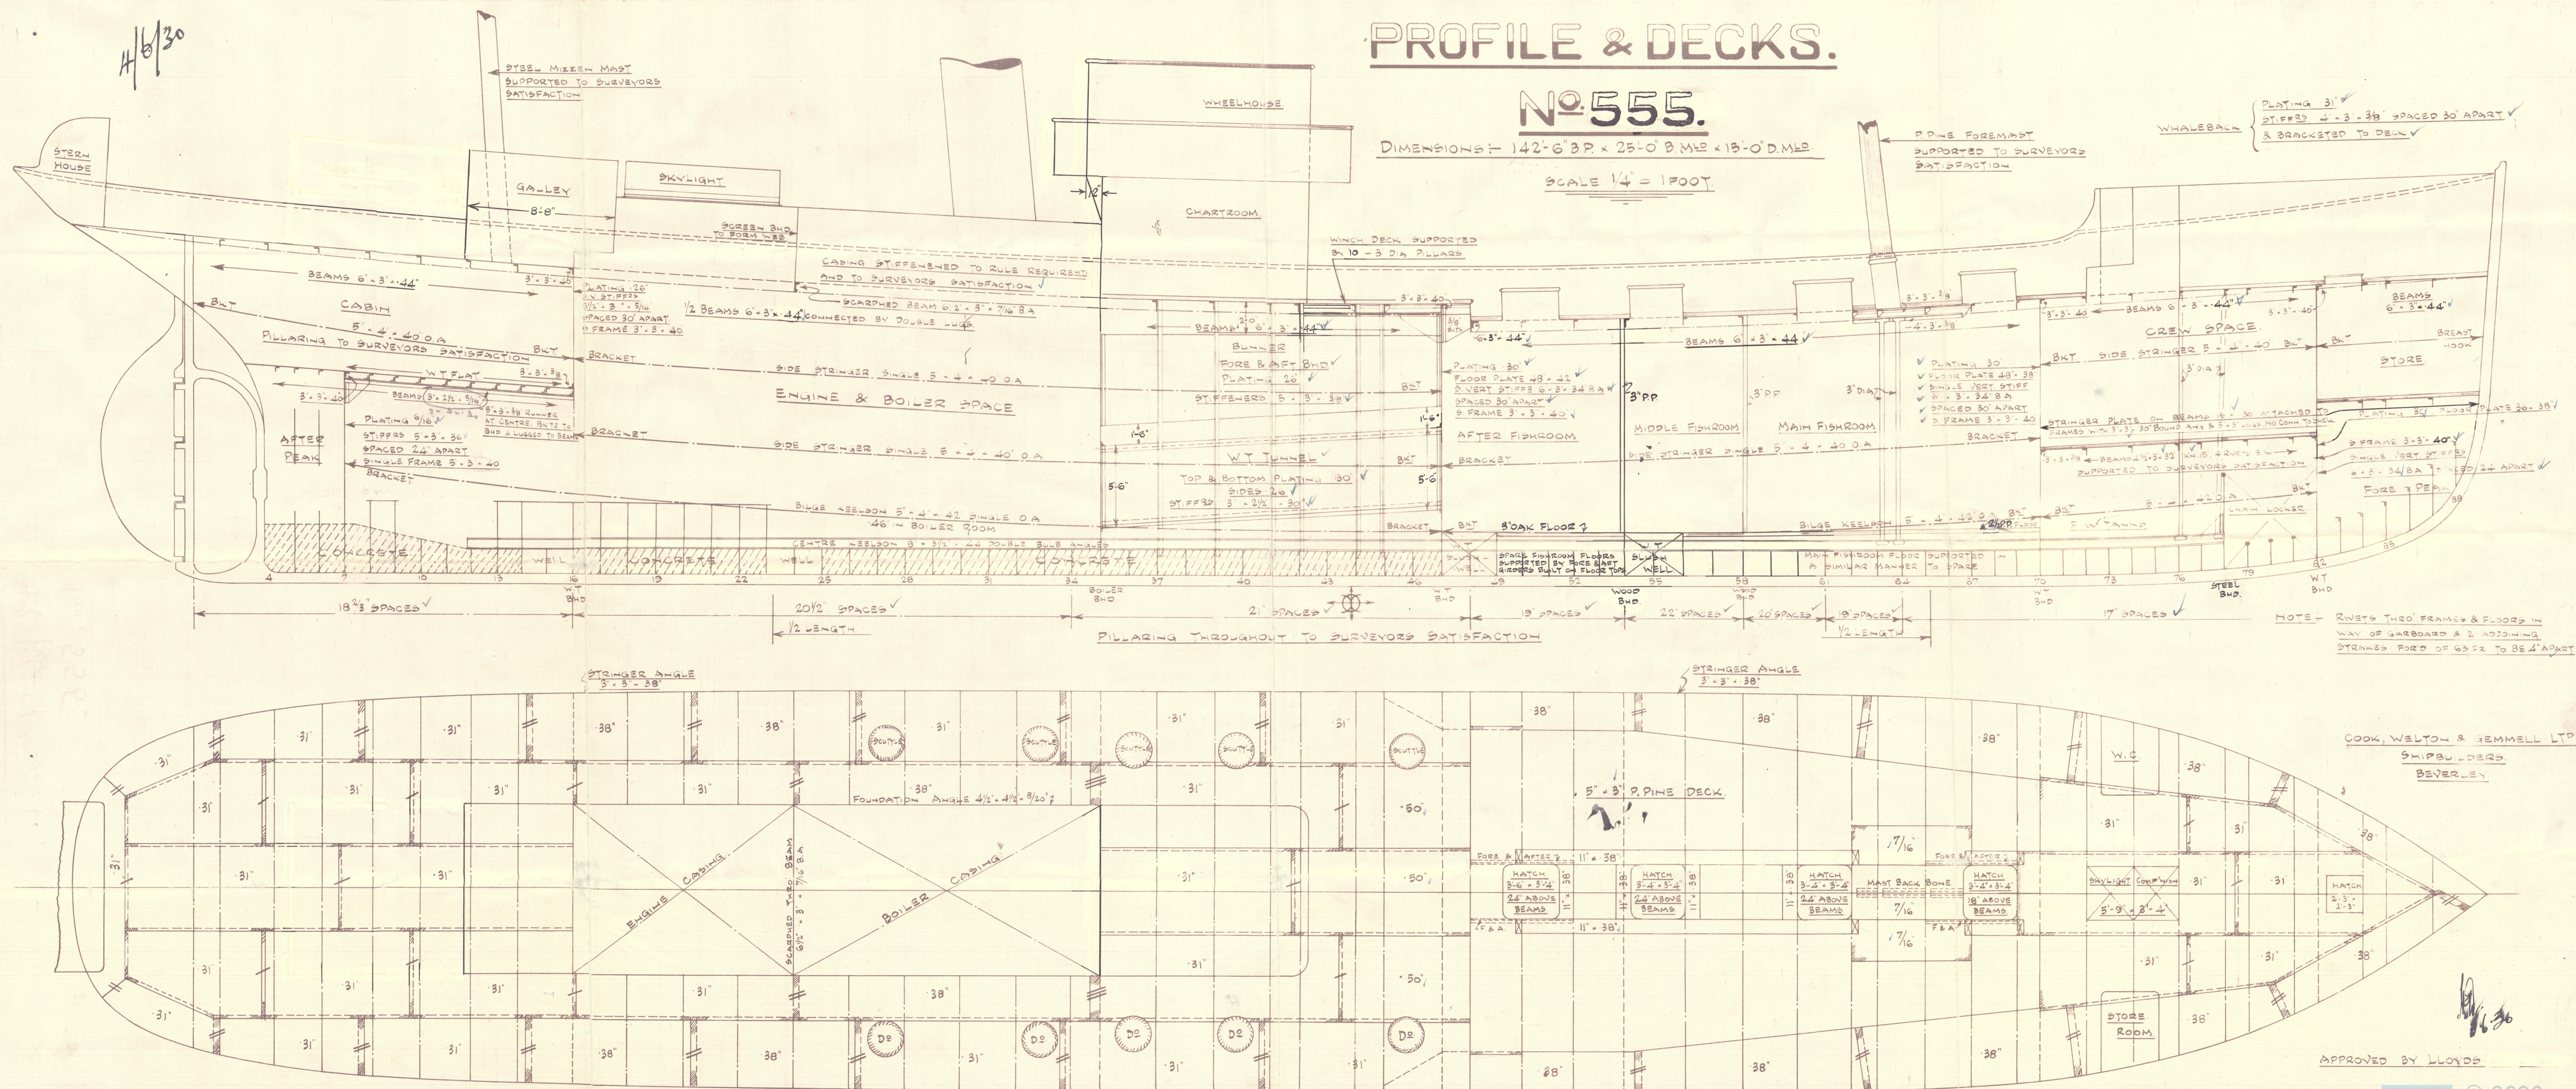

COOK, WELTON & GEMMELL LTD  
SHIPBUILDERS.  
BEVERLEY

APPROVED BY LLOYDS



Cook, Wilton & Gemmell, Ltd..  
Beverley

Profile & Deck.  
No. 555-

3.8.	"Granypian" ex. K opanes
HULL REPORT No. 21316	

NN FROBISHERX



© 2020

Lloyd's Register  
Foundation

002232-002240-0143