
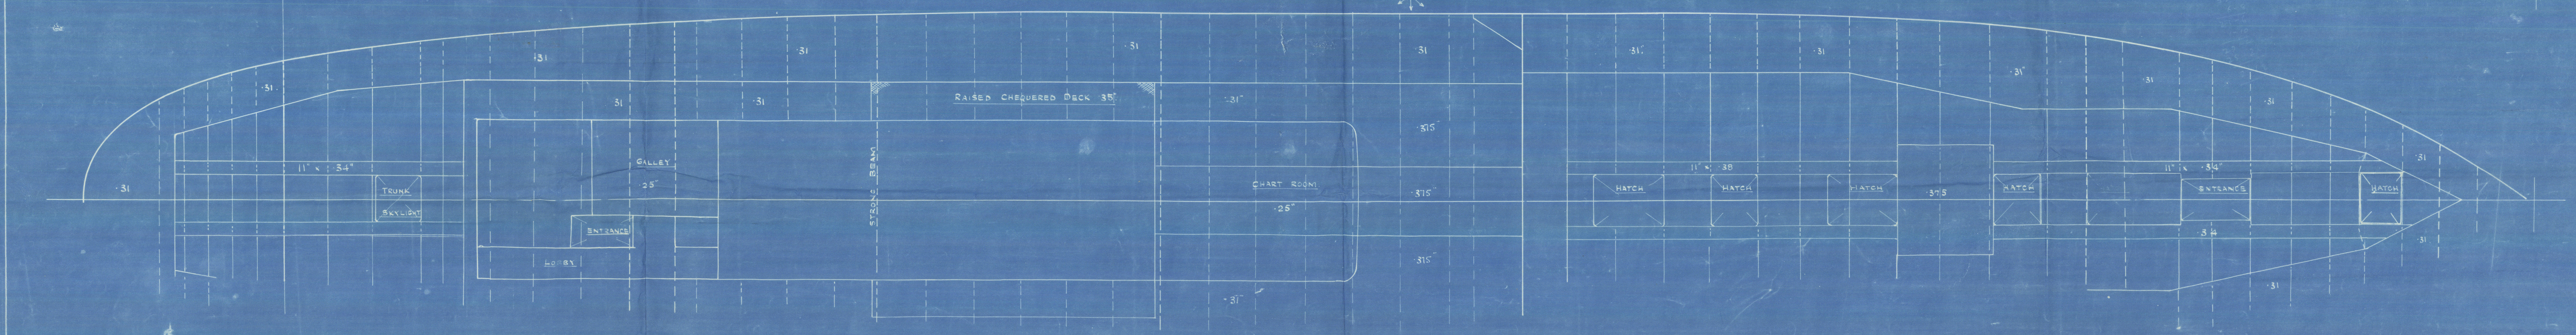


Profile of Deck
115.1

PROFILE E' DECK - No 1127. - 160'-0" B.P. x 26'-6" MLD. x 15'-0" MLD.

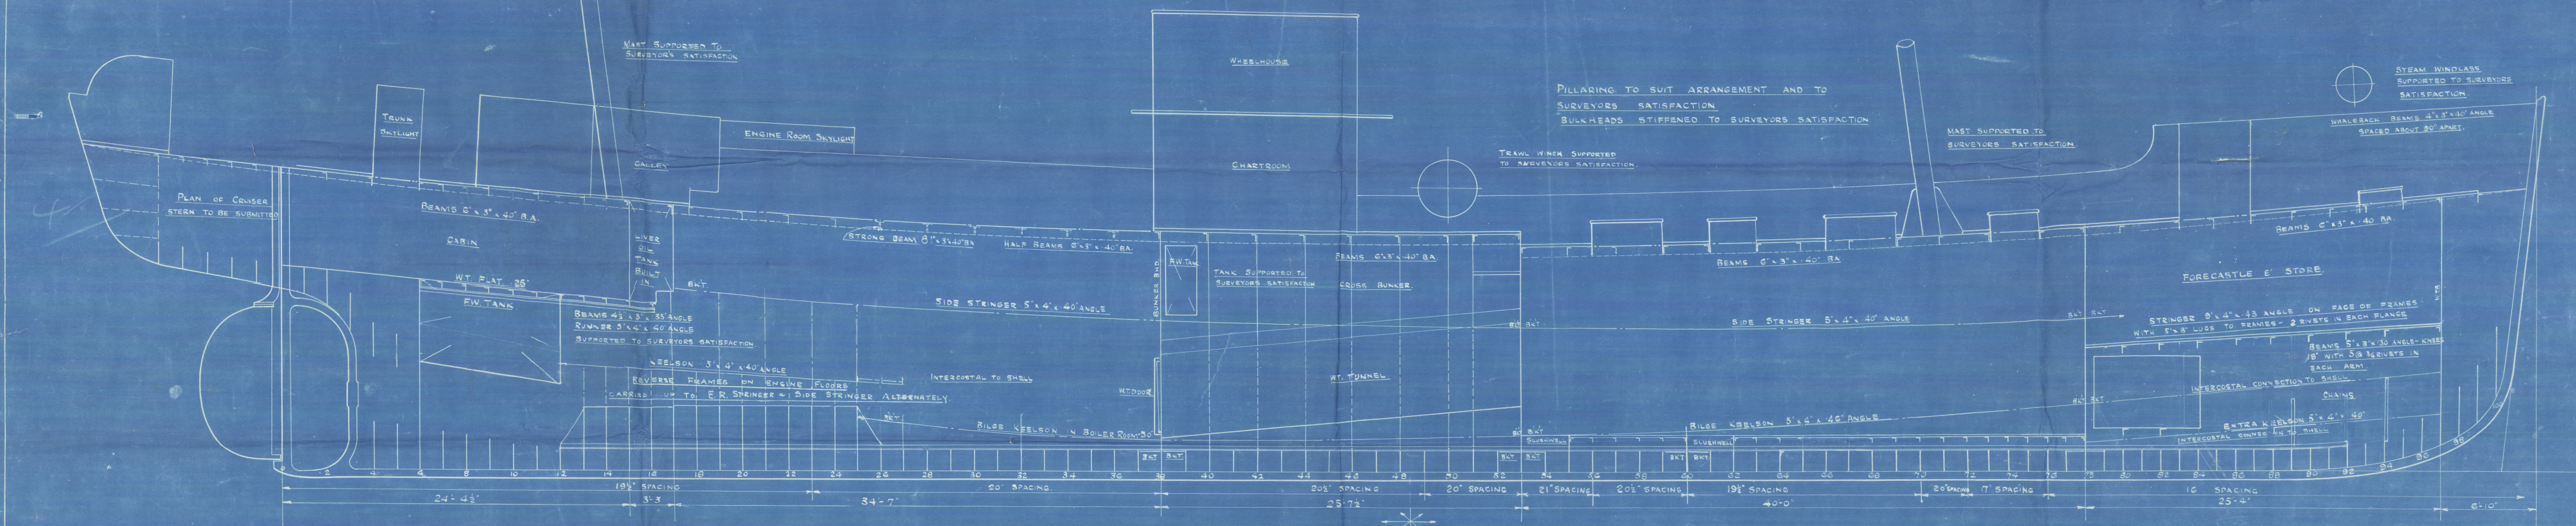

Profile of Deck
115.1

Profile of Deck
115.1

Profile of Deck
115.1

No. 1127

Profile & Deck
(as built)

Cochrane & Sons Ltd

Glenella

SS.	Cape Barfleur.
2011	45237.

1124

Profile & Deck

PLAN No.	1922
FOR ENCLOSURE TO	MESDA LLOYDS
R.O.S.	HULL FROM
COCHRANE & SONS, LTD.	SHIPBUILDERS, SELBY.
DATE	20-10-24



© 2020

Lloyd's Register
Foundation

002241-002248-0078