


1.1 2

SCALE  $\frac{1}{8}'' = 1 \text{ FOOT.}$

N<sup>o</sup> 257

4. 7. 10  
4. 8. 10  
2. 9. 10  
24. 3. 11.

31709  
for work + material 4.2  
725 sh. H. 201  
—

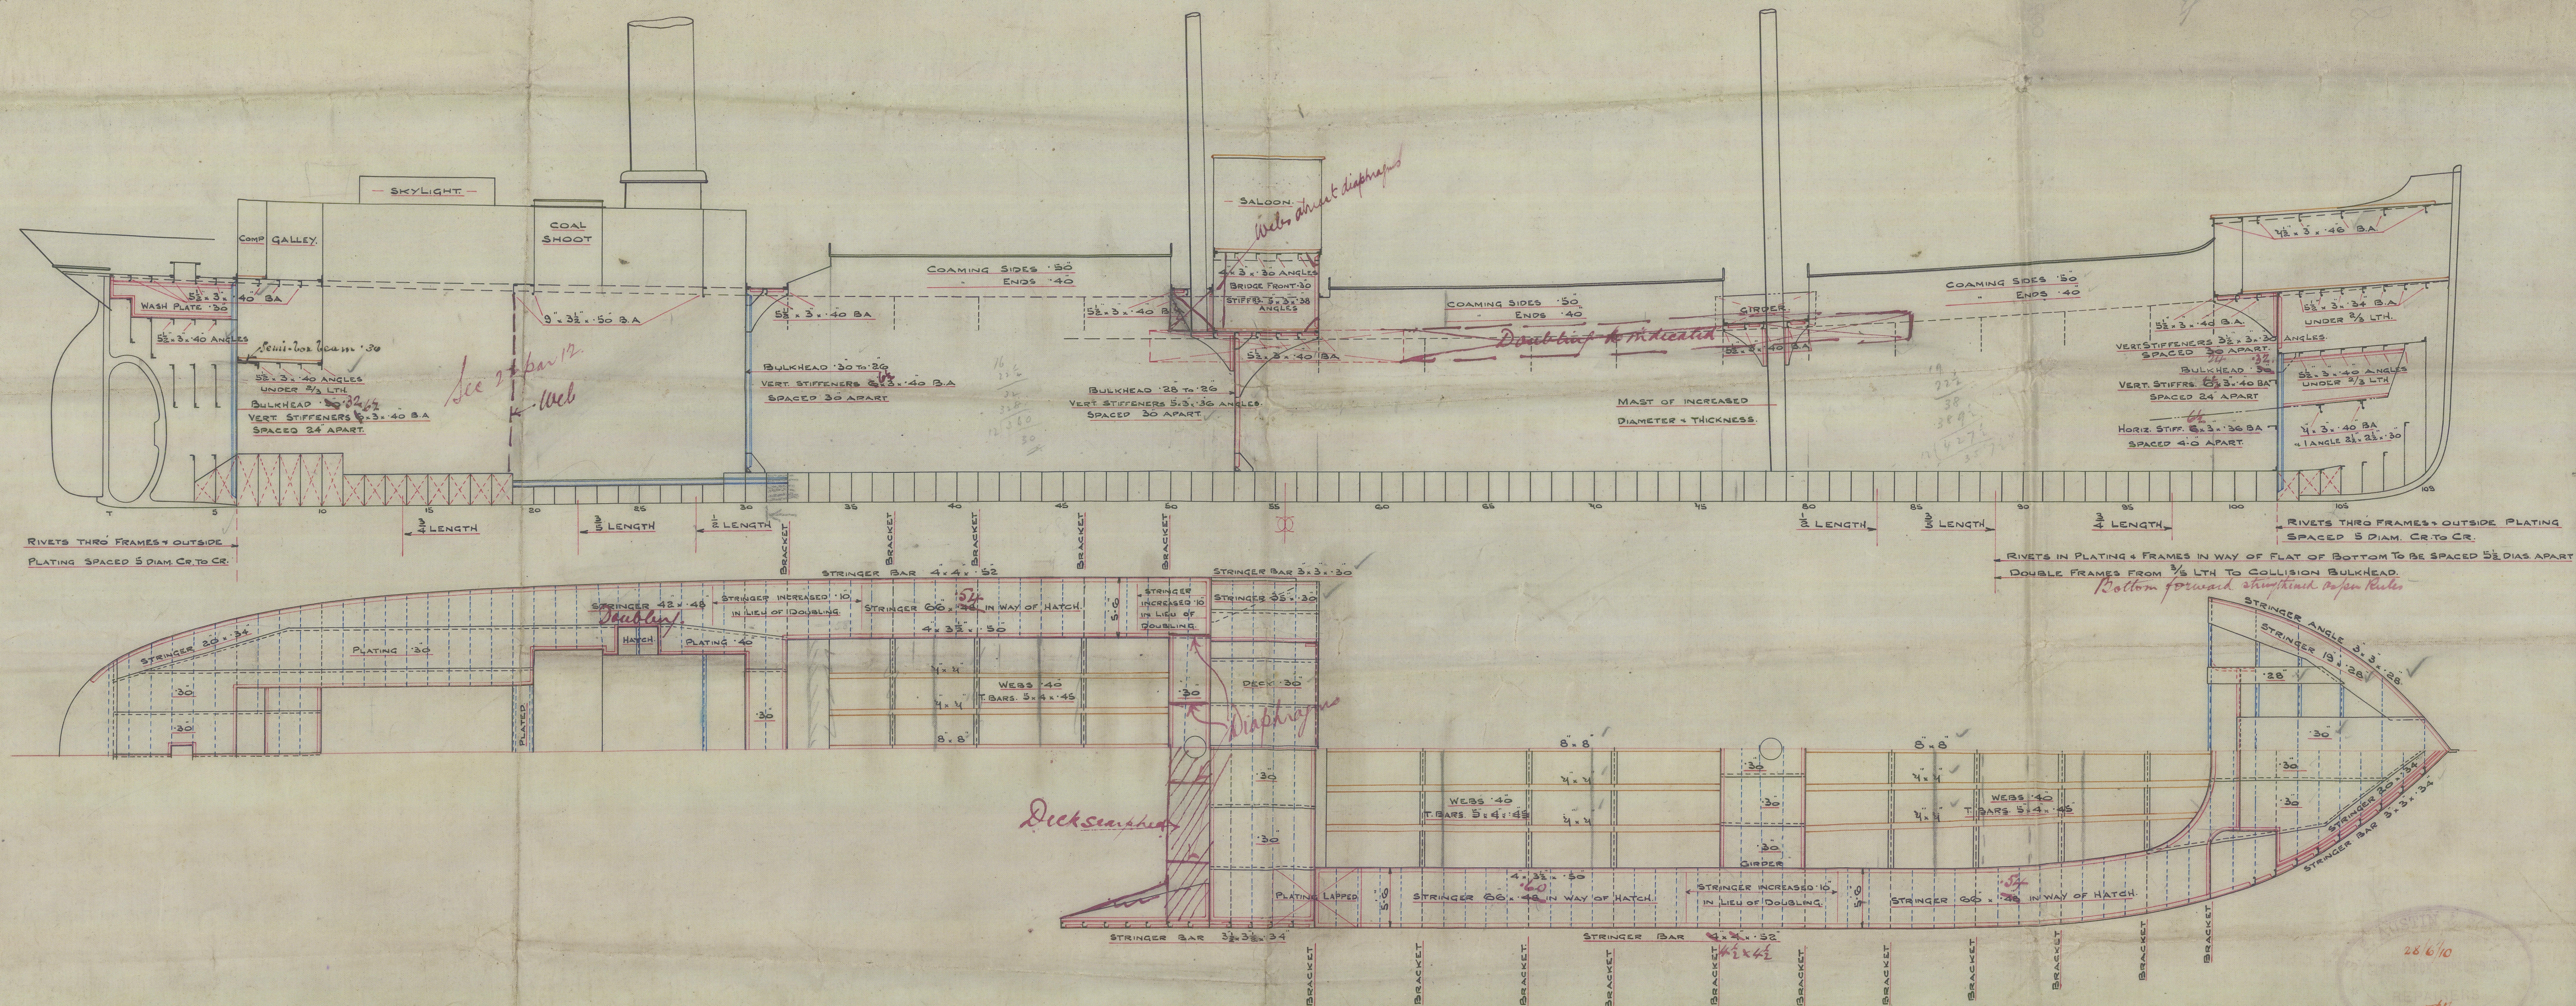

28/6/19

*T. 3. 7.*


C.F.  
462/10



PROFILE

S.P. Austin & Son Ltd

no A. N° 257

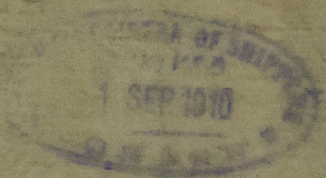

Sld Ford Rpt

no. 24768.

Rudmore

Sld rpt 24782



© 2020  
Yewhill

Lloyd's Register  
Foundation

002241-002248-0157