

— N°122 —

— MIDSHIP SECTION —

TO CLASS 100 A.1. \* AT LLOYDS FOR HOME & FOREIGN COASTING

DIMENSIONS — 212'-0" B.P. x 33'-6" x 15'-6" MLO

SCALE: 1/2" = ONE FOOT.

LLOYDS NUMERALS

$$B+D = 33.5 + 15.5 = 49$$

$$L \times (B+D) = 49 \times 212 = 10388$$

$$d = 15.5 - 2.66 \times 12.84 \text{ QUARTER DECK } 19.5 - 2.66 = 16.84$$

$$QUARTER DECK B+D = 33.5 + 15.5 = 49$$

$$L \times (B+D) = 49 \times 212 = 10388$$

$$\frac{L}{D} = \frac{212}{15.5} = 10.873$$

EQUIPMENT

LONGITUDINAL NUMBER	10388-00
RAISED QUARTER DECK	1025 x 4
BRIDGE DECK	13 x 7 x 75
FORECASTLE	34 x 25 x 75
CASINGS	40 x 25 x 75
ANCHORS	2 BOWER ANCHORS 2 1/2 CWTs STOCKLESS COLLECTIVE WEIGHT 66 3/4 CWTs
STREAM ANCHOR	6 CWTs EX STOCK
KEDGE	3
210 FTMS	1 1/4" STUD CHAIN CABLE
60 "	3/8" STEEL WIRE
30 "	3/4" TOWLINE
30 "	5" HAWSER
30 "	5" WARP

APPROXIMATE PARTICULARS FOR FREEBOARD.

SHEER. AT STEM = 66; AT STERN = 36; MEAN = 51 INCHES.

THE SHEER IS OF A GRADUAL CHARACTER.


ERECTOR. R.O.D. 116.9; B. 15.0; F. (cm) 28.2 - 160 FT. - 7.54 TENTHS OF L.

RISE OF SHEER FROM MIDSHIPS TO FRONT OF BRIDGE = 5 1/2 INCHES.

TONNAGE COEFFICIENT, CORRECTED FOR D.B. (say) .8


ESTIMATED FREEBOARD. FROM STATUTORY DECK BAR. WINTER. 1.0 SUMMER. 0.10

see freeboard assignment.

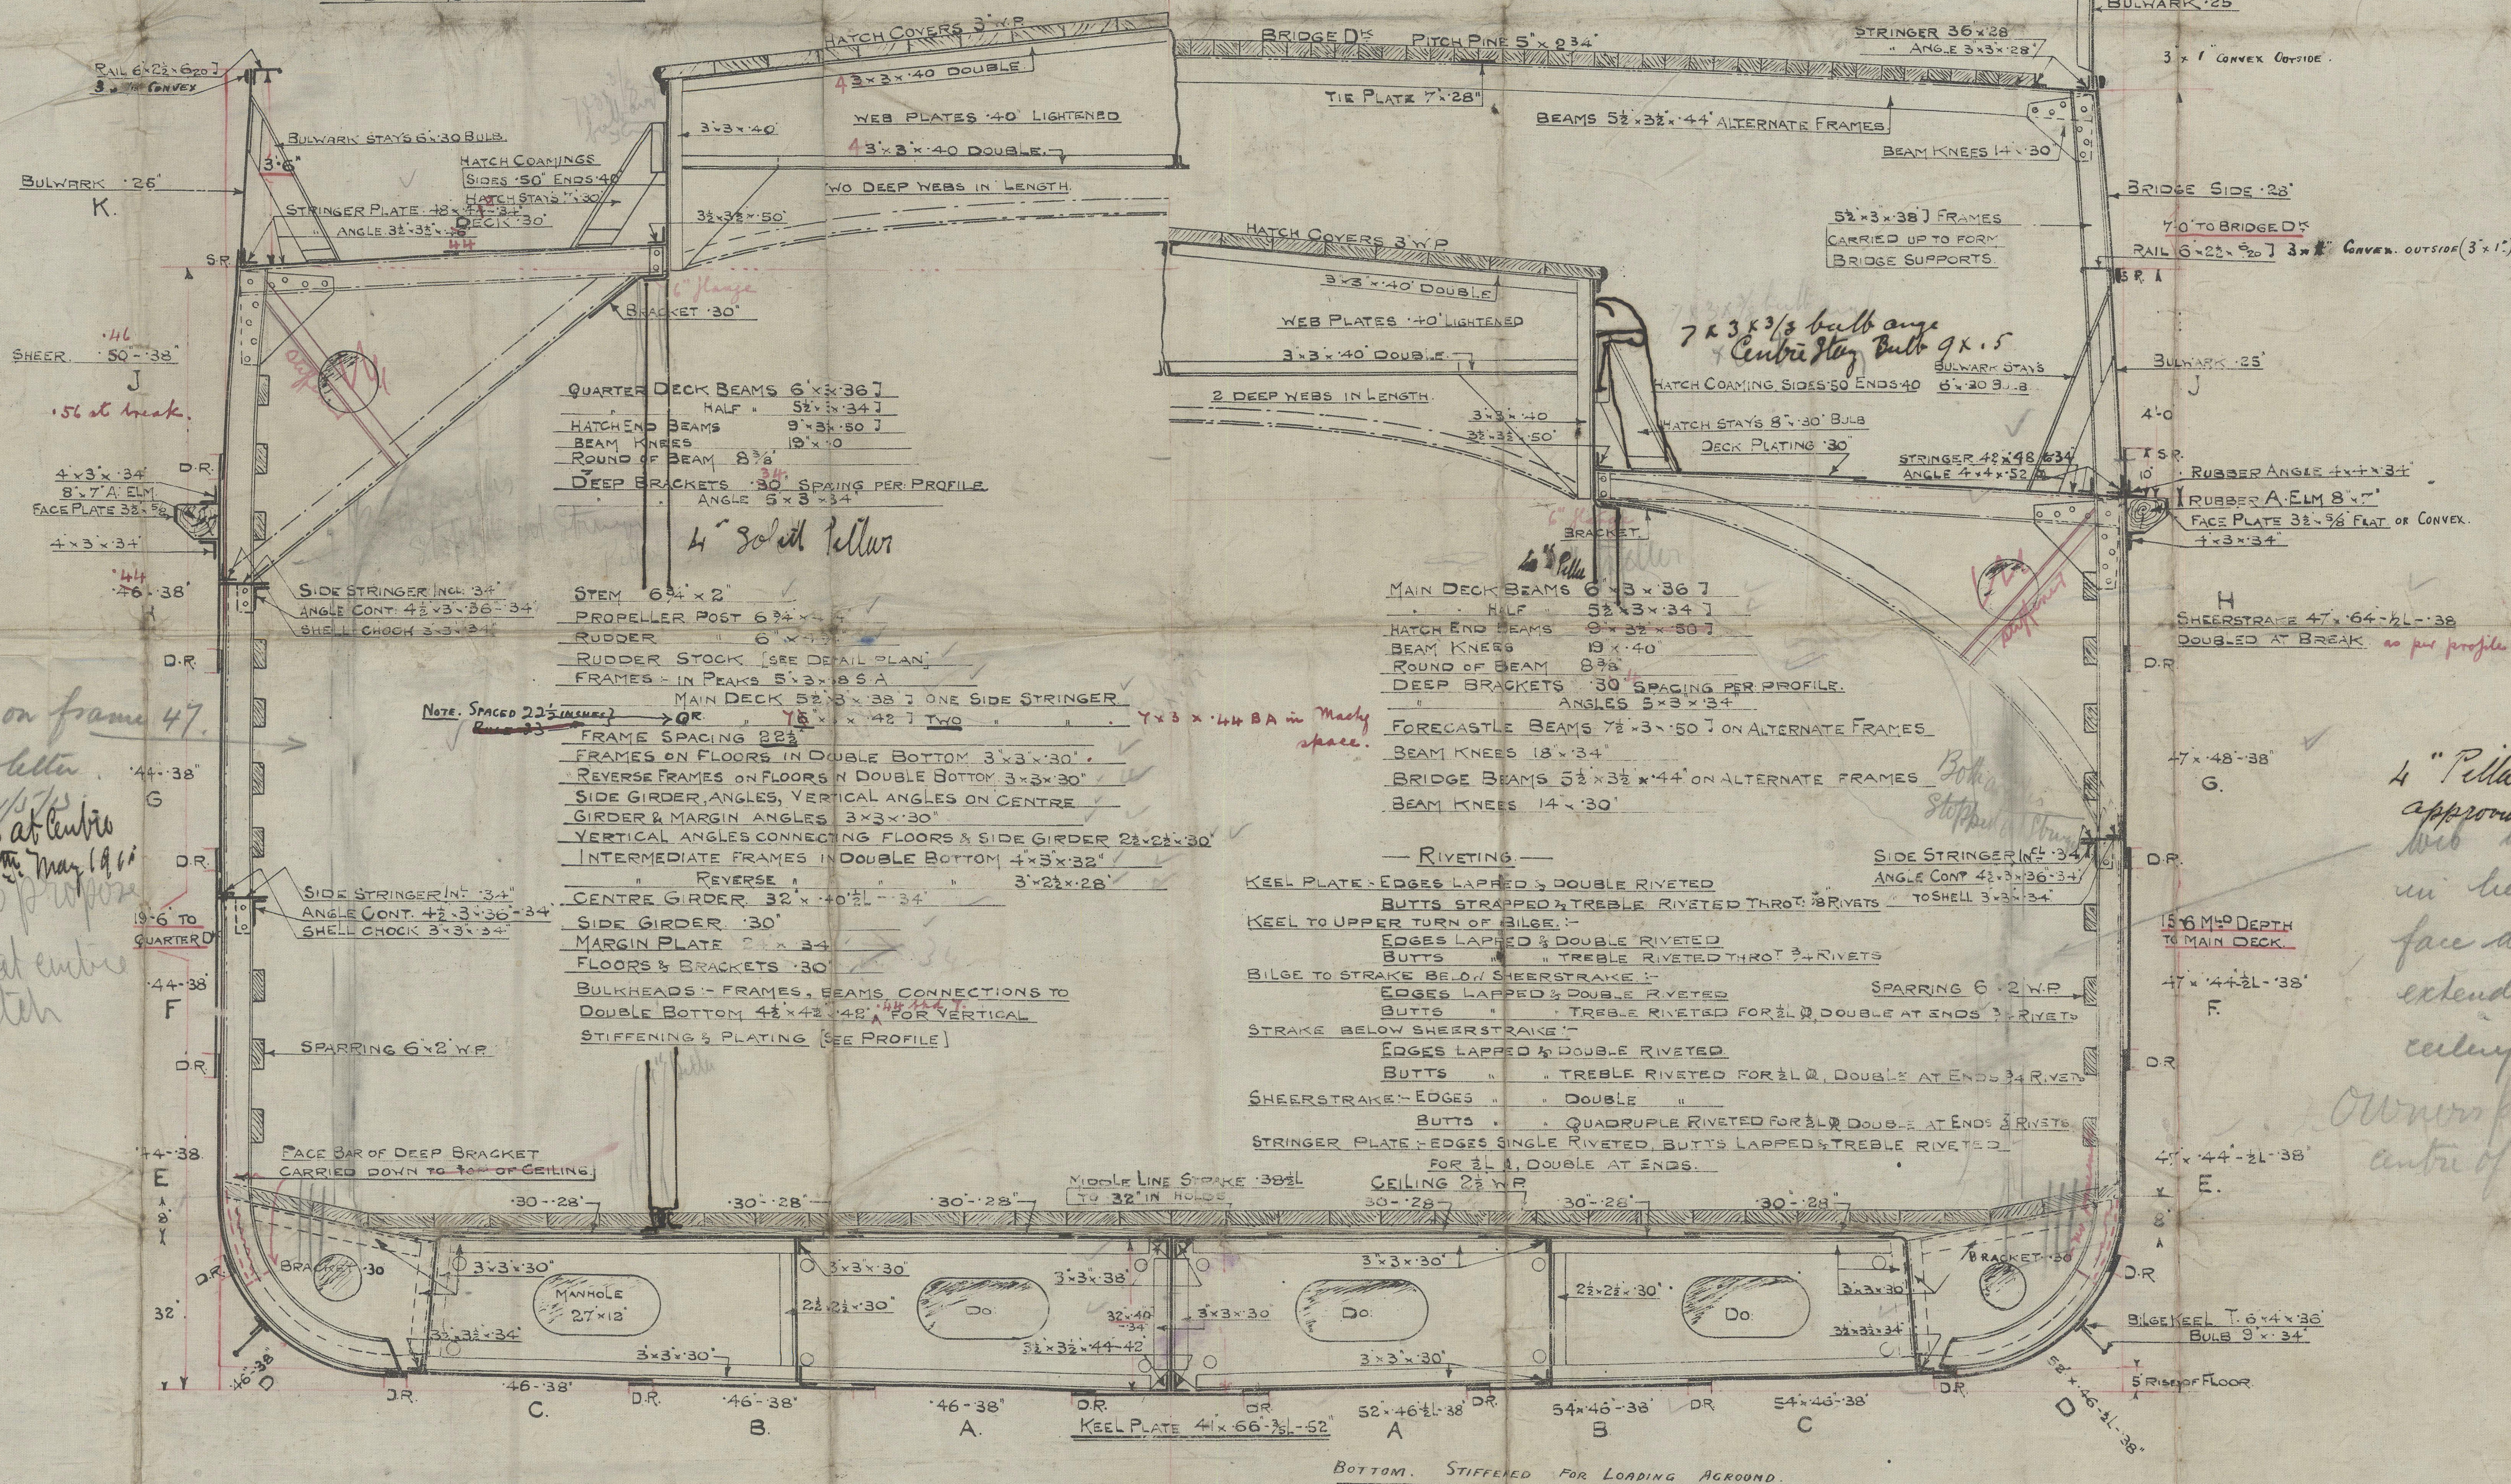

APPROX. SECTION IN WAY OF BOILER ROOM.

SECTION AT INTERMEDIATE FRAME.

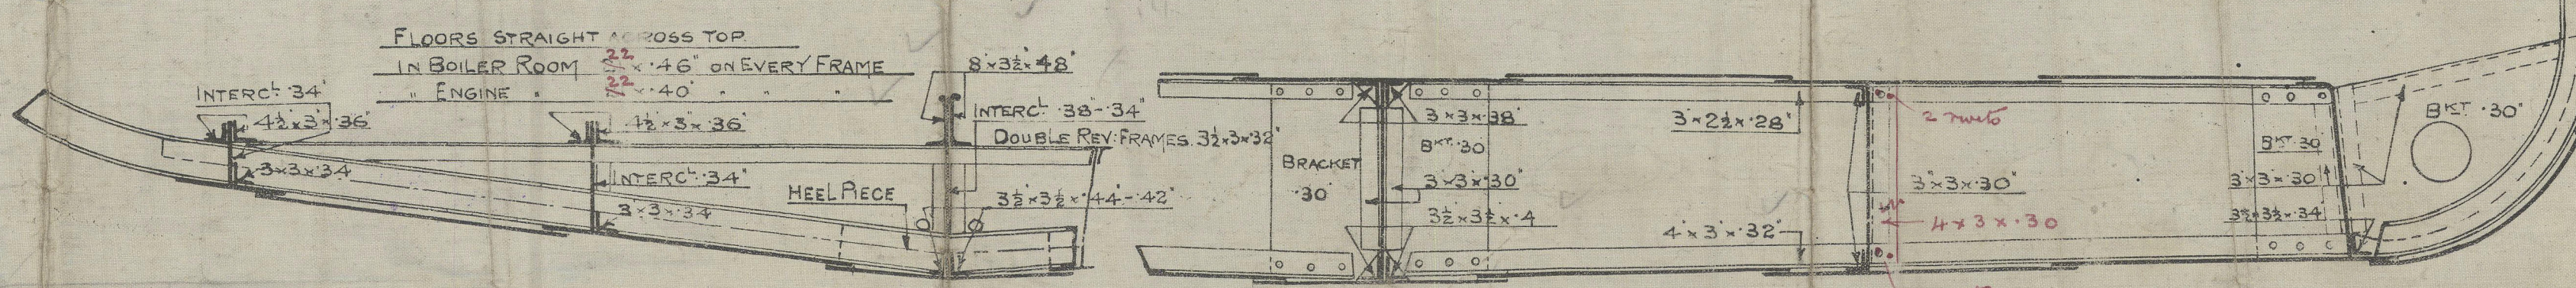

CHARLES HILL & SONS.

ALBION DOCKYARD.

BRISTOL.



© 2021


Lloyd's Register Foundation

00244002570001

H. A. Mackie M.I.N.A.  
50 Wellington St  
Glasgow  
21/4/11



Bristol  
Messrs C. Hill & Sons  
5/5 N<sup>o</sup> 12 2  
Middship Section  
F.A.D.S.  
29.4-13

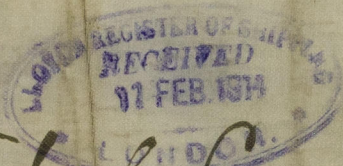

"Welsh Coast"  
Rrs 9578.

N.N.

Melito

N.N.

Fairwood Oak

n/a

"HOLDEVALE" X



© 2020

Lloyd's Register  
Foundation

000249-002284-0005