


This vessel similar to
No 881-2
"Southern Flower" & show
except 2 frame space
inserted & 6" narrower

N^o 906-7 SHIPS. MIDSHIP SECTION.

SCALE: $\frac{1}{2}$ " = 1 FOOT.


DIMENSIONS: 142'-0" O.A. x 25'-6" MLD. x 14'-6" MLD.
136'-0" B.P.

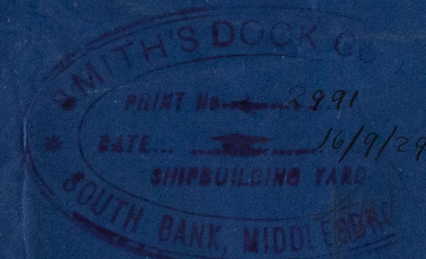

18 SEP 1929



$136(200 + 14.7) = 5449$
Latter f

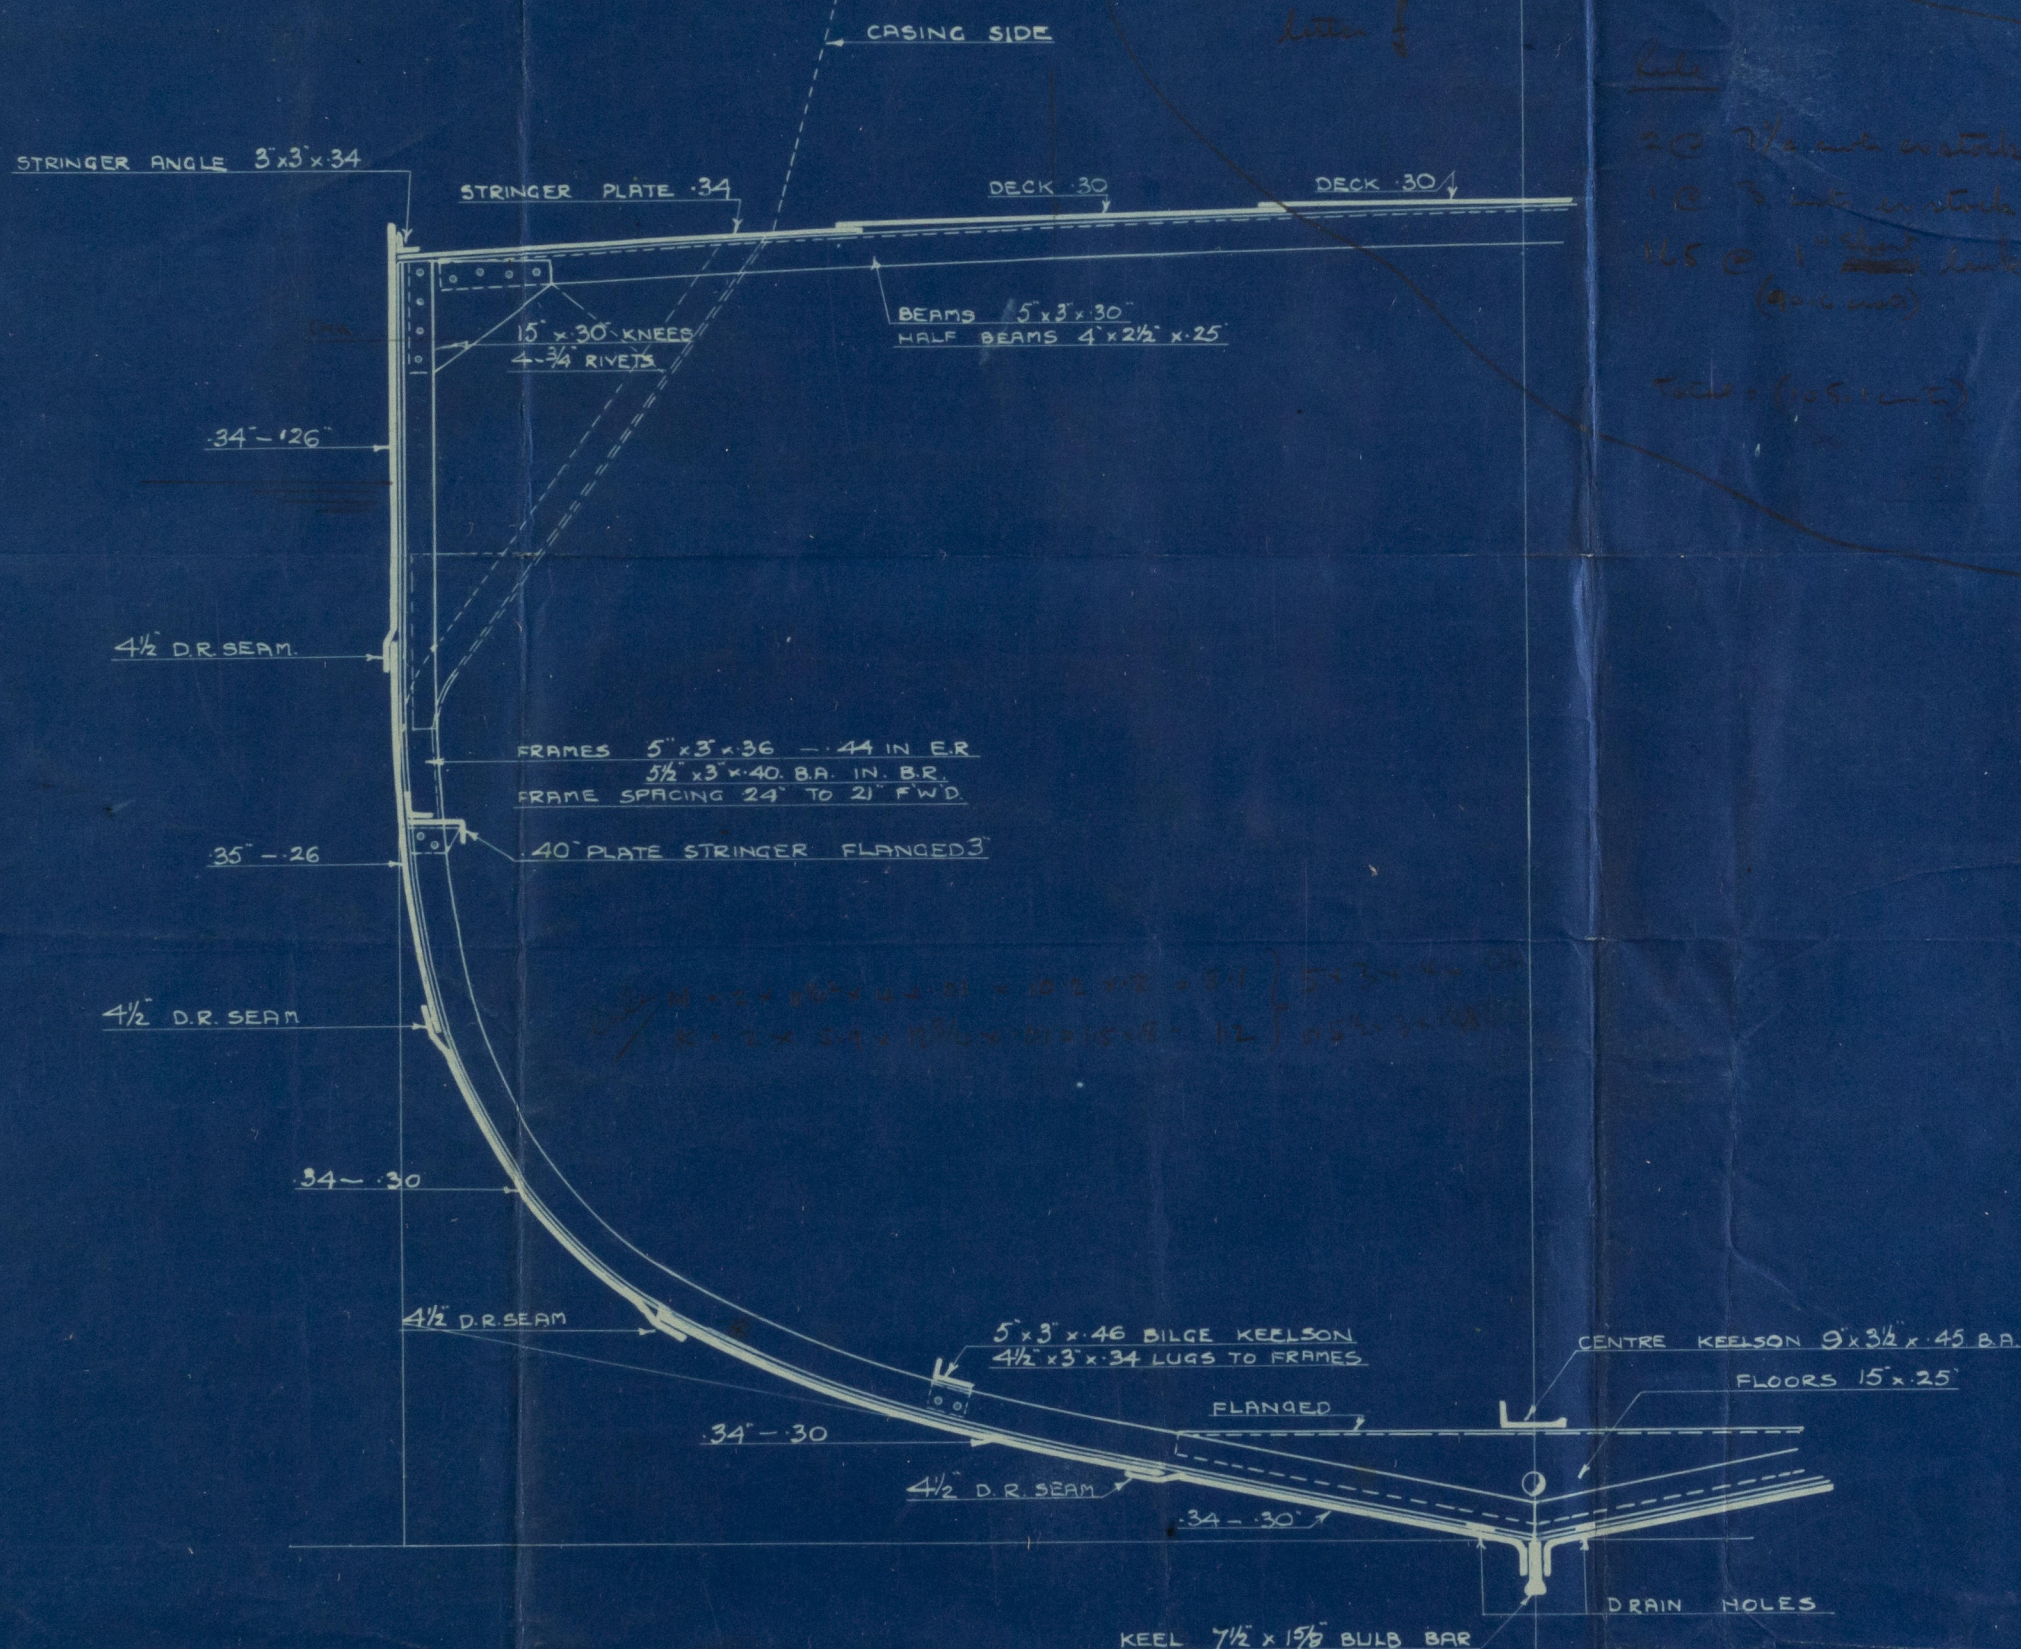

Rule
20 7 1/2 inch in stock
10 7 inch in stock
165 @ 1 inch in stock
(4-1/2 inch)
Total = 1105.1 inch

Ship
10 9 1/2 inch in stock
10 6 1/2 inch in stock
15 4 1/2 inch in stock
155 @ 1 1/2 inch in stock
(8-1/2 inch)
Total = 49.2 inch

1-12-54
J.M.K.

SMITH'S DOCK CO. LTD
SOUTHBANK ON TEES
ENGLAND



© 2010
Lloyd's Register
Foundation

2

Midship Section

Smiths Dock. Co.

N^{os} 906-7.

Reference.

JOHANNA. W. VINKE EX.

Nebula ex Vestfold 1 *

906. "CHR. CASTBERG"

MARTHE. W. VINKE EX.

Nimbus ex Vestfold 2

907. "NORRONA"

N.H. Ballena

000244-000259-0025

Exhibitor

Col. Coatsworth



© 2020

Lloyd's Register
Foundation