
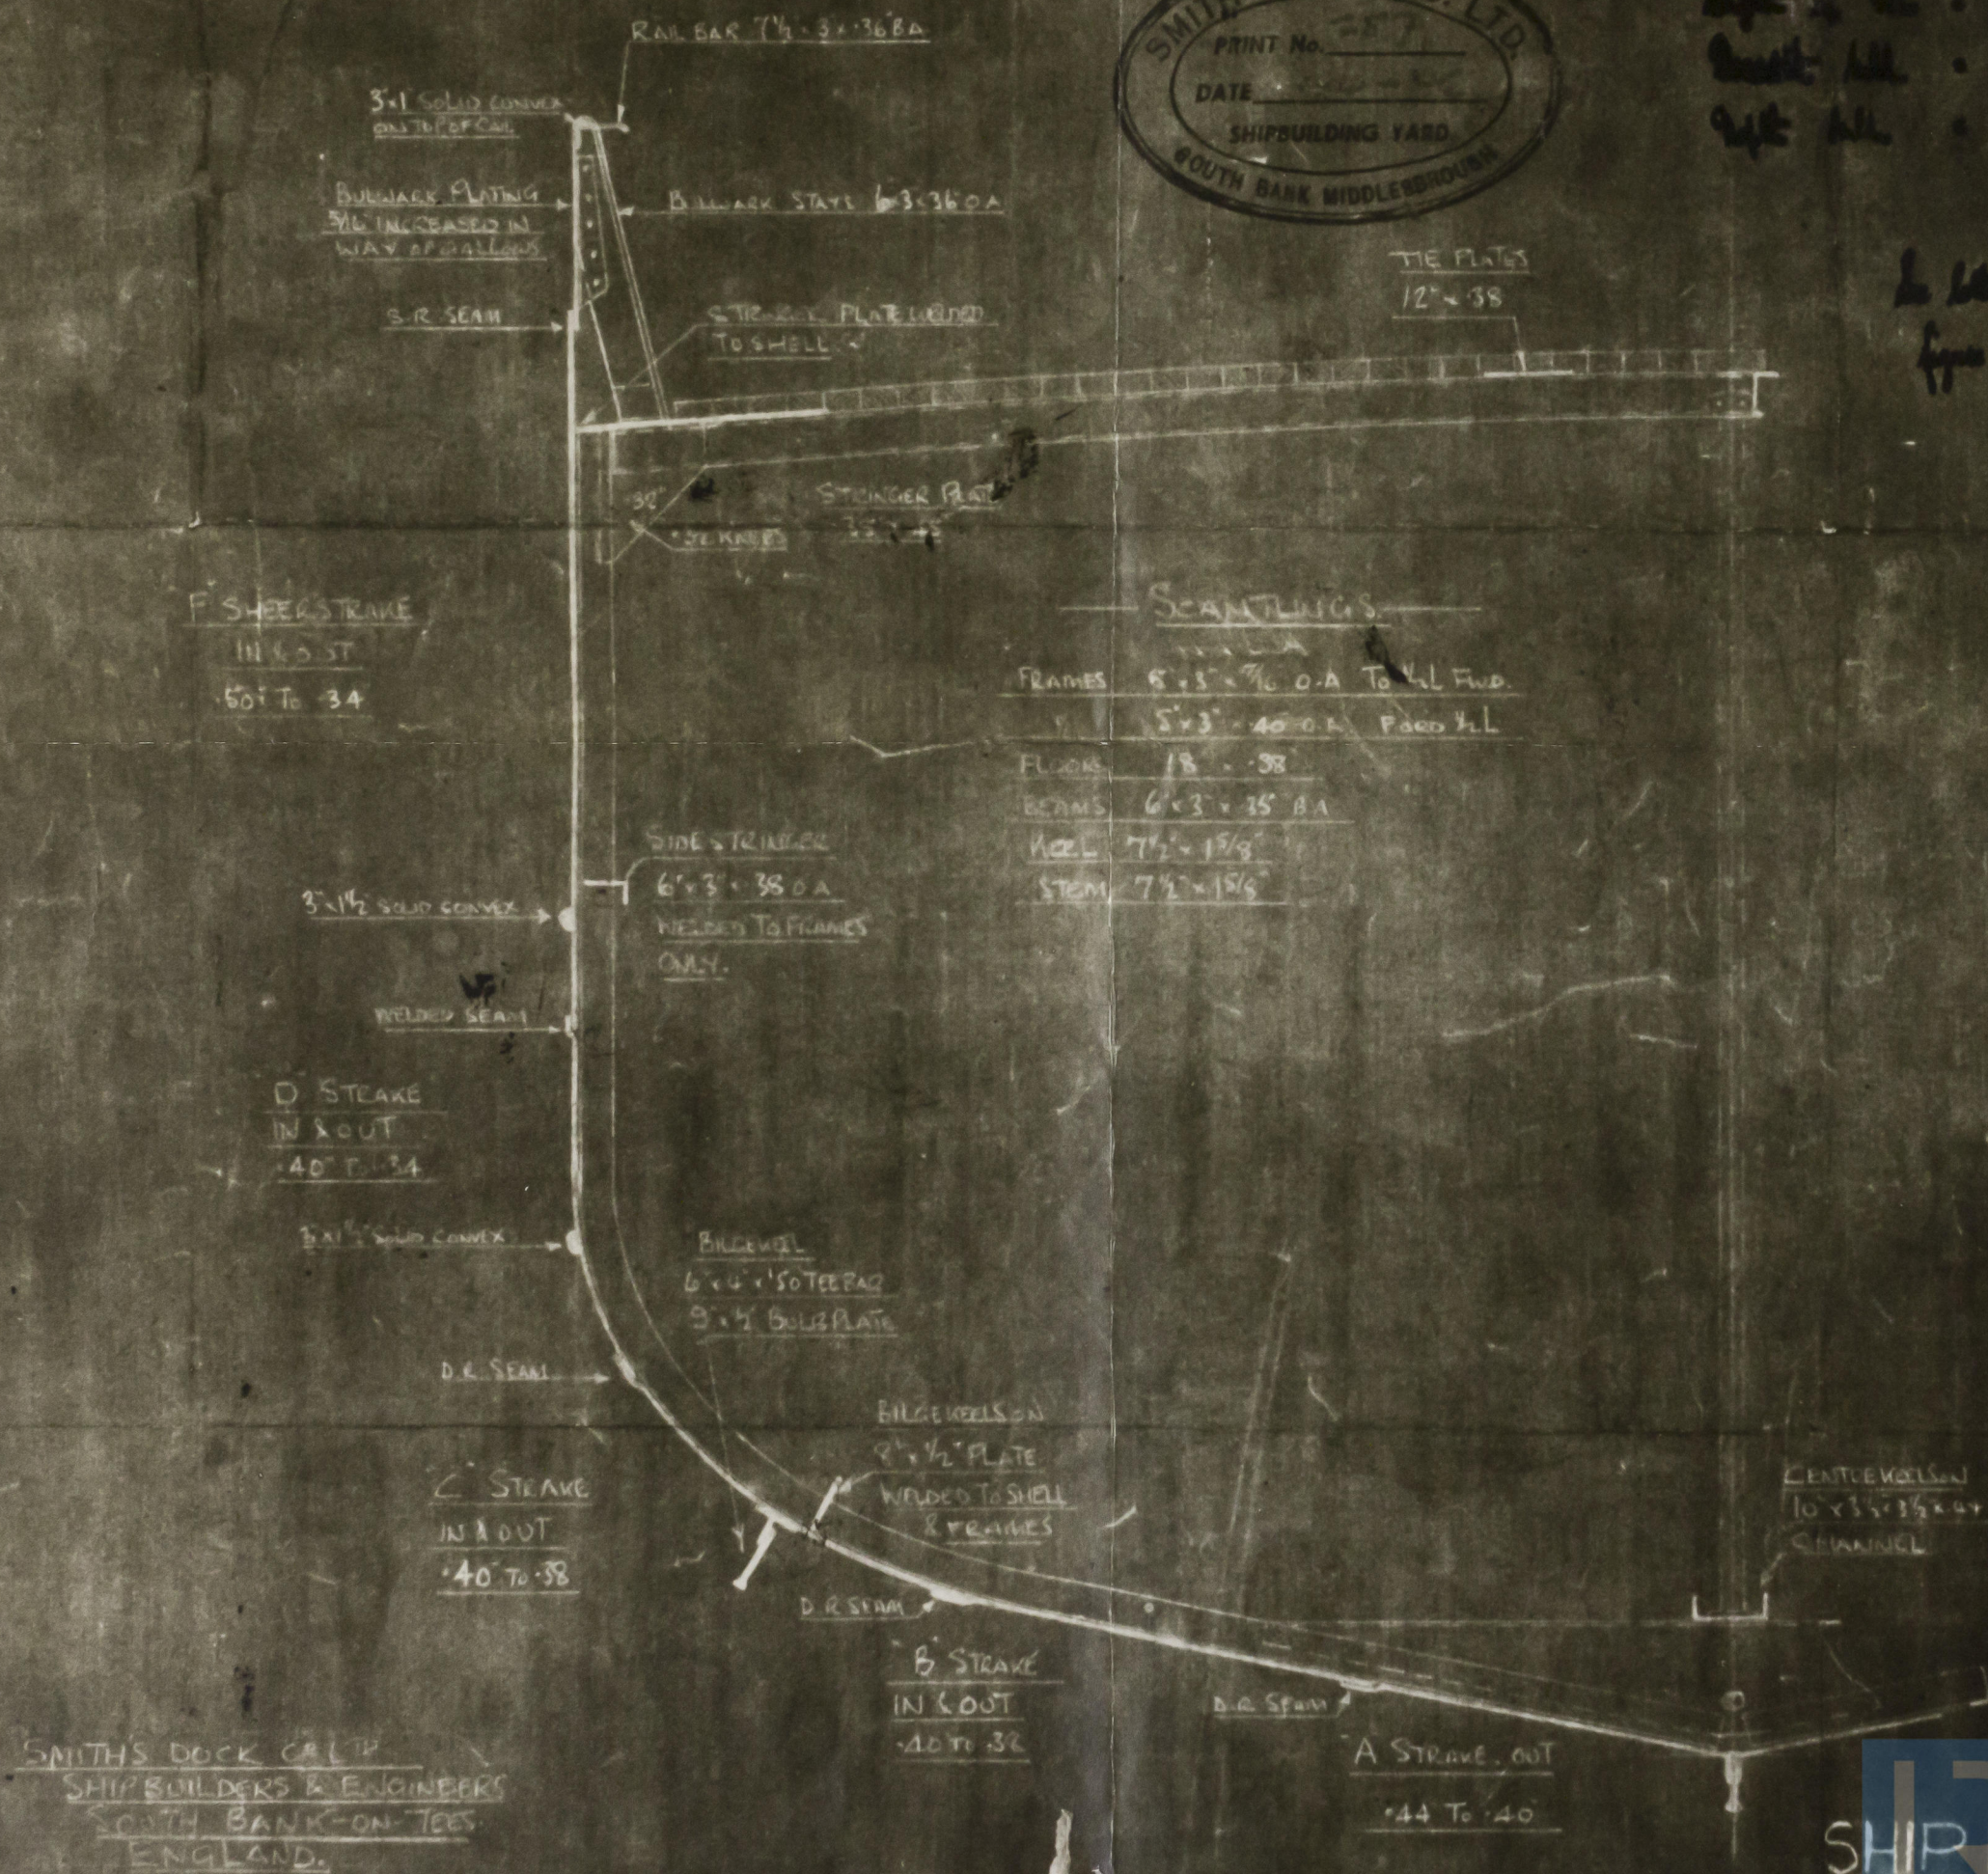


MIDSHIP SECTION


TO CLASS 100. A

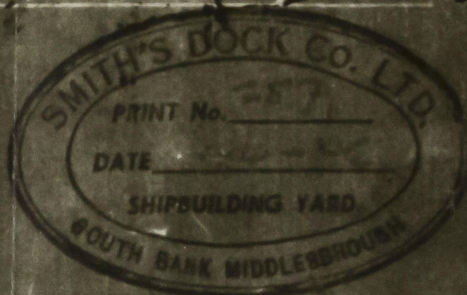


SMITH'S DOCK CALTIP  
SHIP BUILDERS & ENGINEERS  
SOUTH BANK-ON-TEES.  
ENGLAND.

© 2020  
SHIP N° 987-8  
Lloyd's Register  
Foundation

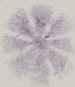

S/R.  
Kingston Sapphire 

MIDSHIP SECTION

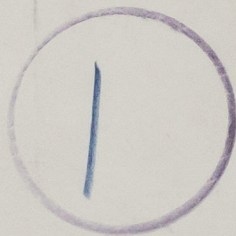

© 2020

Lloyd's Register  
Foundation

002260 - 002268 - 0151