

PROFILE & DECK PLAN.



S.S. No 74

LENGTH B.P. 200'0" BREADTH MLD 30'6" DEPTH MLD 14'9"

SCALE 1/8" = 1 FOOT.



APPROX. PARTICULARS FOR FREEBOARD.
 REGISTERED DIMENSIONS 200'0" x 30'7" x 12'6"
 UNDER DECK TONNAGE APPROX. 595 TONS
 SHEER AT STEM 6'3" 1/8 L. FROM STEM 3'6" 1/2
 SHEER AT STERN 3'6" 1/8 L. FROM STERN 1'11" 1/2
 BRIDGE COMPLETELY CLOSED FORECASTLE OPEN

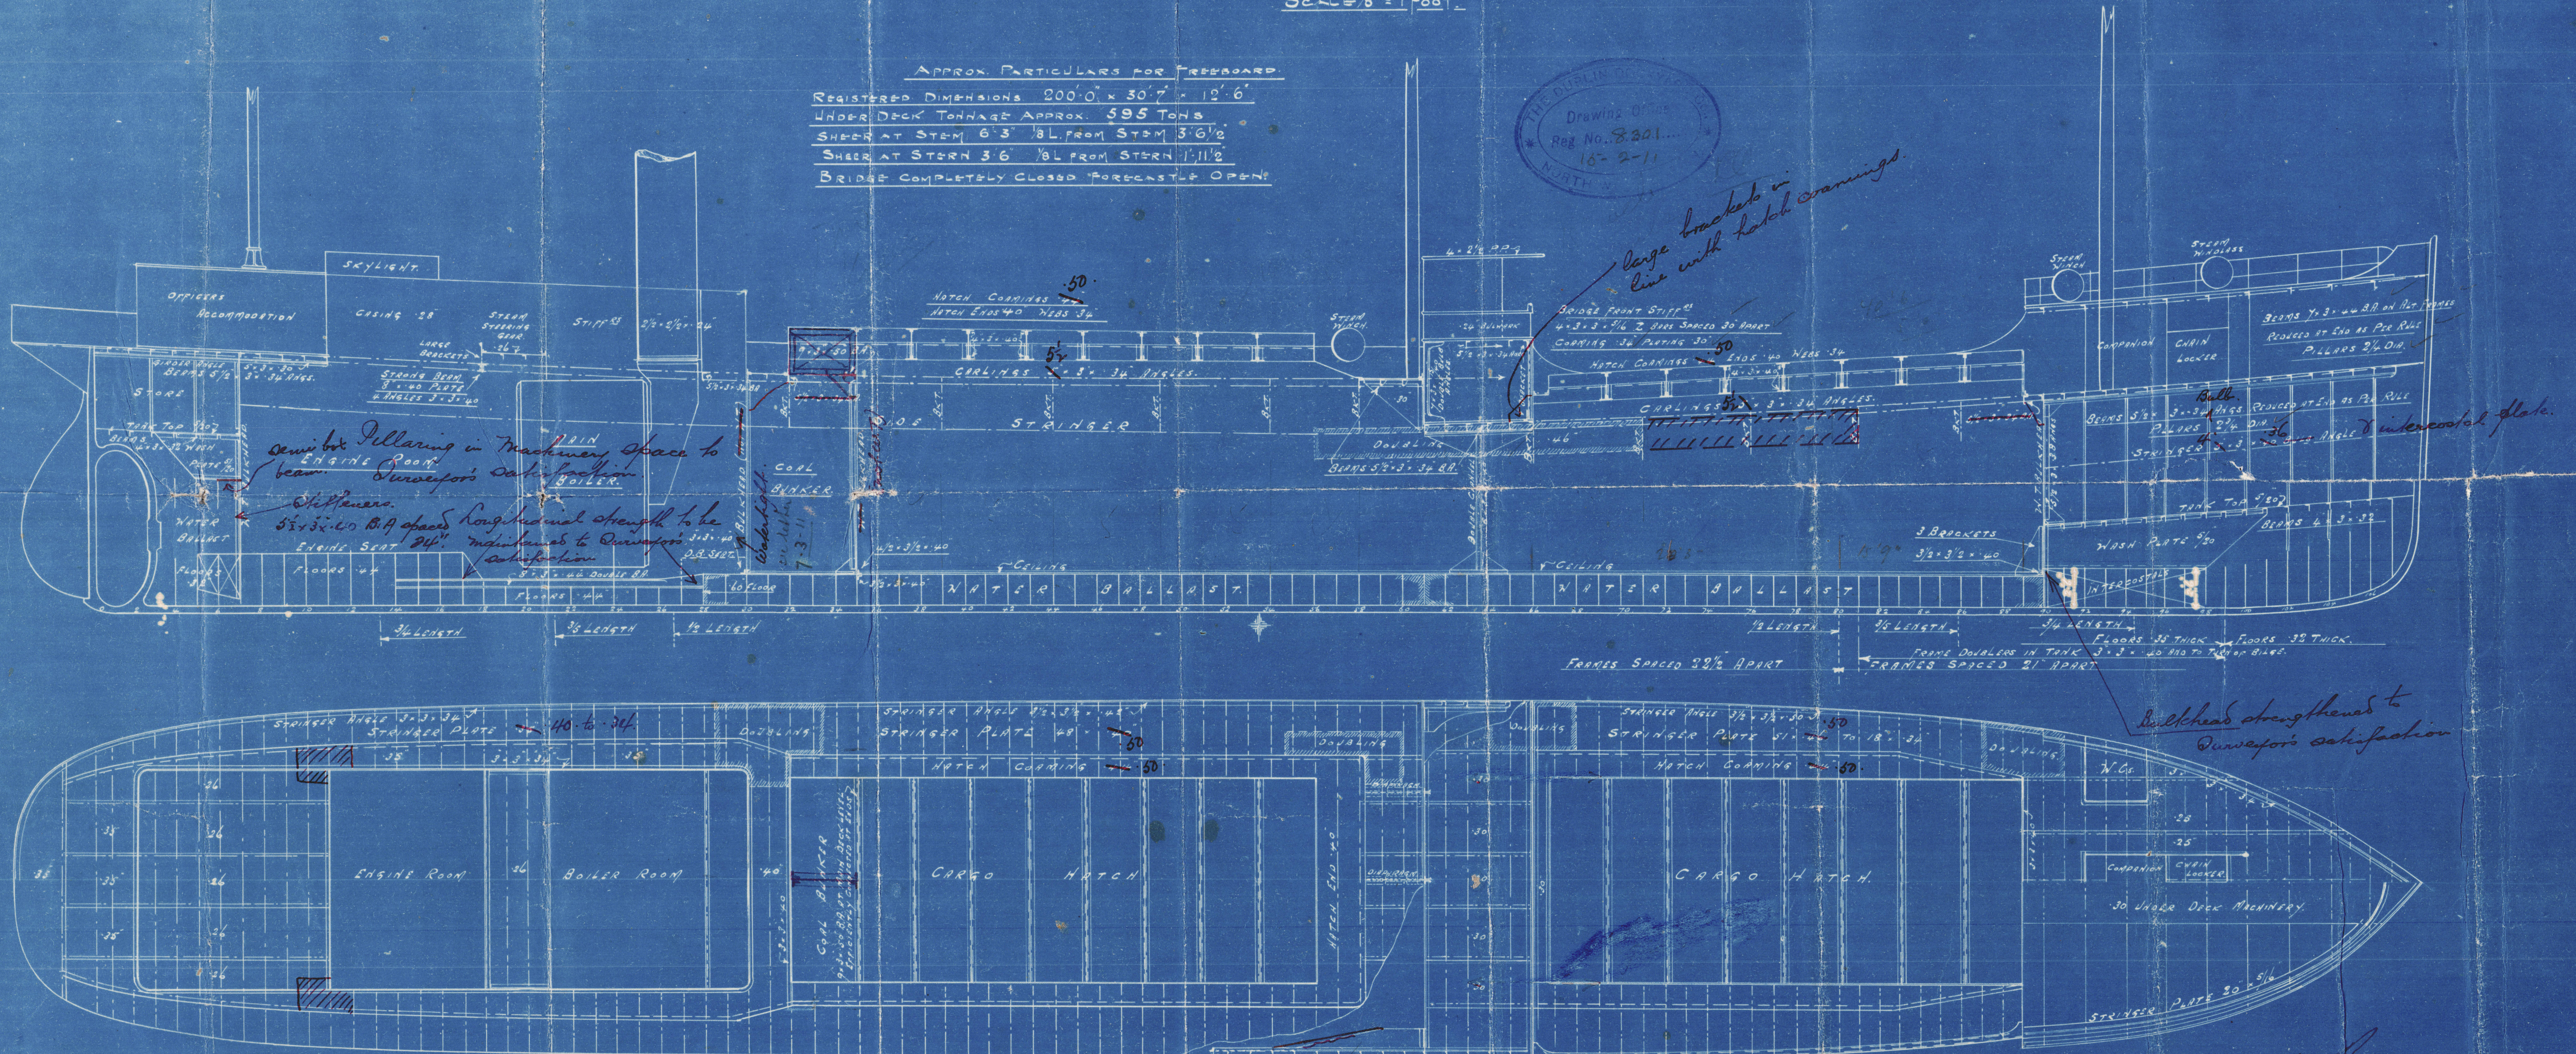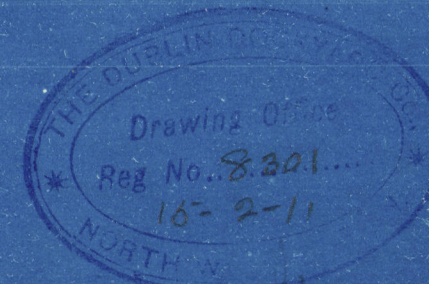

C.B.
 18.2.11.
 7.3.11



002278-0001










Anglesey Coal

Profile & Deck.

S.S. 74.

Kyleclare

St. Enda
Dub 5103

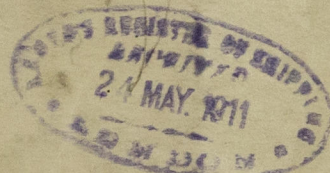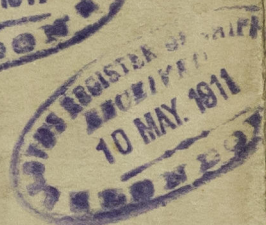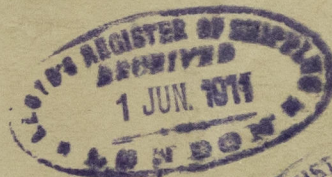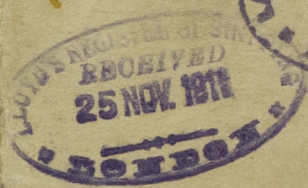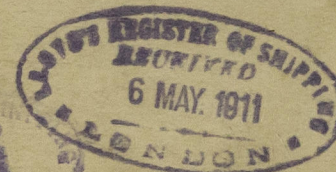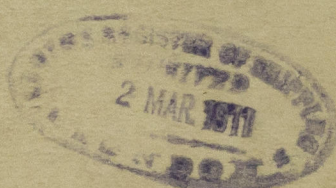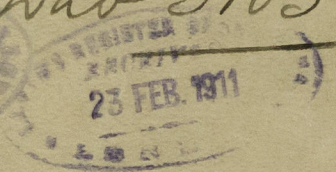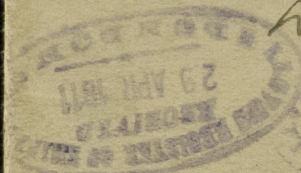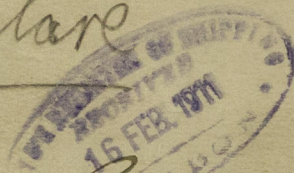

© 2021

Lloyd's Register
Foundation

002269-1-002278-0001